
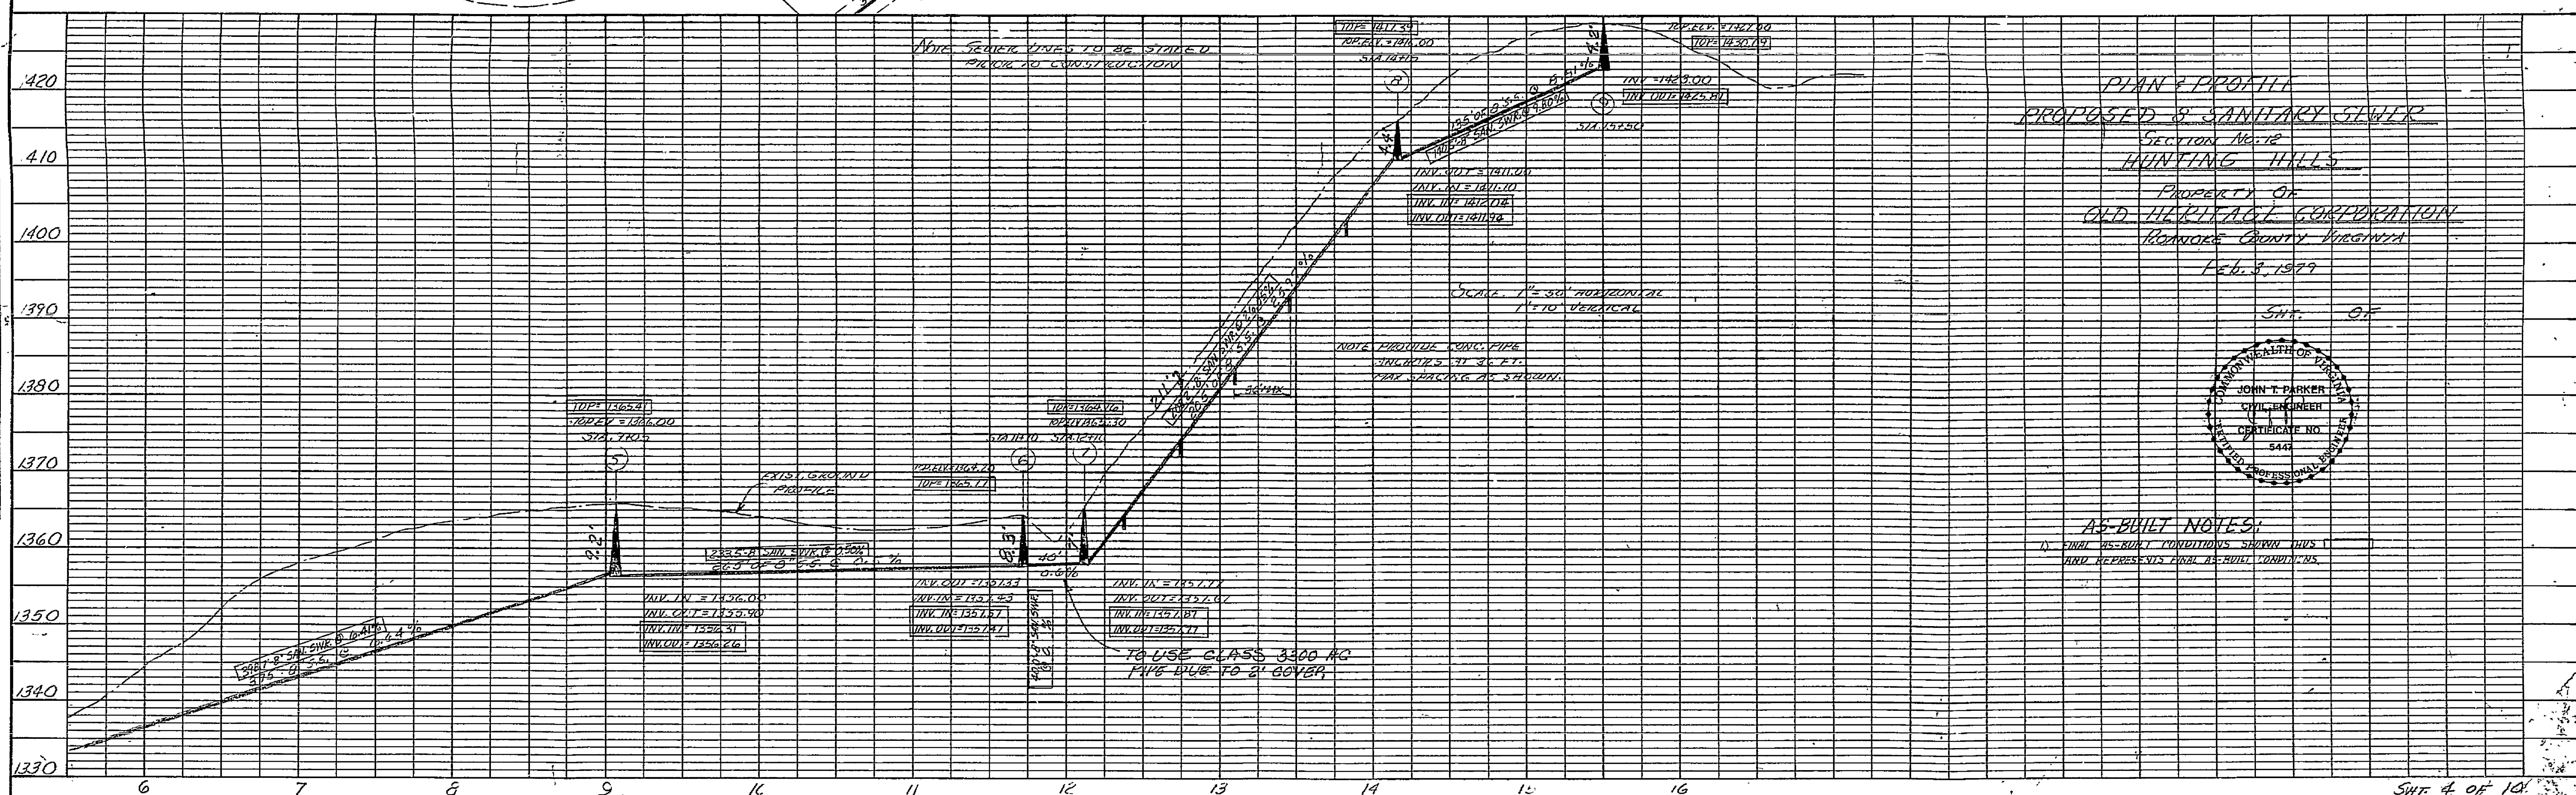


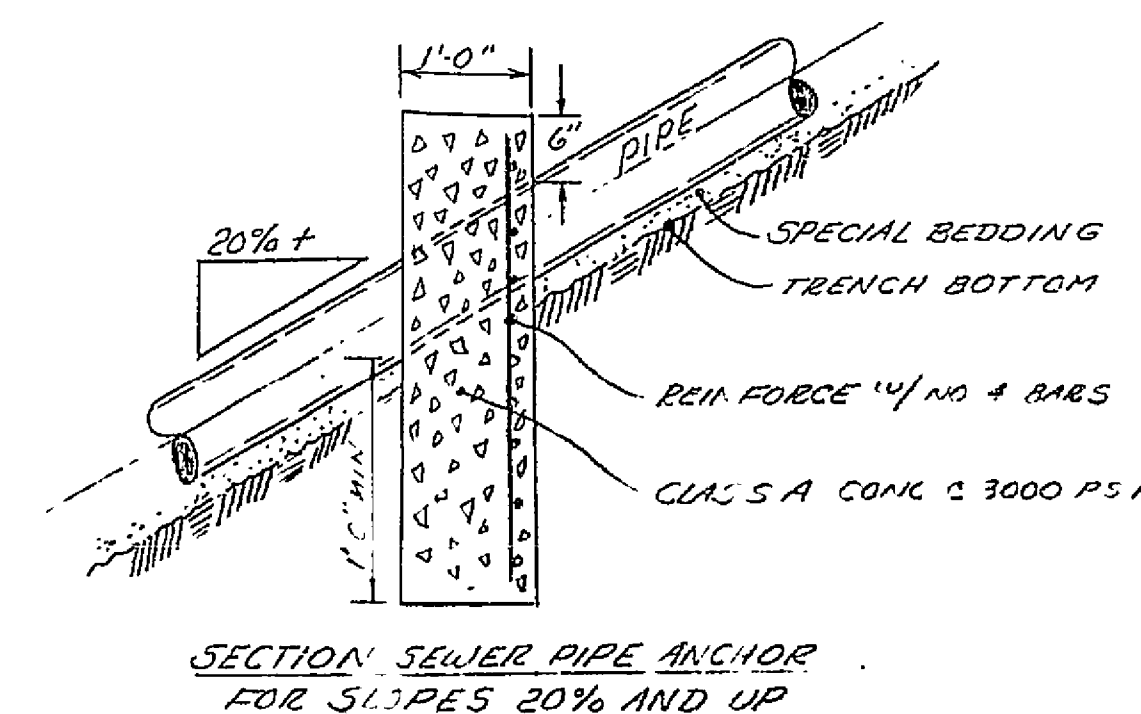

PLAN & PROFILE
PROPOSED S. SANITARY SEWER
Section No. 12
MOUNTAIN HILLS
Property of
OLD HILLTAC CORPORATION
Kannock County Wisconsin
Feb. 8 1979

AS-BUILT NOTES:
FINAL AS-BUILT CONDITIONS SHOWN THUS
AND REPRESENTS FINAL AS-BUILT CONDITIONS

SHT. 4 OF 10

RC-2041

