
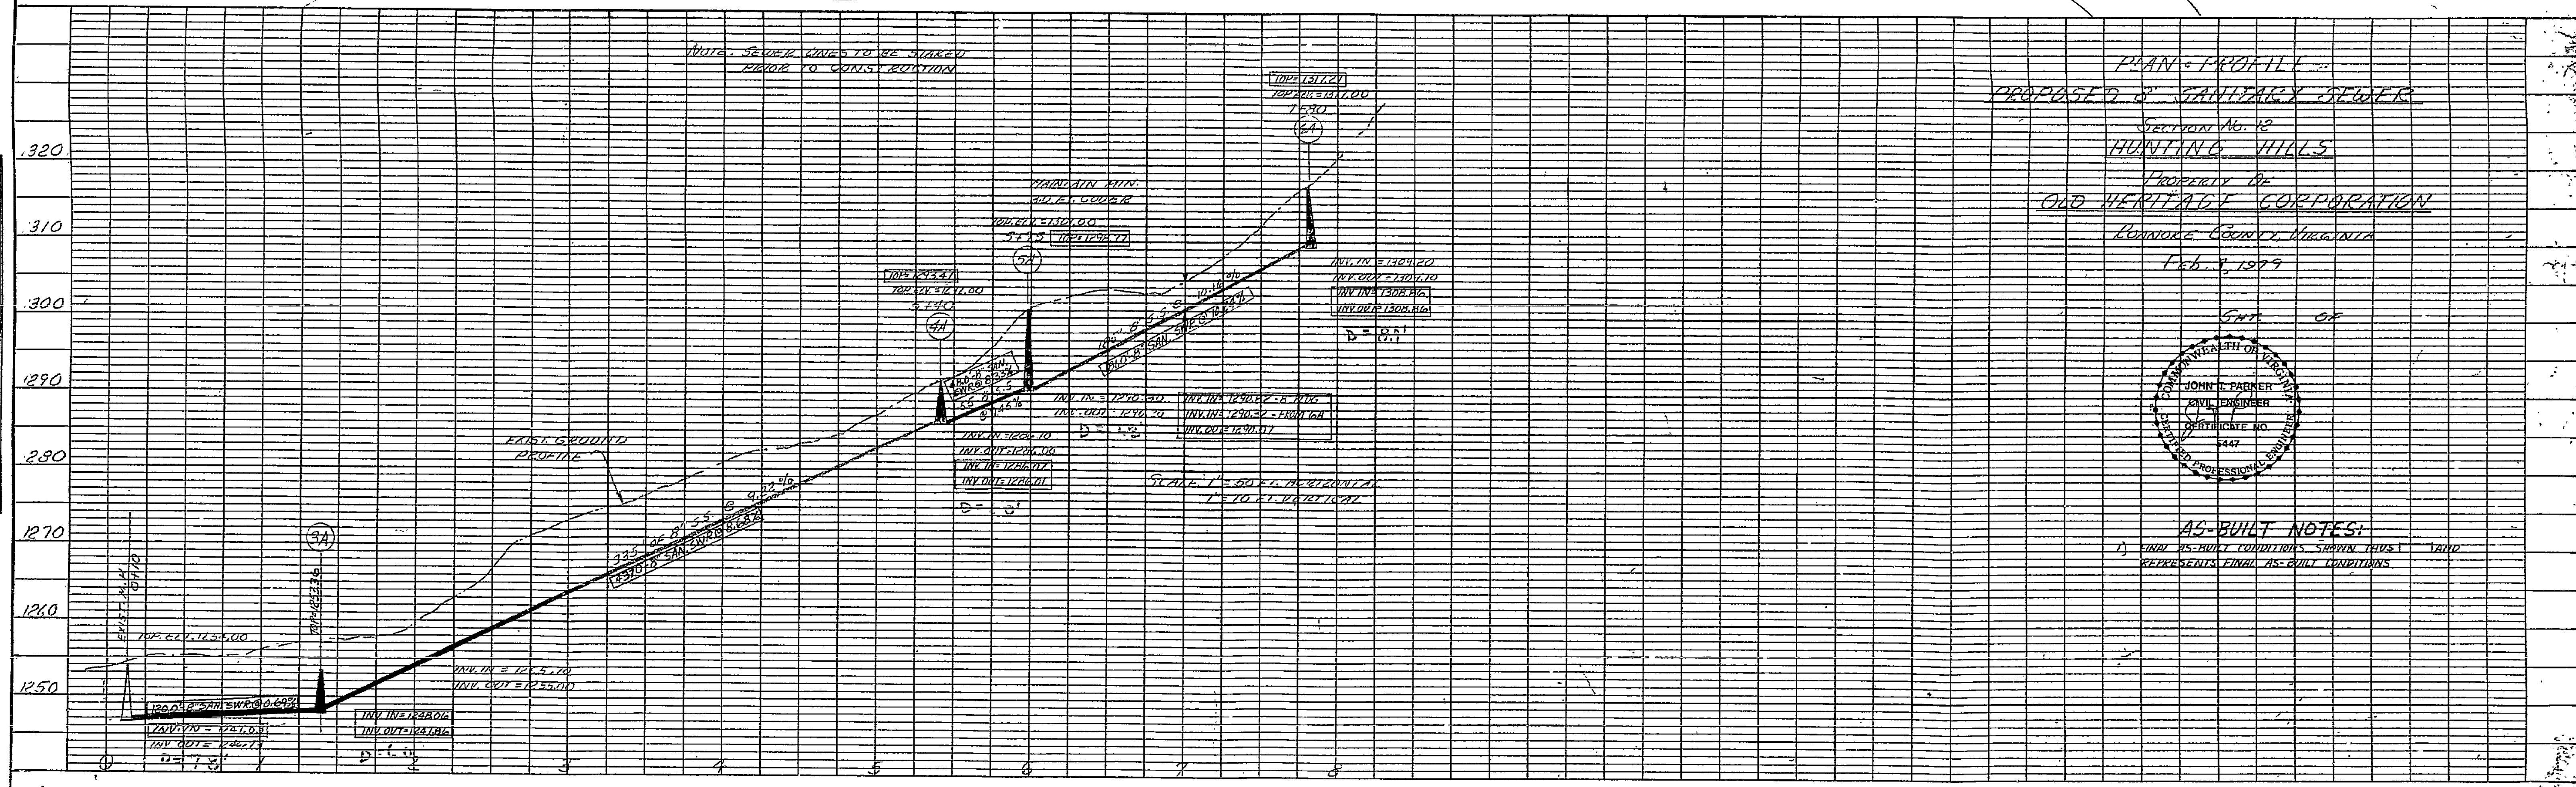


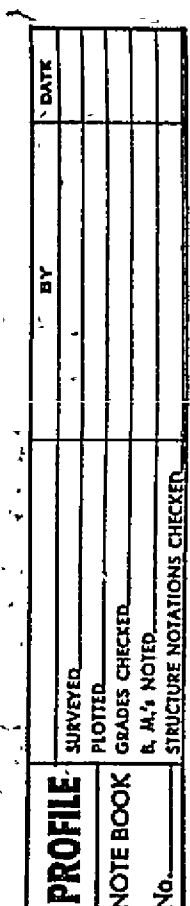

5447

COMMONWEALTH OF VIRGINIA

JOHN L. PARKER
CIVIL ENGINEER

CERTIFICATE NO. 5447

LICENSED PROFESSIONAL ENGINEER

AS-BUILT NOTES:

1) FINAL AS-BUILT CONDITIONS SHOWN THUS REPRESENTS FINAL AS-BUILT CONDITIONS

547-5 OF 10

RC-2042

