




PLAN	DATE	2-25-80
	BY	TIM MITCHELL
	REVIEWED	
	NOTE BOOK	REVISIONS

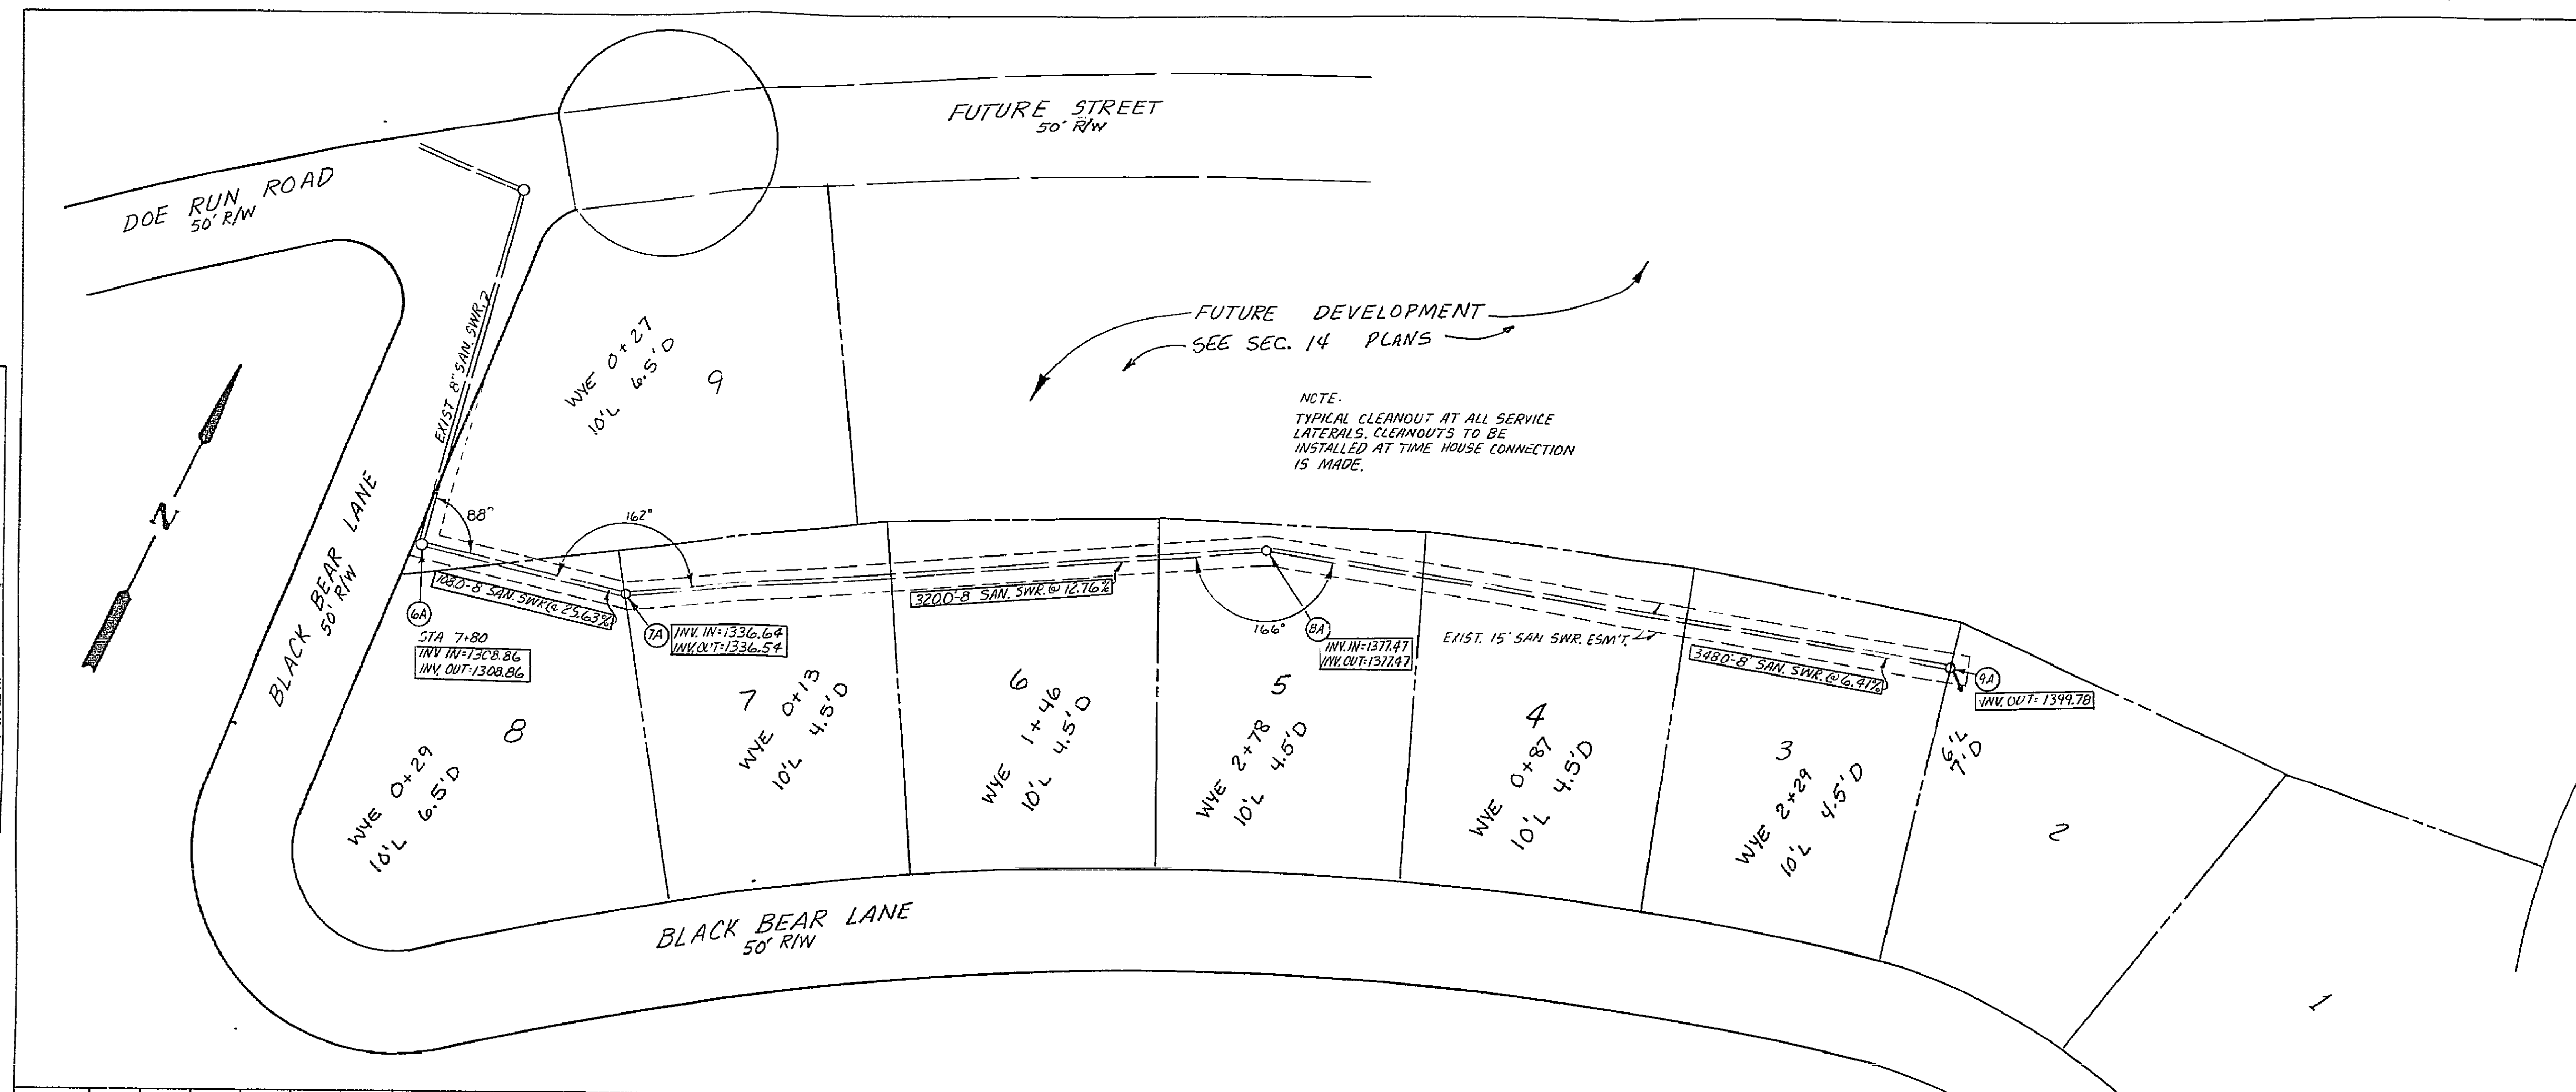

PROFILE	DATE	2-25-80
	BY	TIM MITCHELL
	REVIEWED	
	NOTE BOOK	REVISIONS

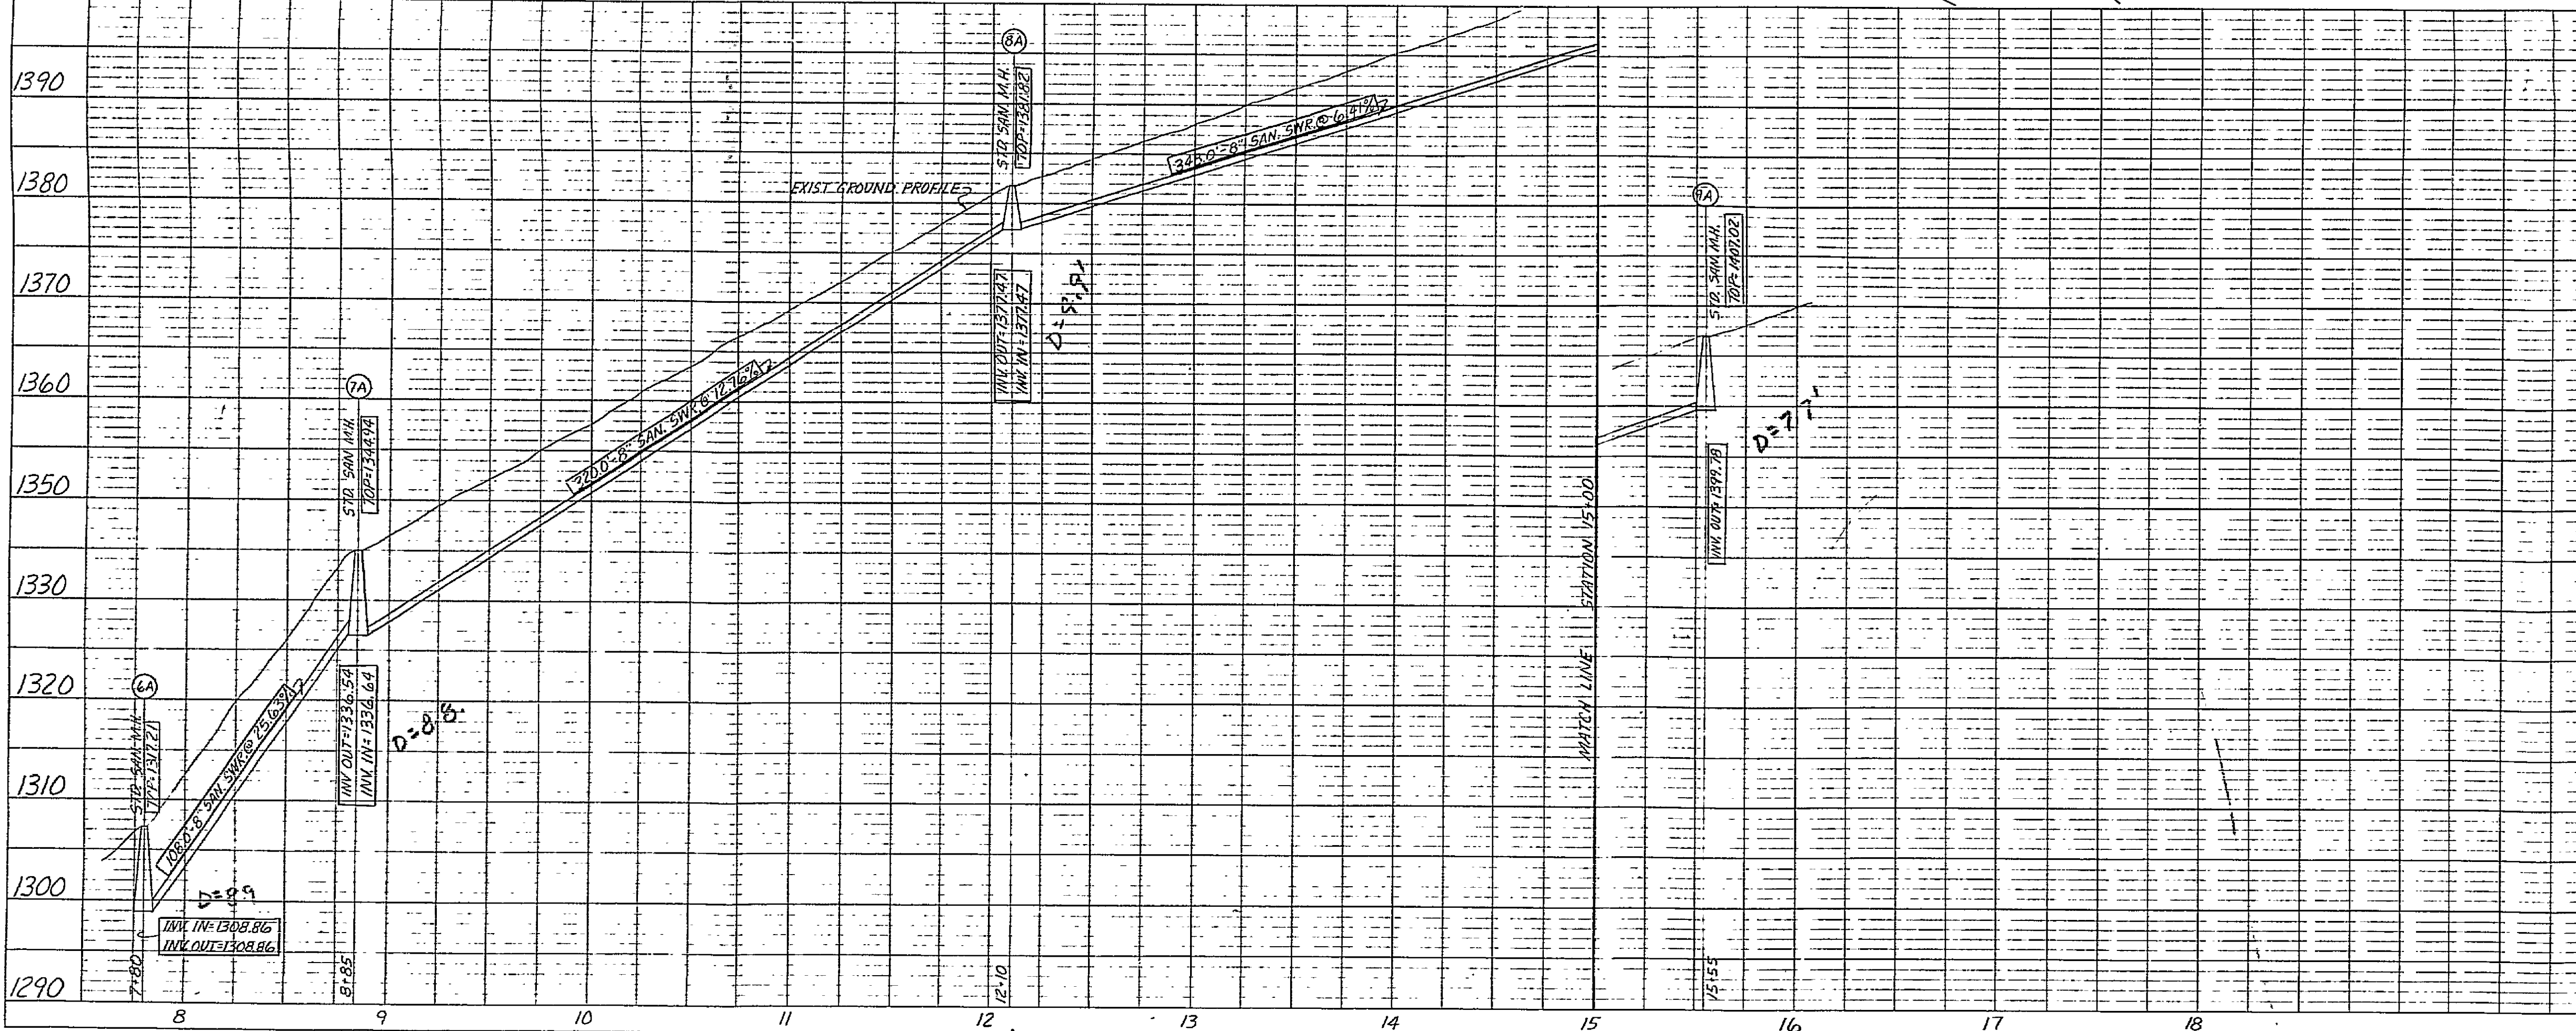

AS-BUILT NOTES:
 1) FINAL AS-BUILT CONDITIONS SHOWN THIS
 AND REPRESENTS FINAL AS-BUILT CONDITIONS.

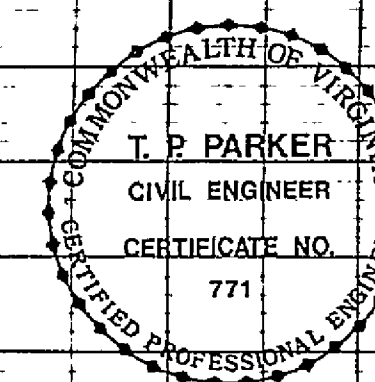

AS-BUILT SANITARY SEWER PROFILES BLACK BEAR LANE	
DESIGNED T. MITCHELL	SECTION 12 HUNTING HILLS ROANOKE COUNTY, VIRGINIA
T. P. PARKER & SON ENGINEERS & SURVEYORS LTD. SALEM, VIRGINIA	SCALE HORIZ. 1"=50' VERT. 1"=10' DATE FEB. 25, 1980
W.O. NO. N.B.	SHEET 6 OF 10

PLATE 1-SINGLE PLAN AND PROFILE-FULL LINE
 PRINTED IN U.S.A.

RC-2043

