
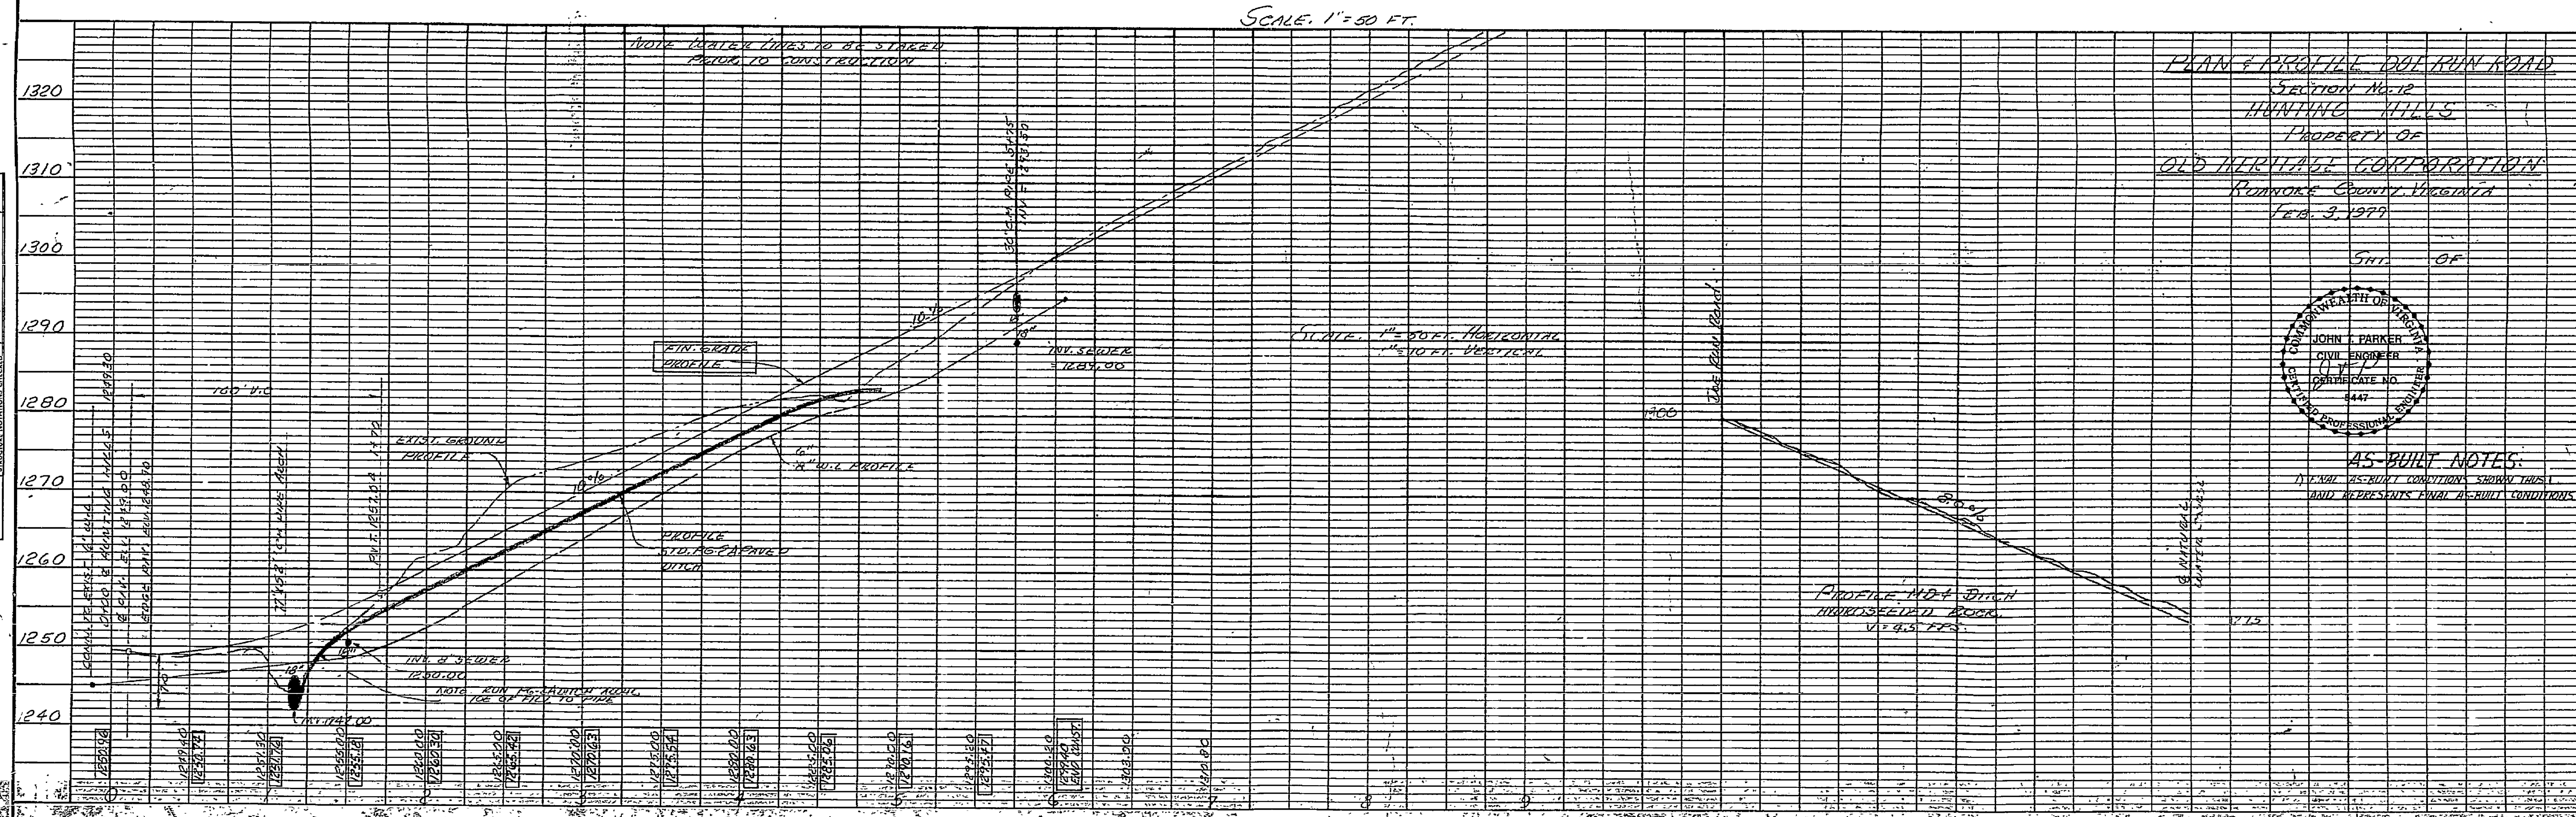


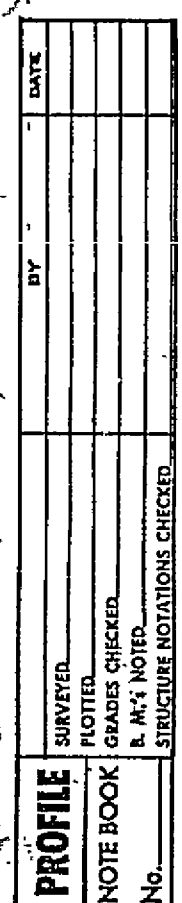

COMMONWEALTH OF VIRGINIA
 JOHN T. PARKER
 CIVIL ENGINEER
 CERTIFICATE NO.
 8447
 REGISTERED PROFESSIONAL ENGINEER

AS-BUILT NOTES:

1) FINAL AS-BUILT CONDITIONS SHOWN THUS
AND REPRESENTS FINAL AS-BUILT CONDITIONS

PLATE 1, PLAN-PROFILE
KOUFTEL & ESSER CO

RC-2044

