

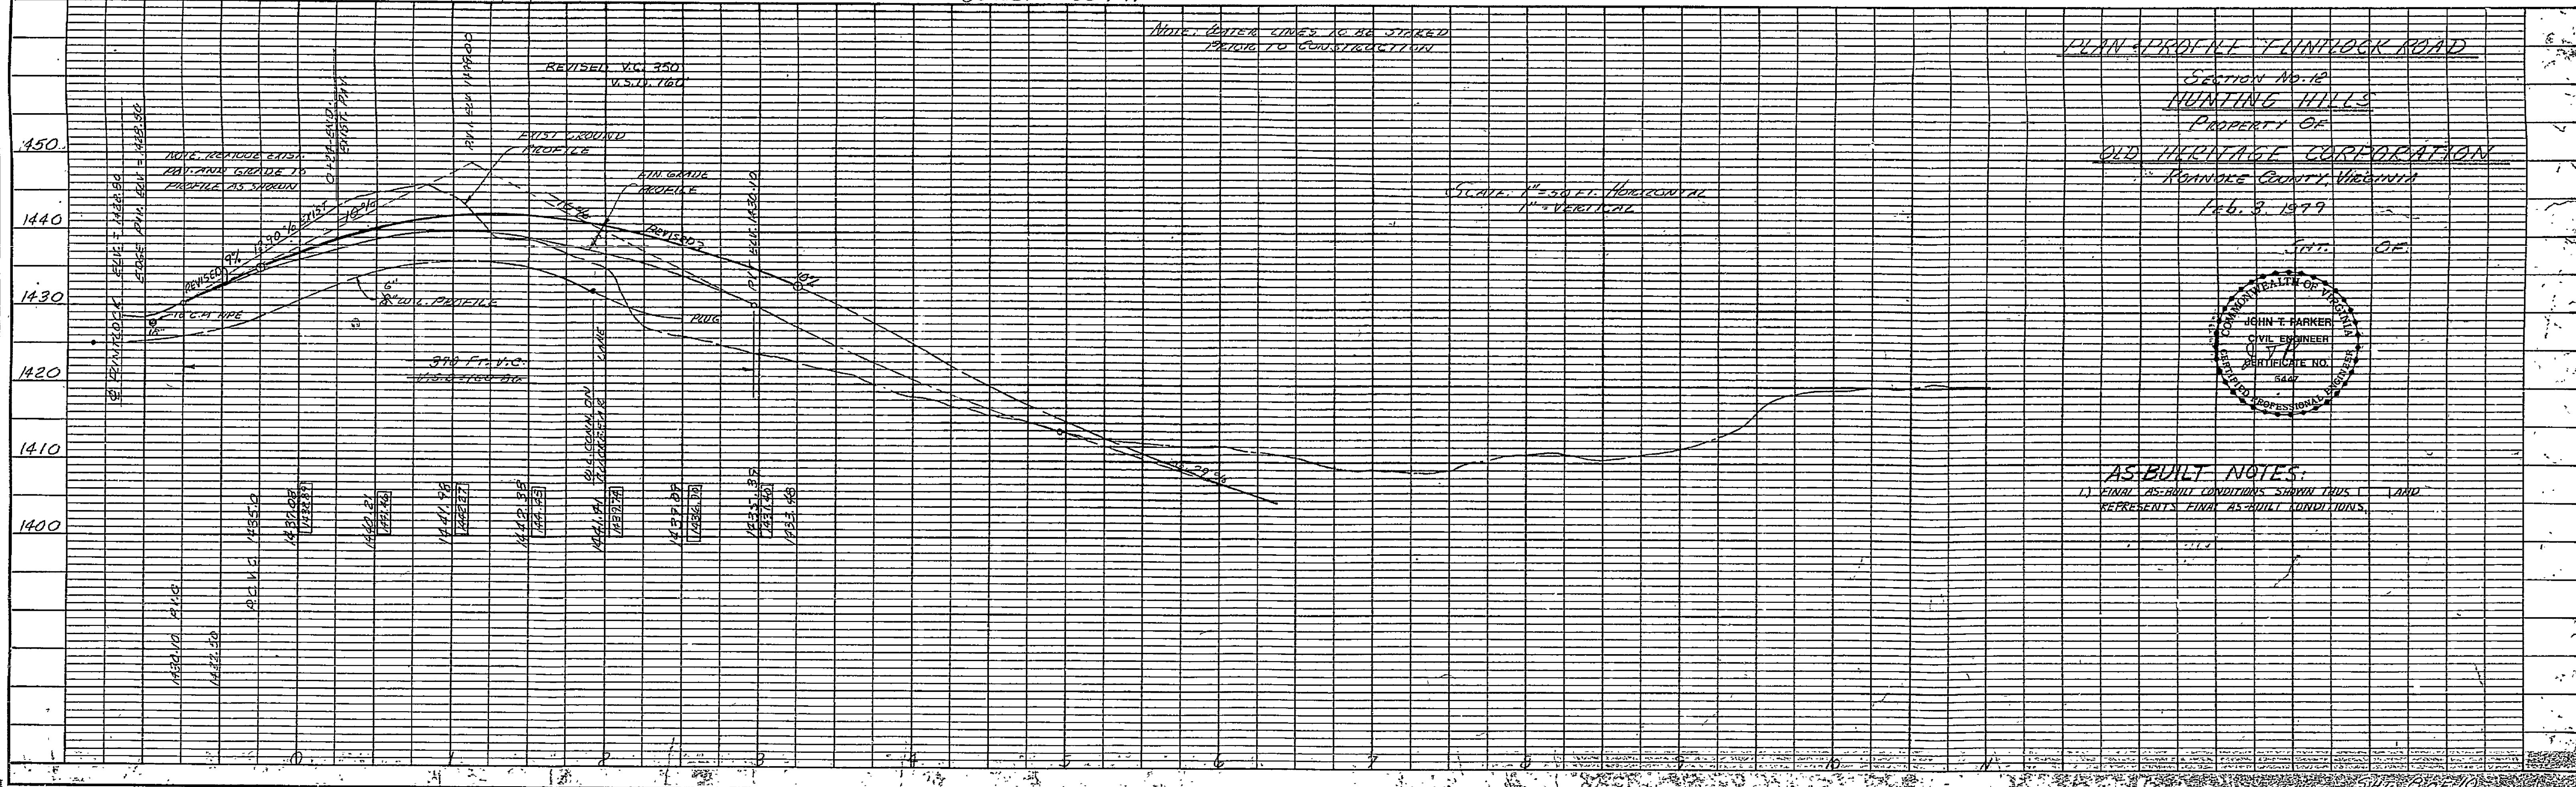


PLAN	DATE	BY
	NOTE BOOK	
No.	REVISIONS	
	REVISIONS	

PROFILE	DATE	BY
	NOTE BOOK	
No.	REVISIONS	
	REVISIONS	

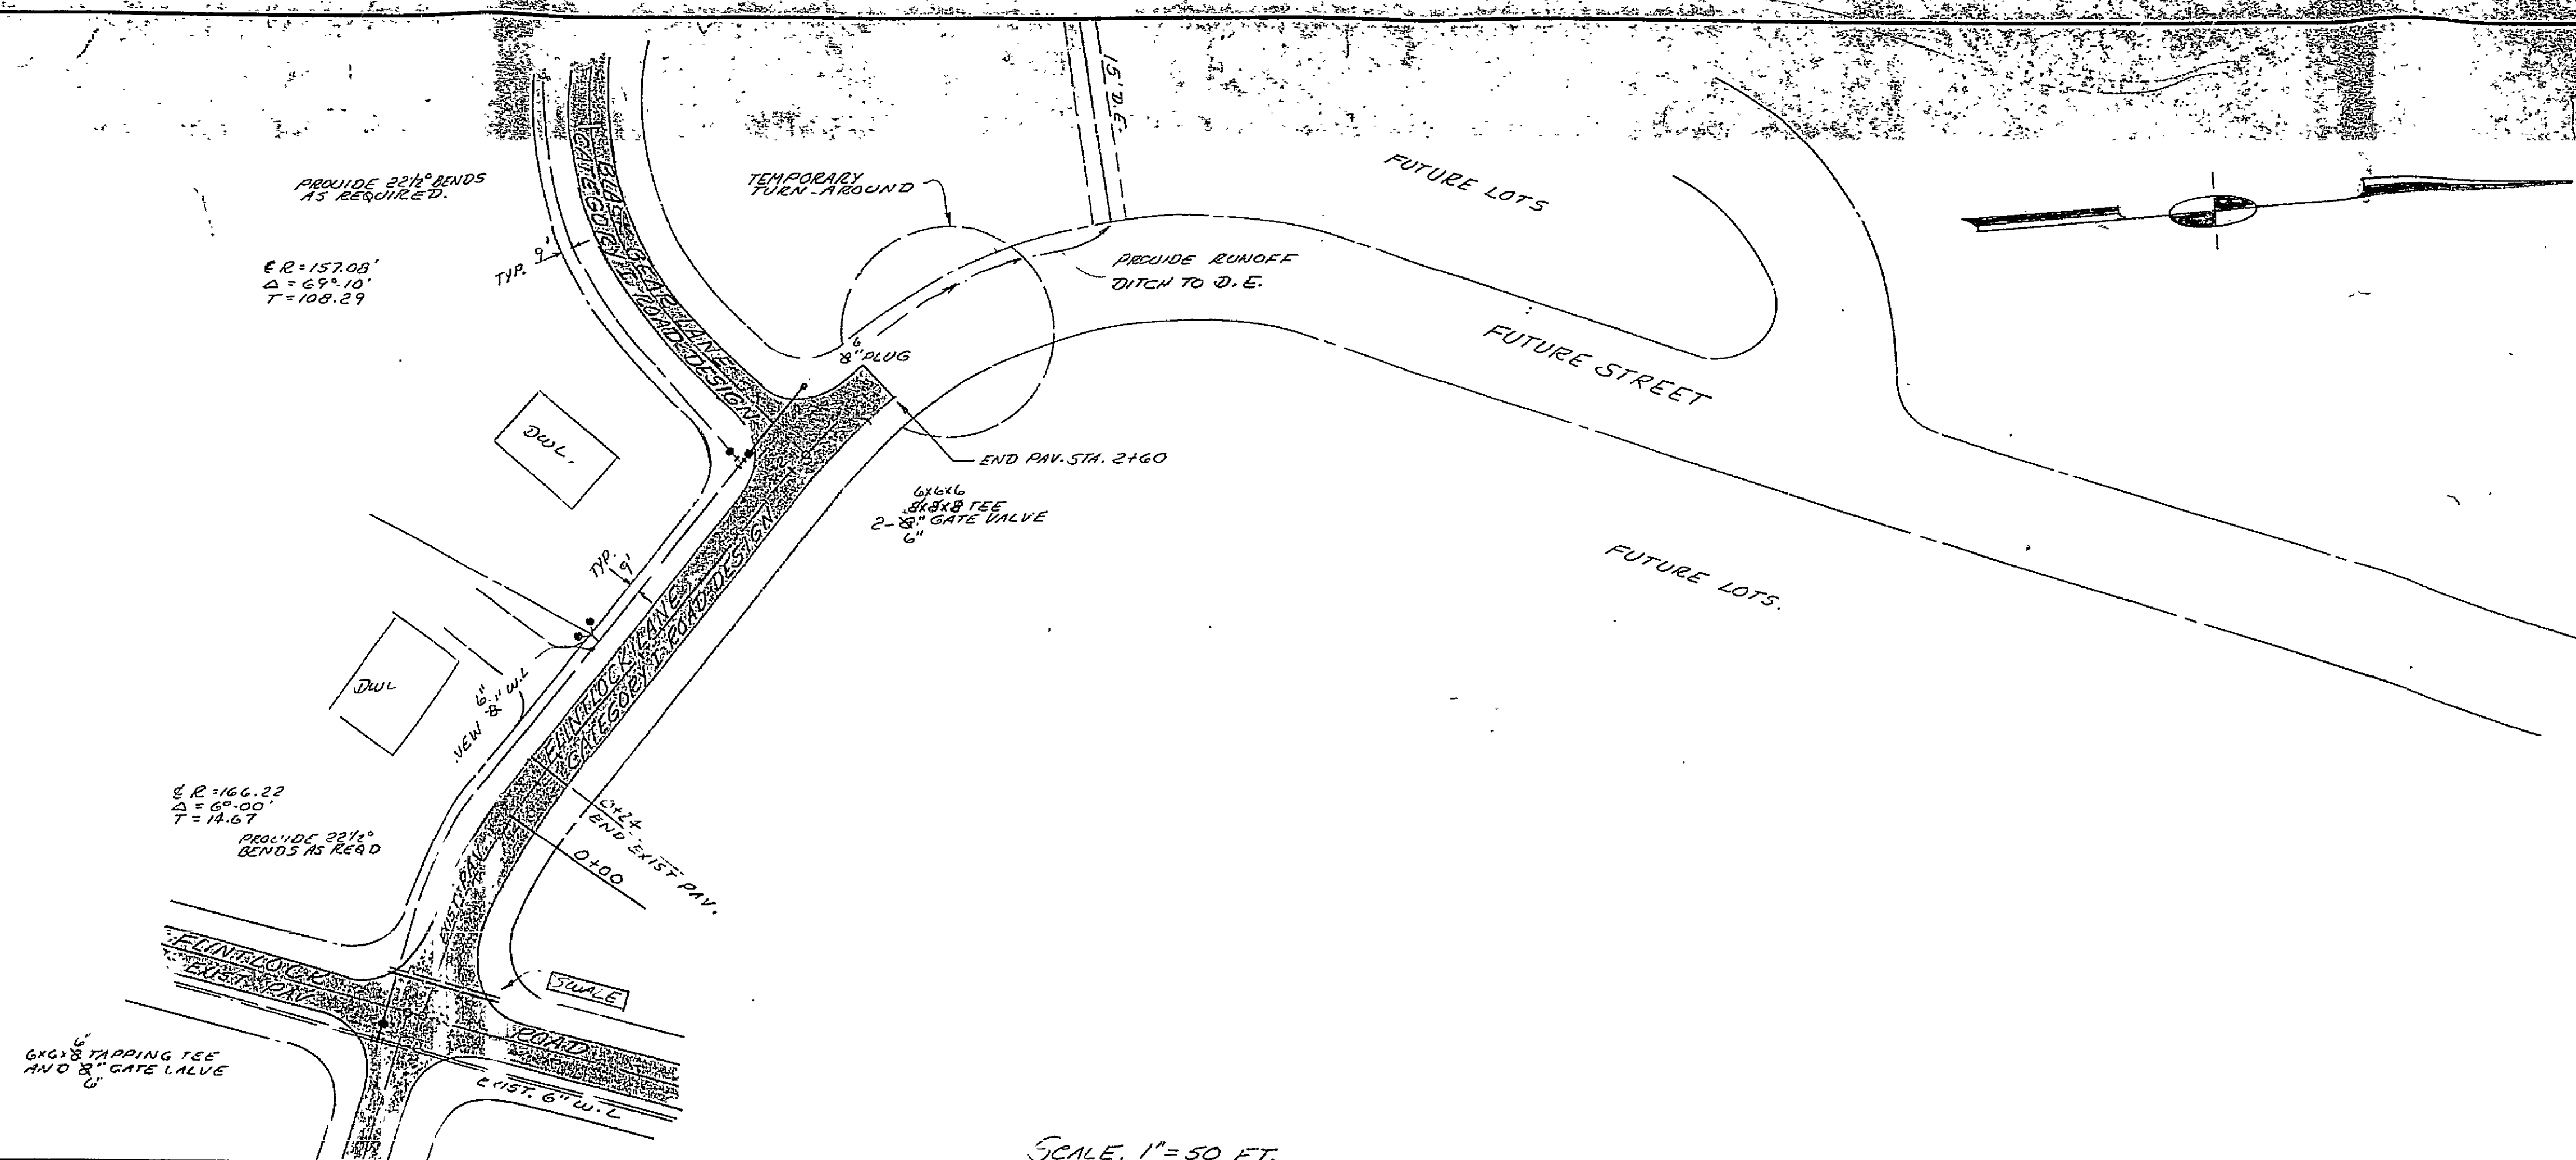


PLAN & PROFILE YANTLOCK ROAD
 SECTION No. 12
 HUNTING HILLS
 PROPERTY OF
 OLD HERITAGE CORPORATION
 HUNTING HILLS, VIRGINIA
 Feb. 3, 1977
 SINT. OF

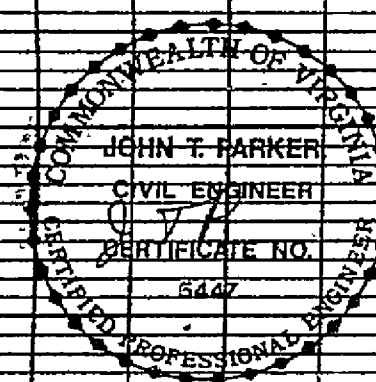

AS-BUILT NOTES:
 1. FINAL AS-BUILT CONDITIONS SHOWN THIS PLAN AND PROFILE REPRESENTS FINAL AS-BUILT CONDITIONS.

K-E PLATE 1, PLAN-PROFILE
 K-E ENGINEERING CO.

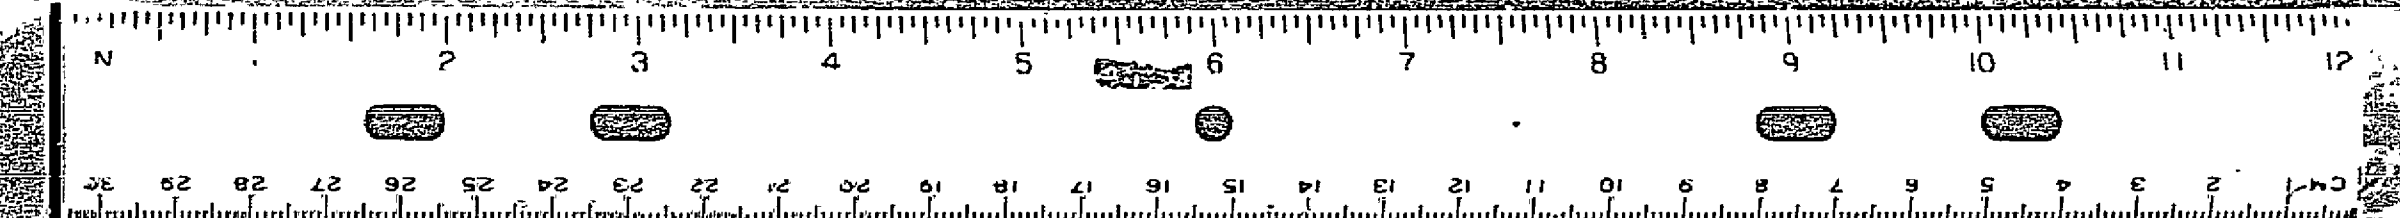

Re-2045