



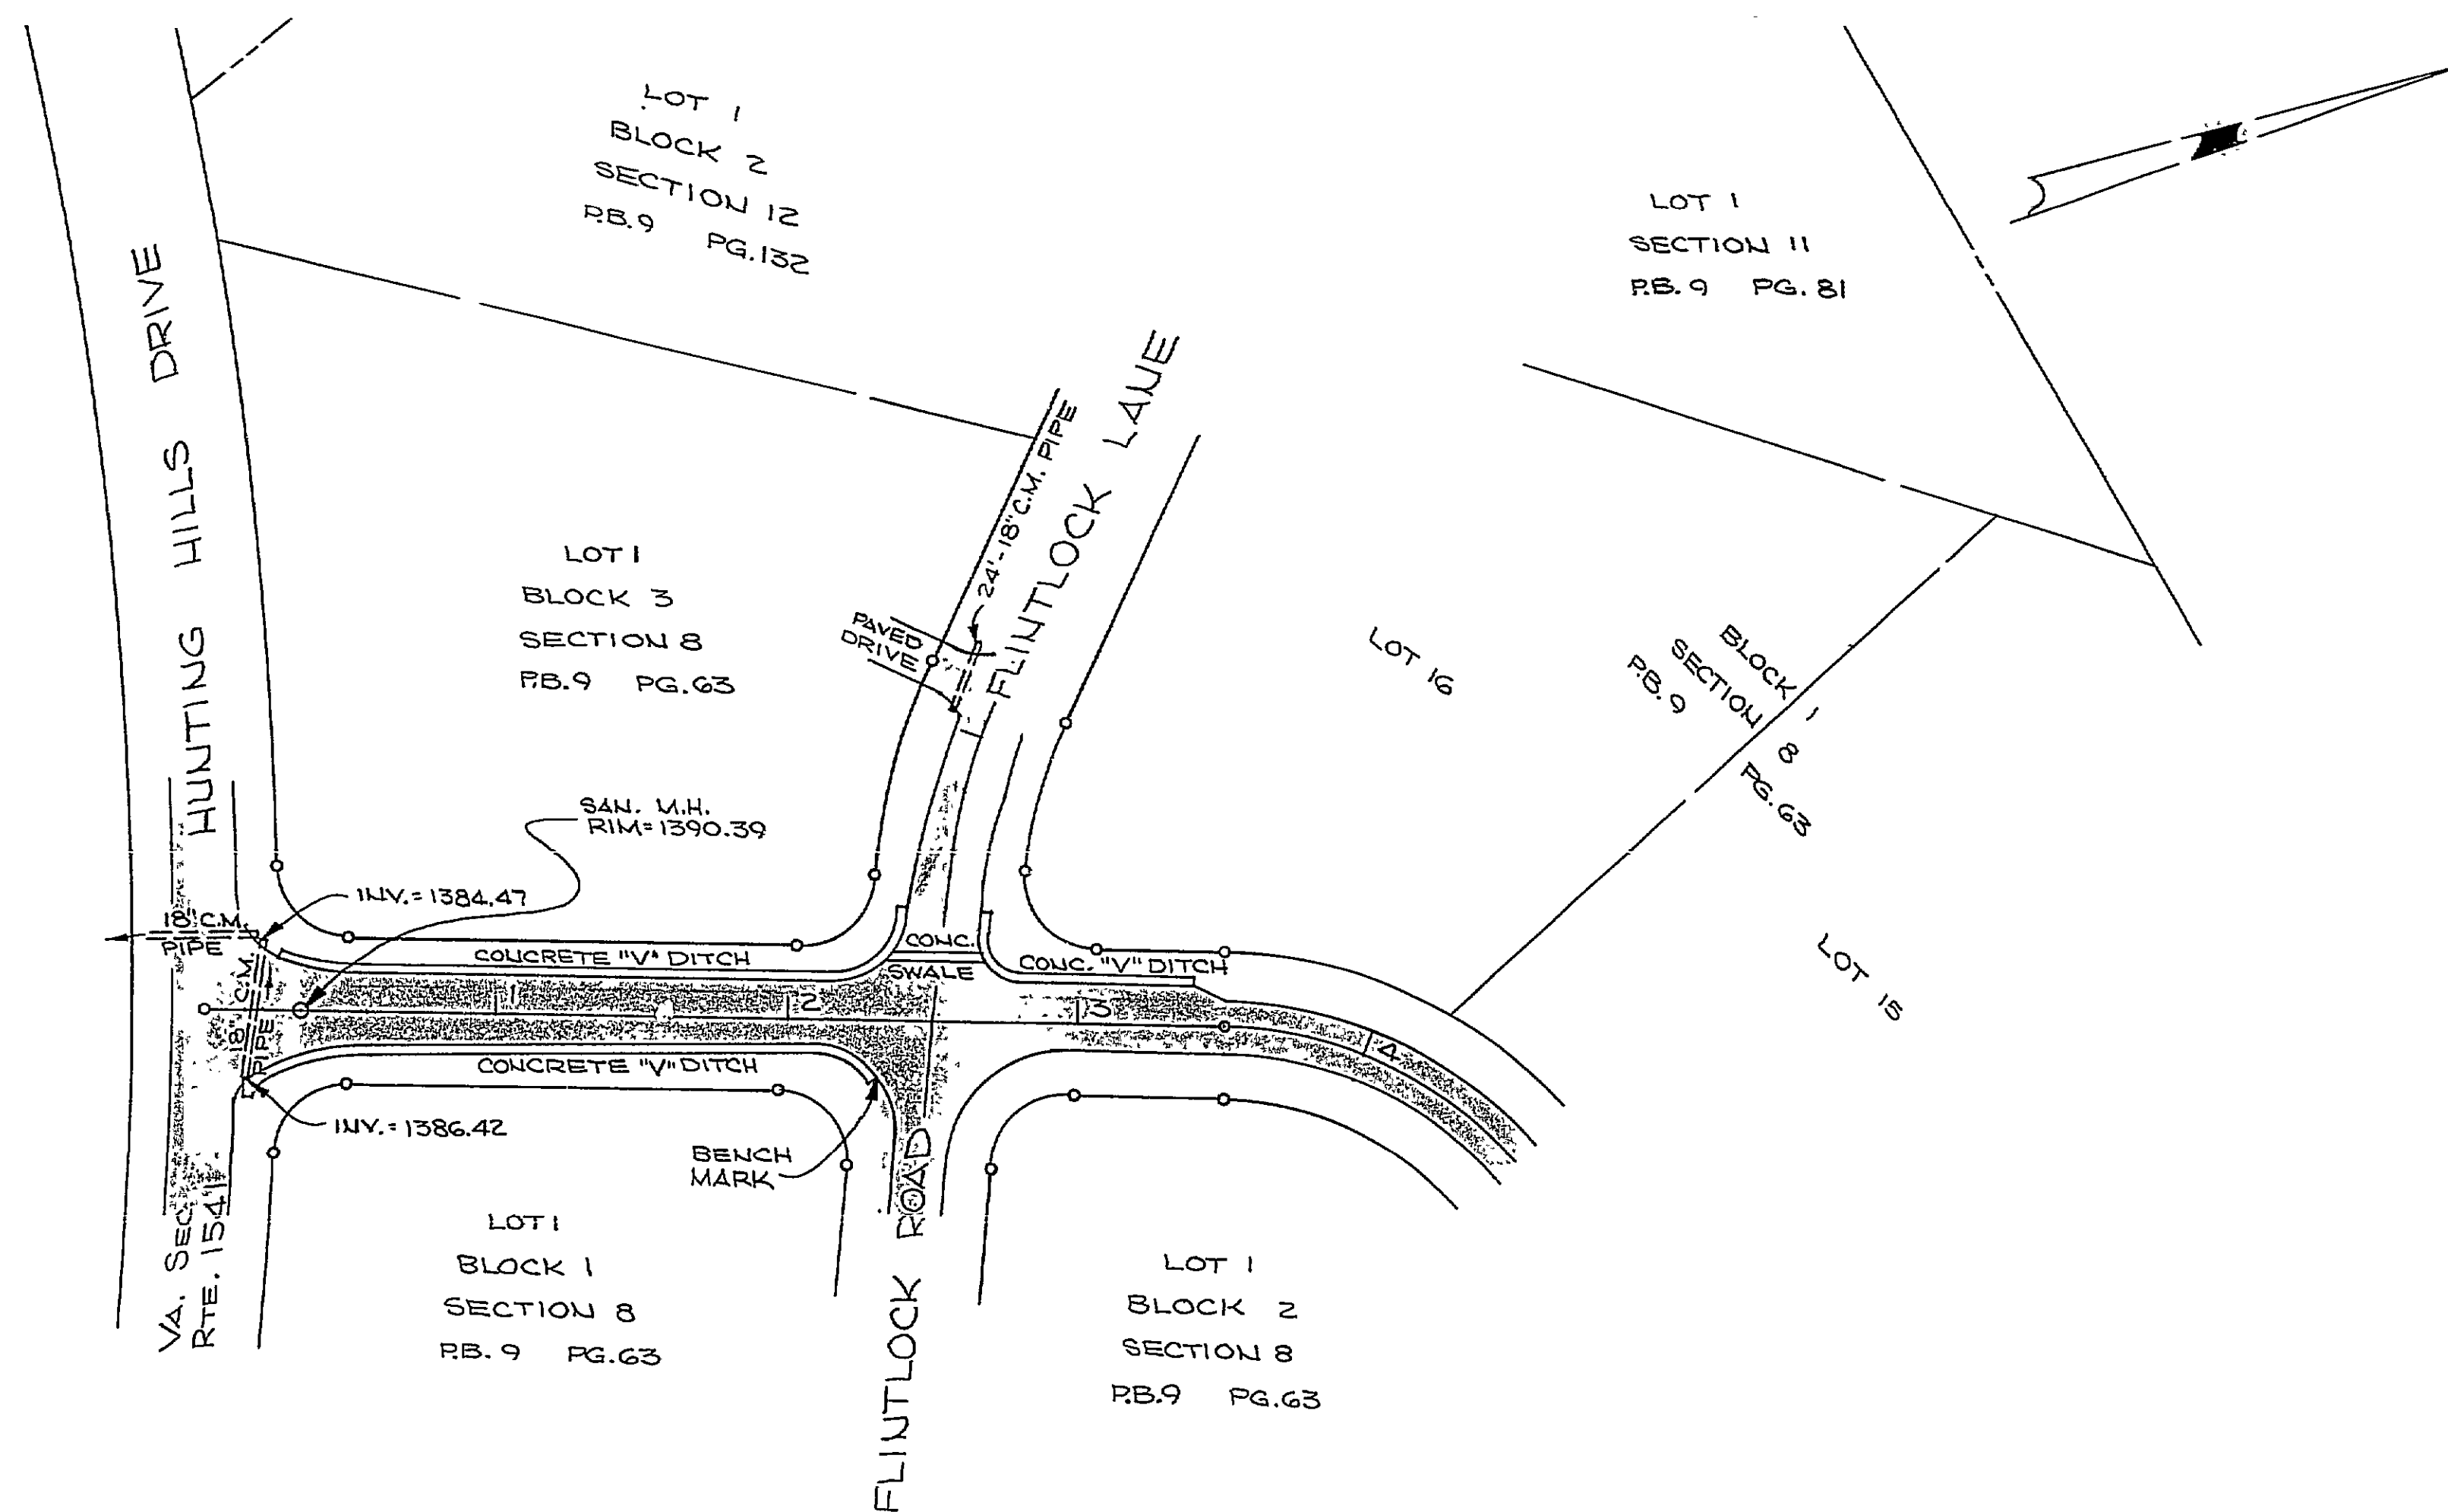

BENCH MARK
END OF CONC. "V" DITCH
20' RT. STA. 2+31.
ELEV. = 1425.30

SCALE : 1" = 50' HORIZONTAL
1" = 10' VERTICAL

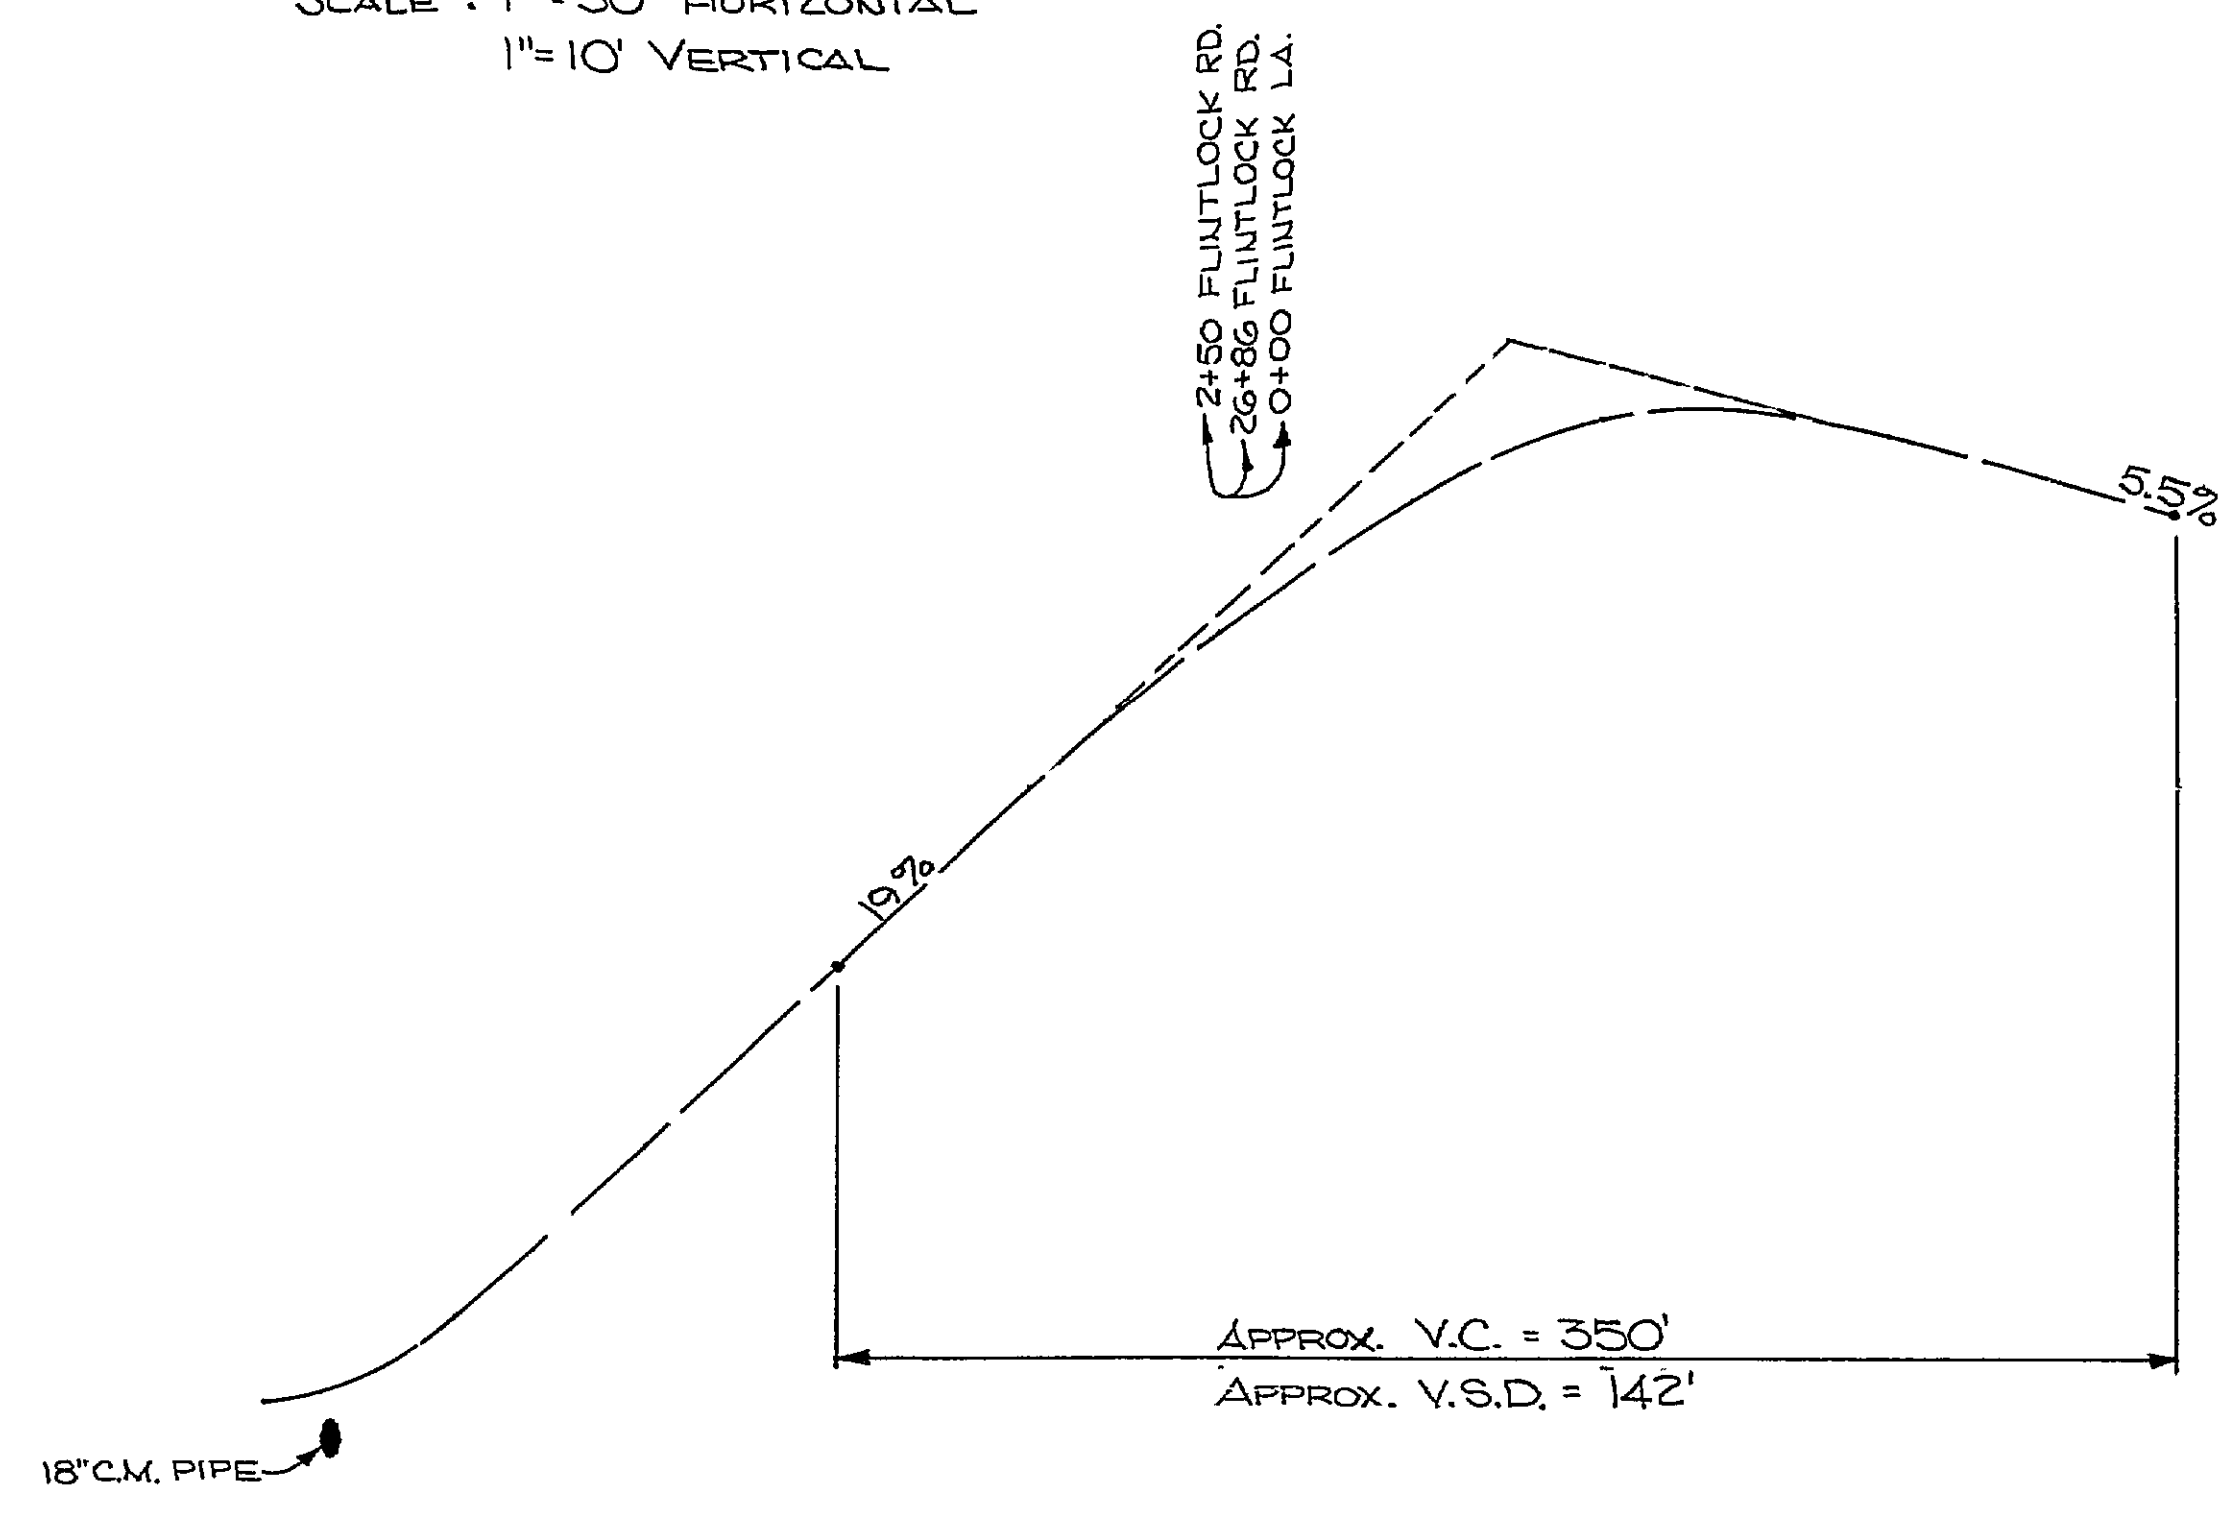

As Built
PLAN & PROFILE - FLINTFLOCK ROAD
SECTION 12
HUNTING HILLS
PROPERTY OF
OLD HERITAGE CORPORATION
ROANOKE COUNTY, VIRGINIA
JULY 31, 1980
SHEET 8A OF 10



SHEET 8A OF 10

RC-3164

