

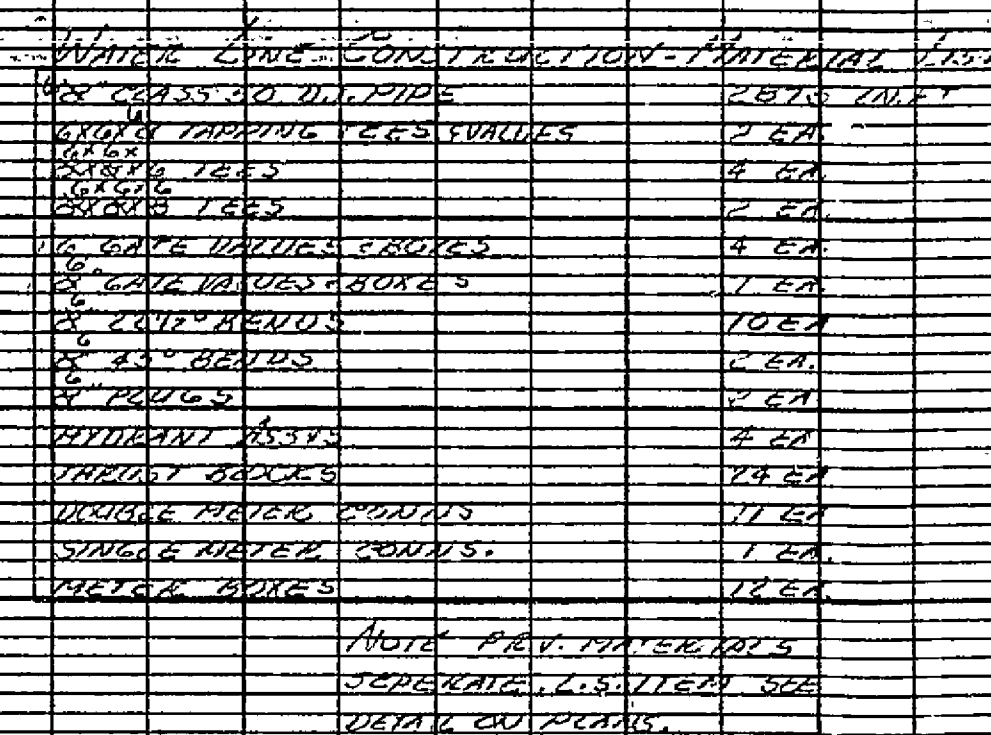


PROFILE NOTE BOOK No. _____	SURVEYED _____ PLOTTED _____ GRADES CHECKED _____ B. M.'s NOTED _____ STRUCTURE NOTATIONS CHECKED _____	BY _____ DATE _____
--	---	------------------------

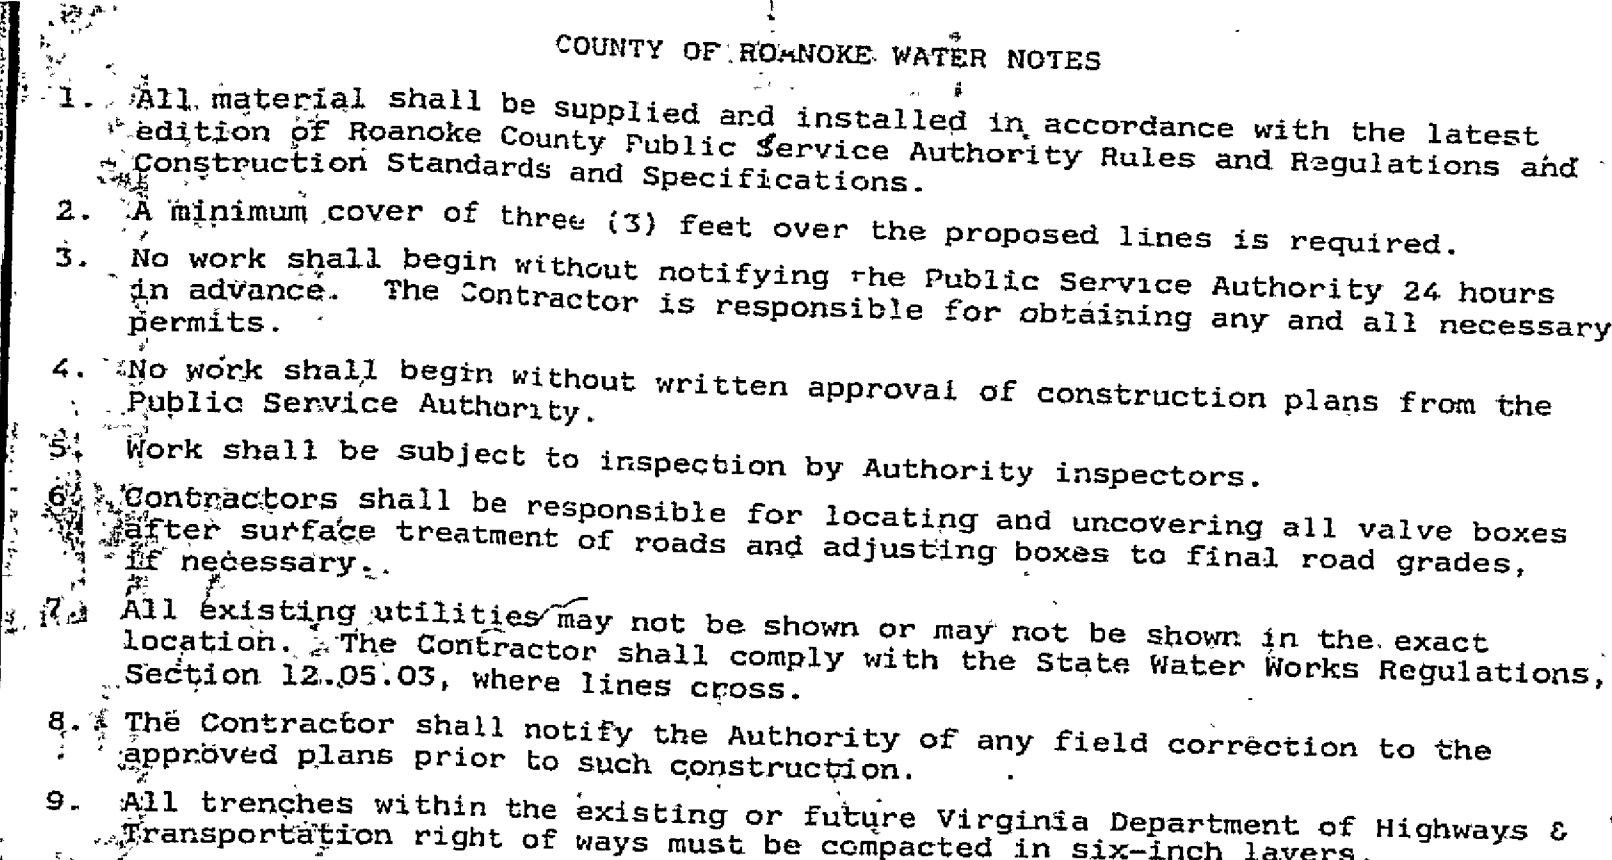

PLAN OF ROUTE BLACK BEAR LAKE
SECTION 16.18
HUNTING HILLS
PROPERTY OF
OLD HERITAGE CORPORATION
Harrison County, Virginia
Feb. 9, 1979

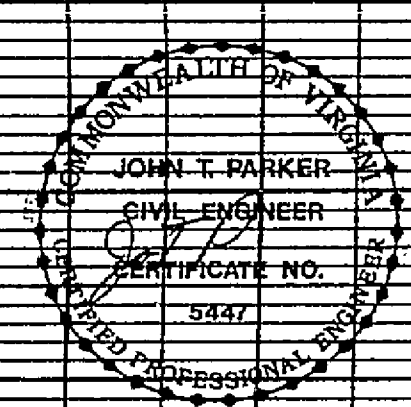

AS-BUILT NOTES:

- 1) FINAL AS-BUILT CONDITIONS SHOWN TO THE REPRESENTS FINAL AS-BUILT CONDITIONS