
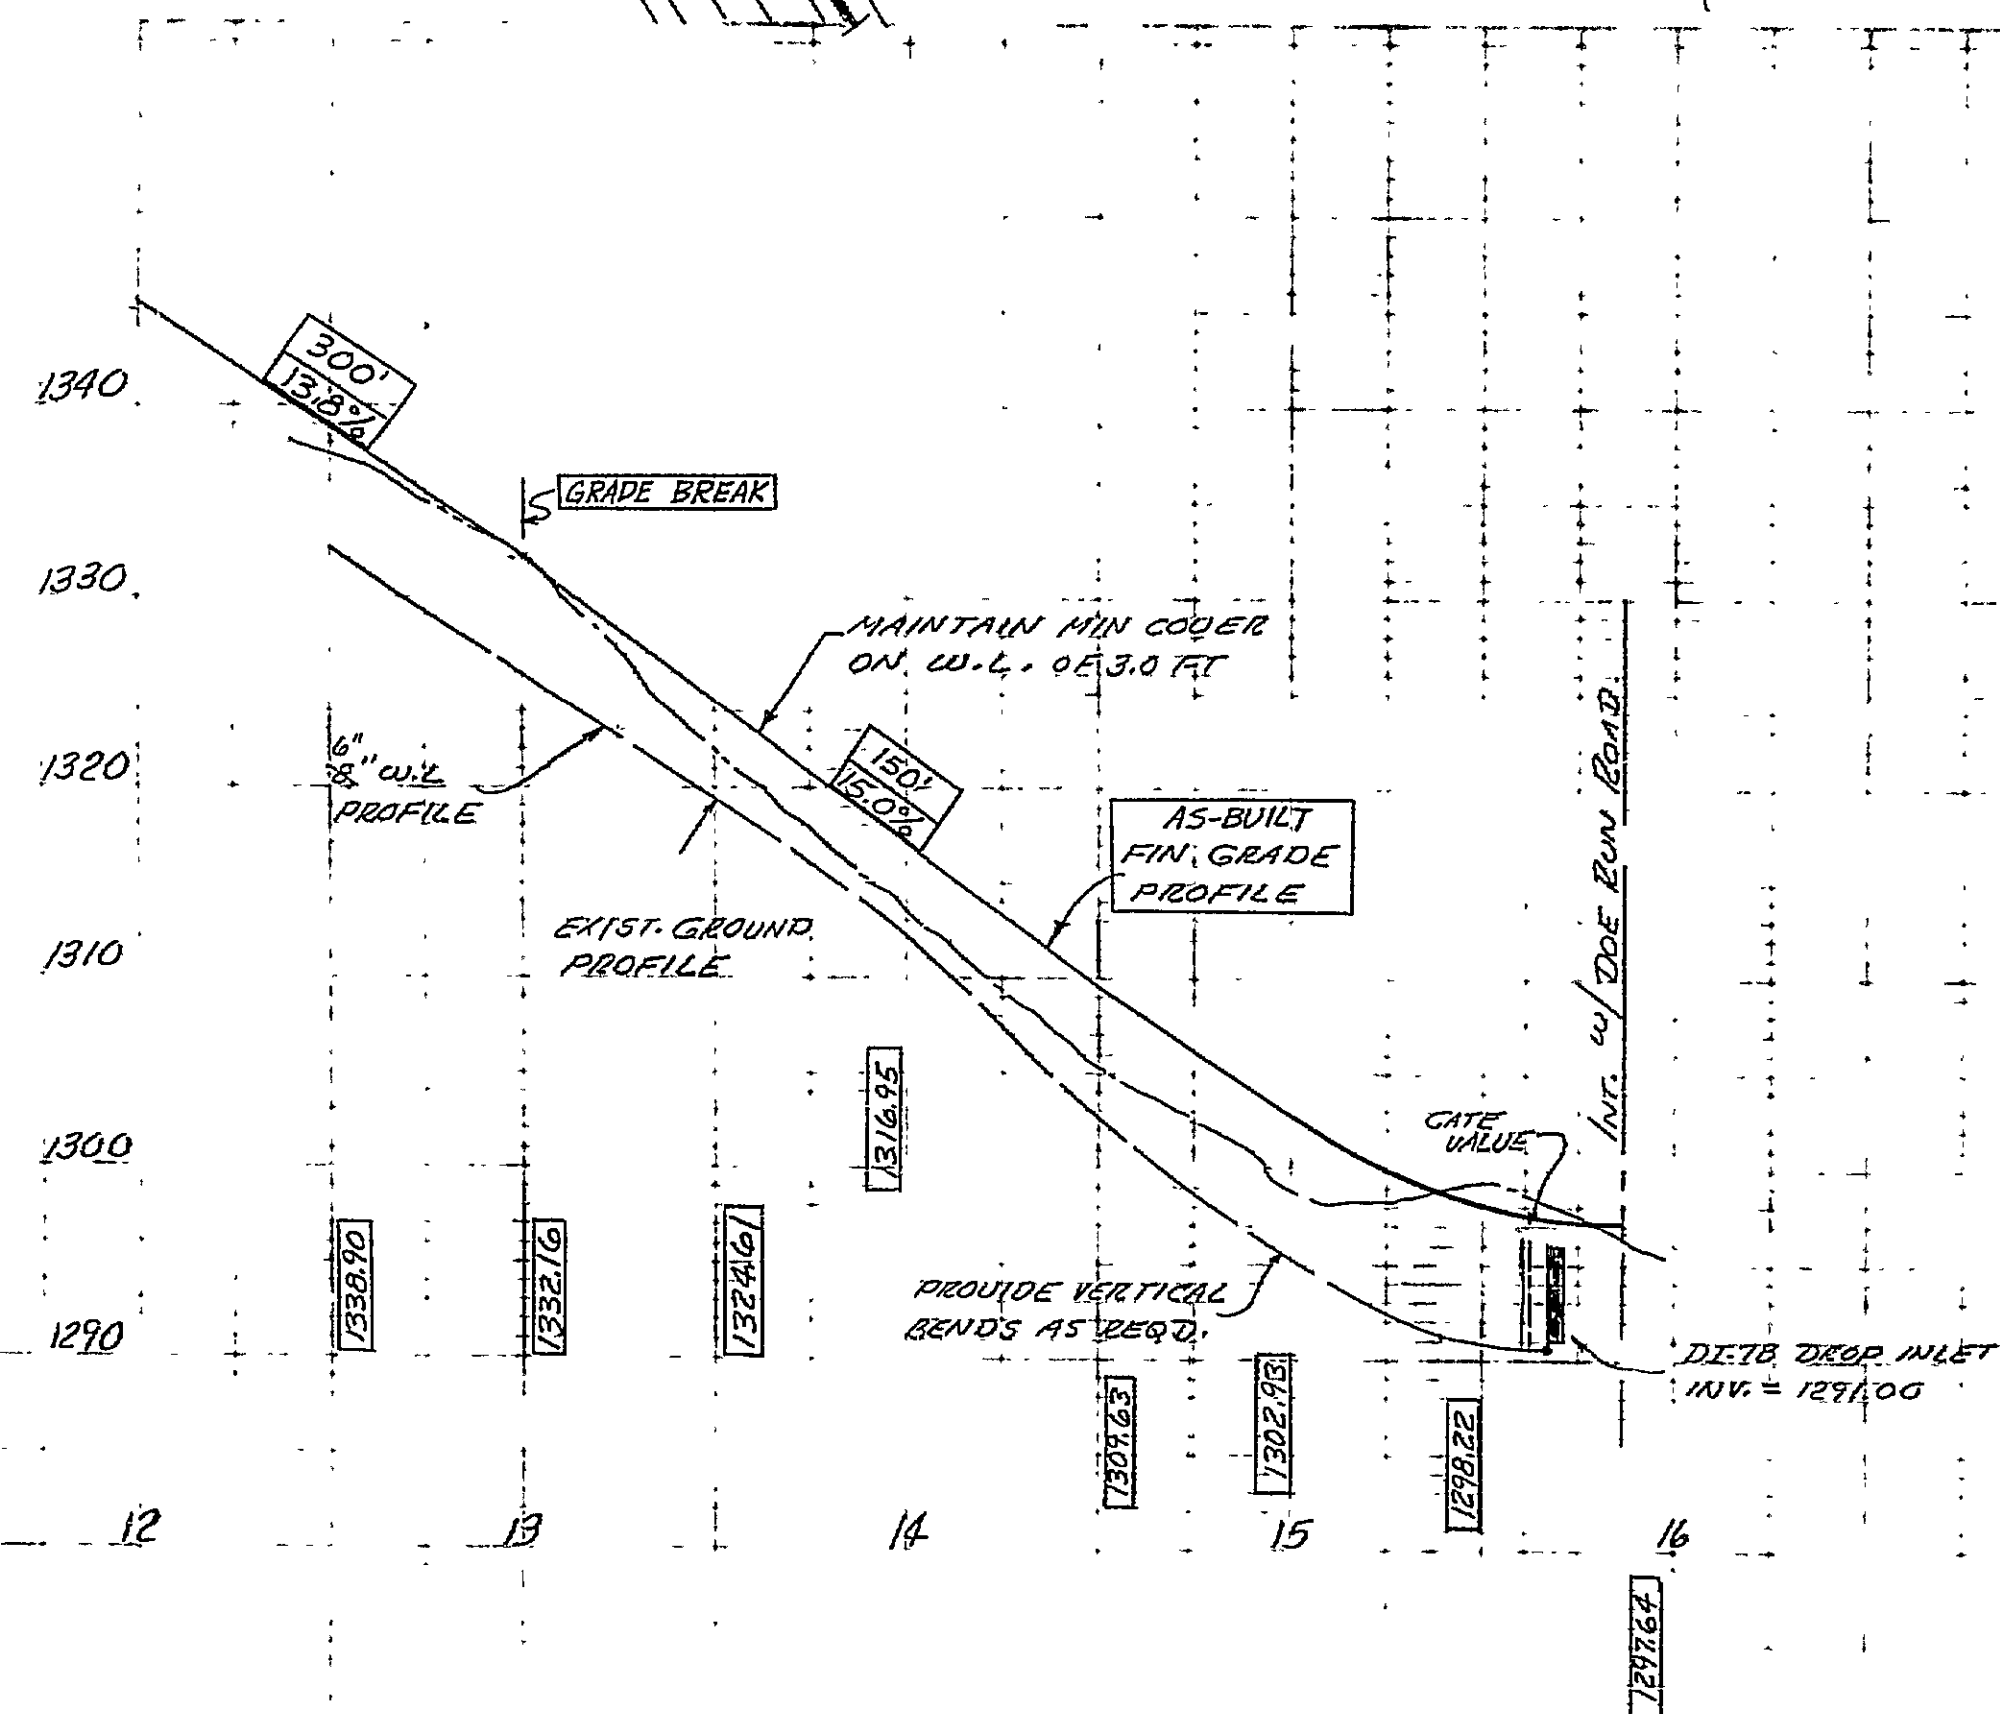
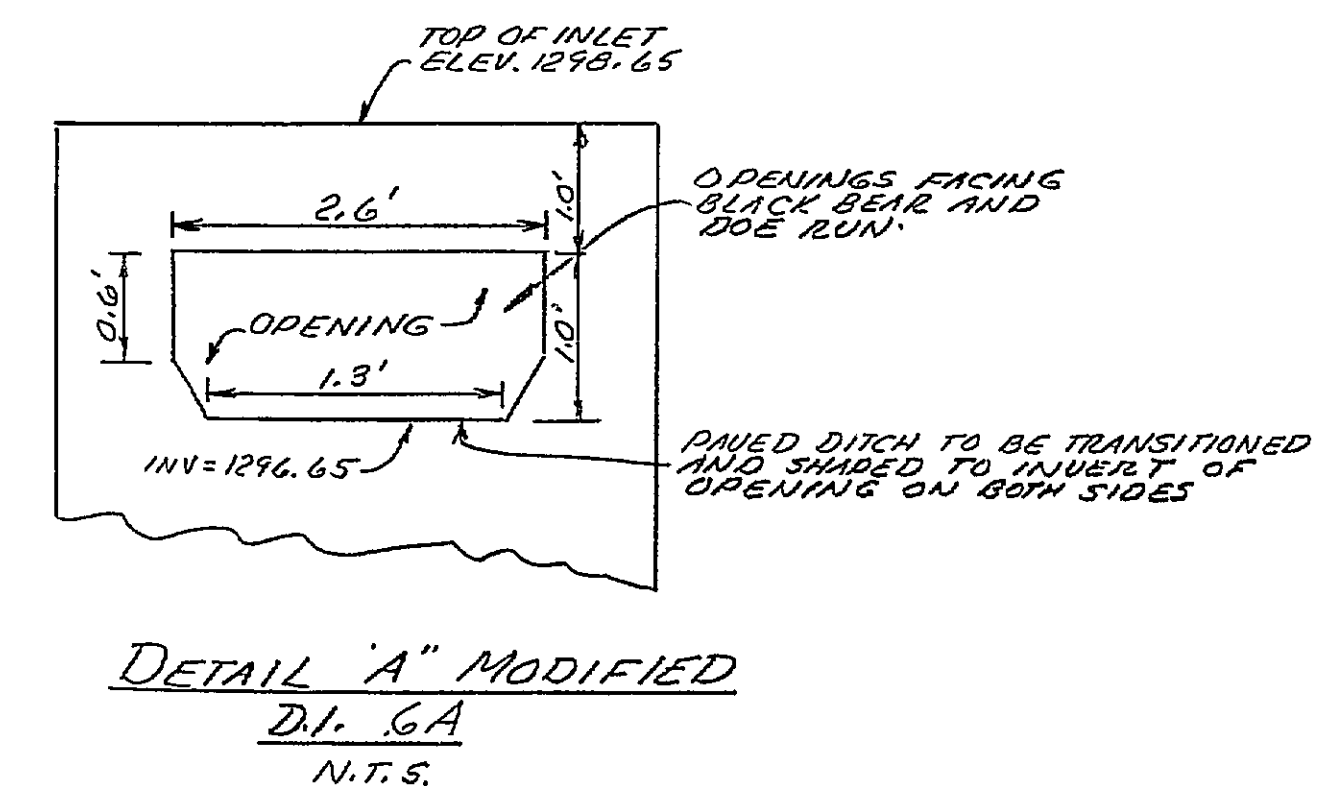


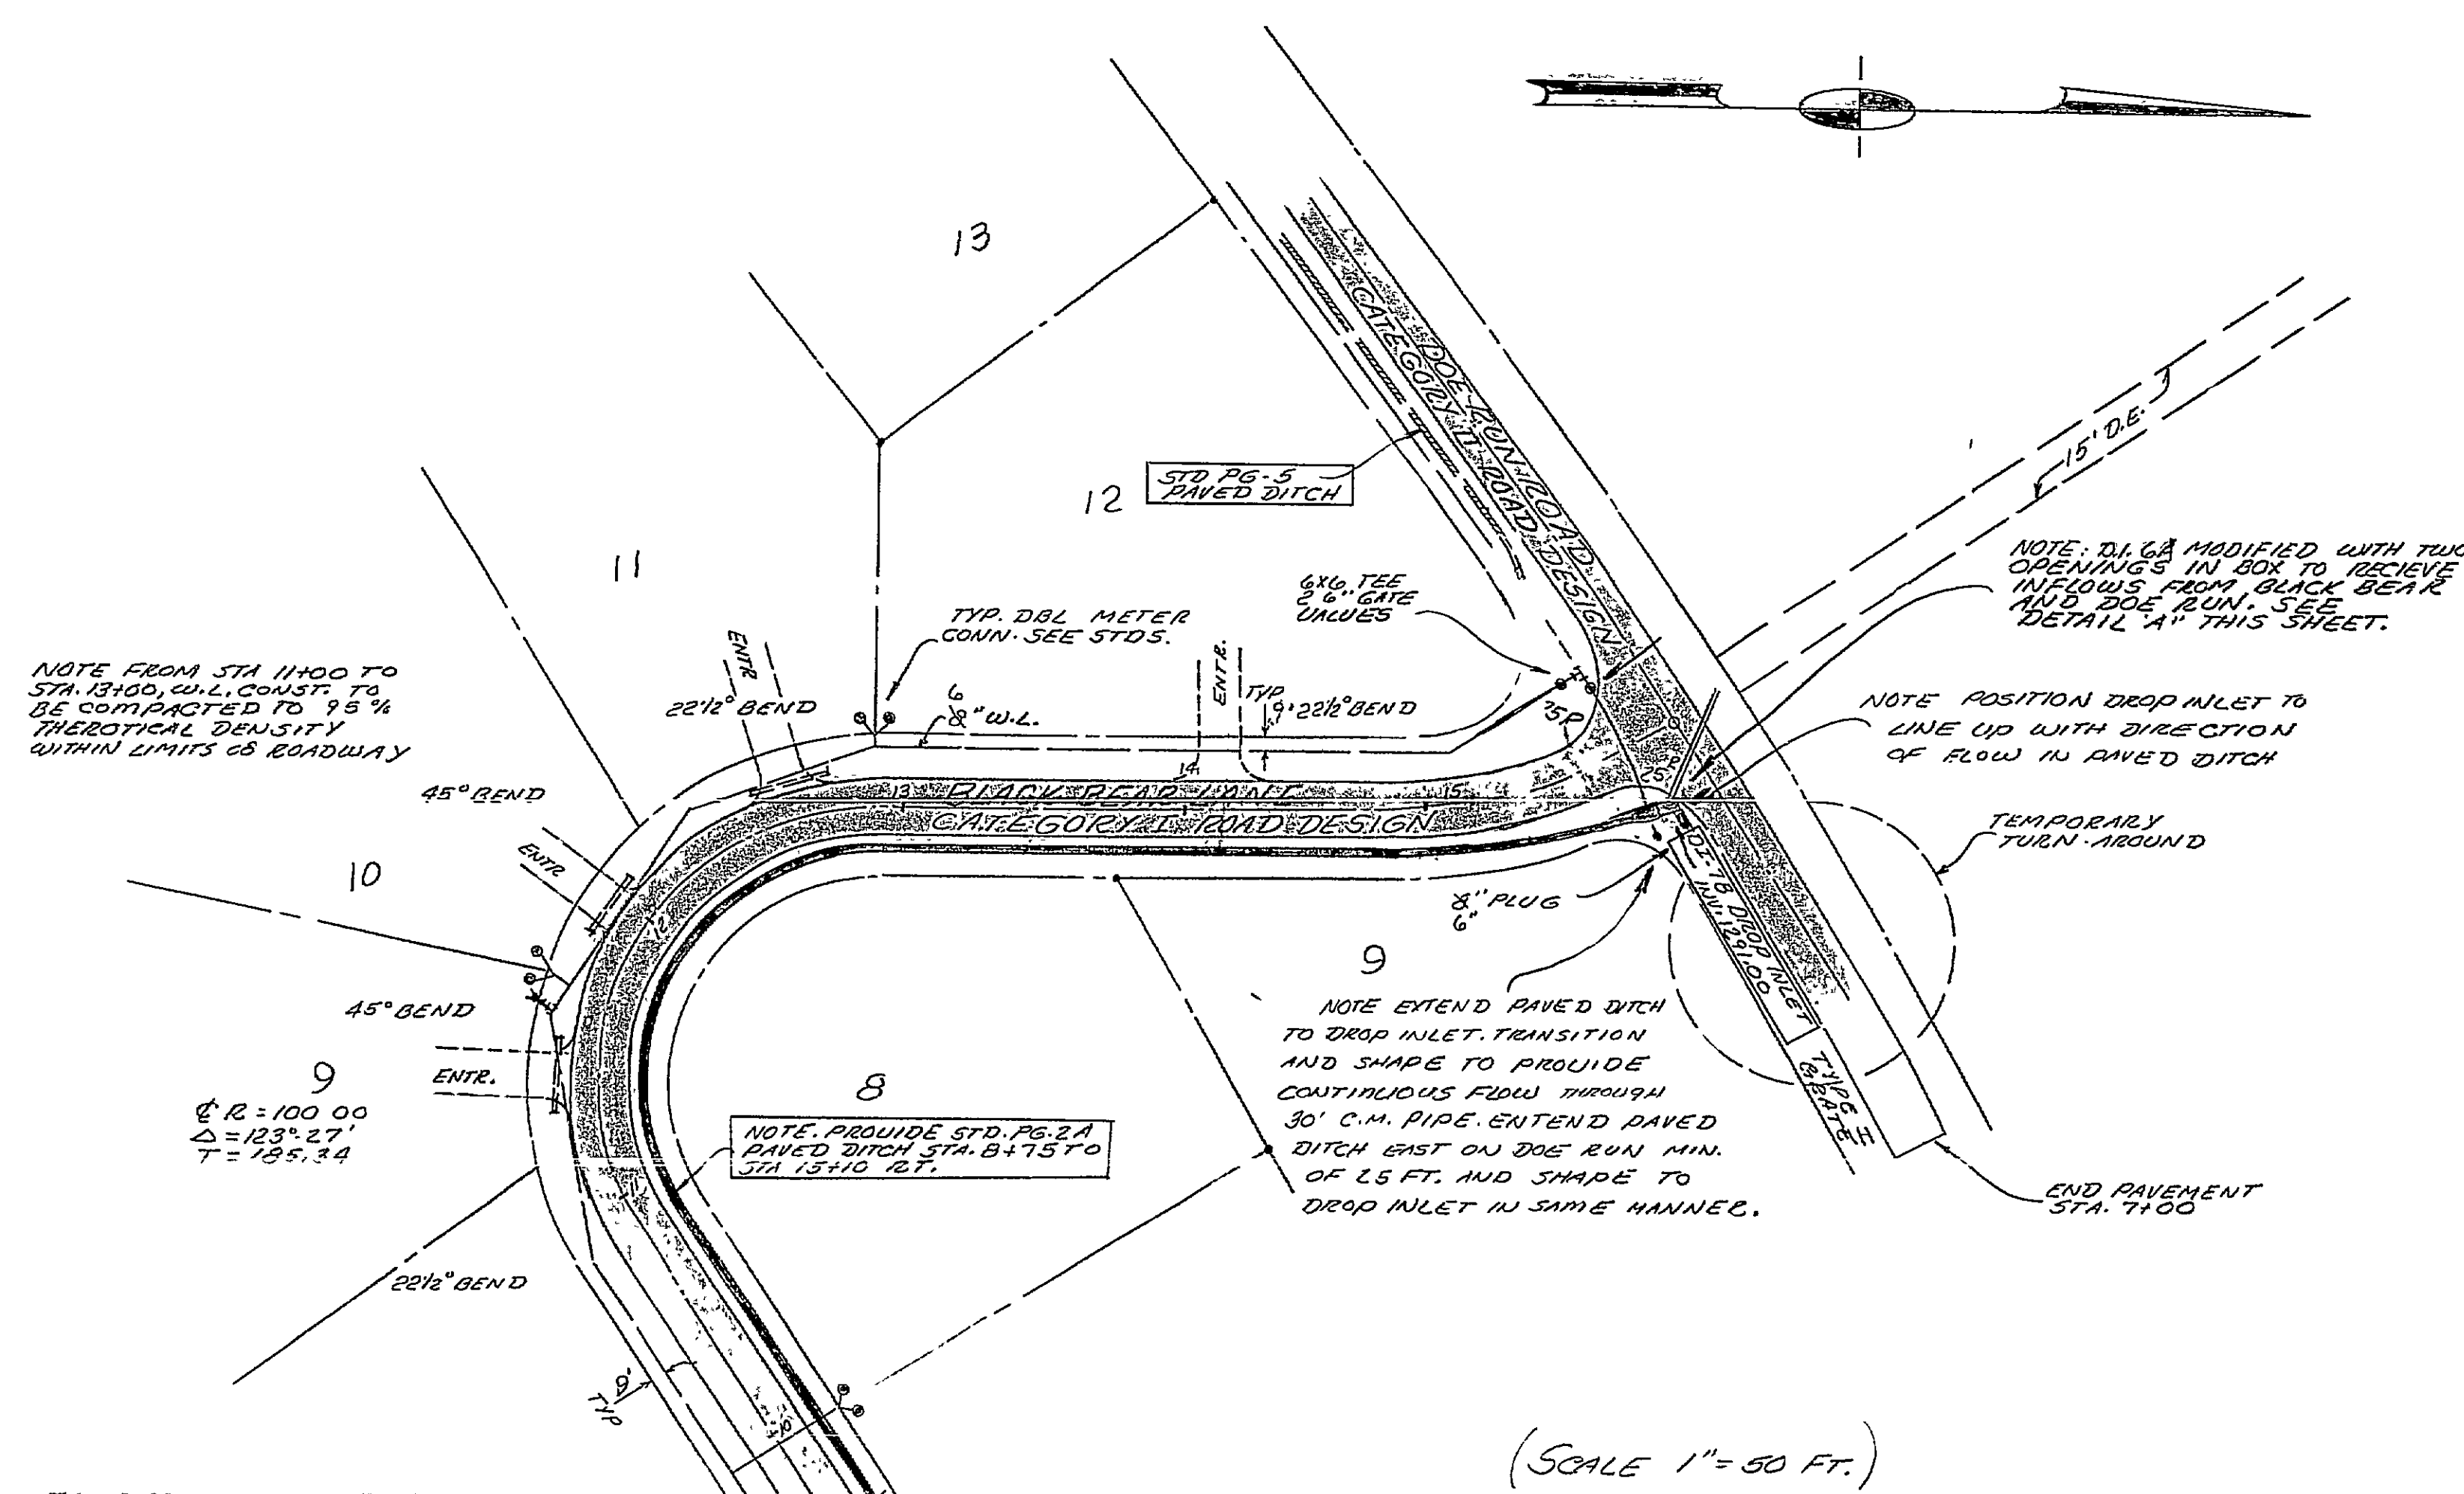


WATER LINE CONSTRUCTION MATERIAL LIST

6\"/>

NOTE: P.A.V. MATERIALS SEPARATE, C.B. ITEMS SEE DATA ON PLANS.

PLAN & PROFILE - BLACK BEAR LANE
SECTION No. 12
HUNTING HILLS
PROPERTY OF
OLD HERITAGE CORPORATION
Roanoke County, Virginia
Feb. 3, 1979

SHT. 10 OF 10

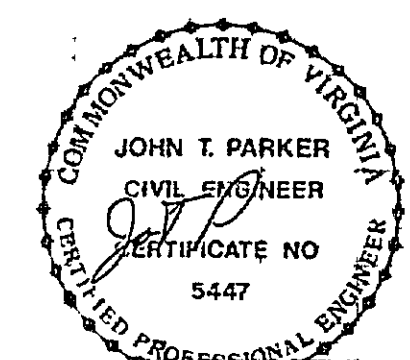

REMOVE PAVED DITCHING, DELETE DRAINAGE EASEMENT
A-23-79

AS-BUILT NOTES:
1) FINAL AS-BUILT CONDITIONS SHOWN THUS [] AND REPRESENTS FINAL AS-BUILT CONDITIONS.
2) MODIFICATIONS TO D.I. 7B AT INTERSECTION OF BLACK BEAR AND DOE RUN.