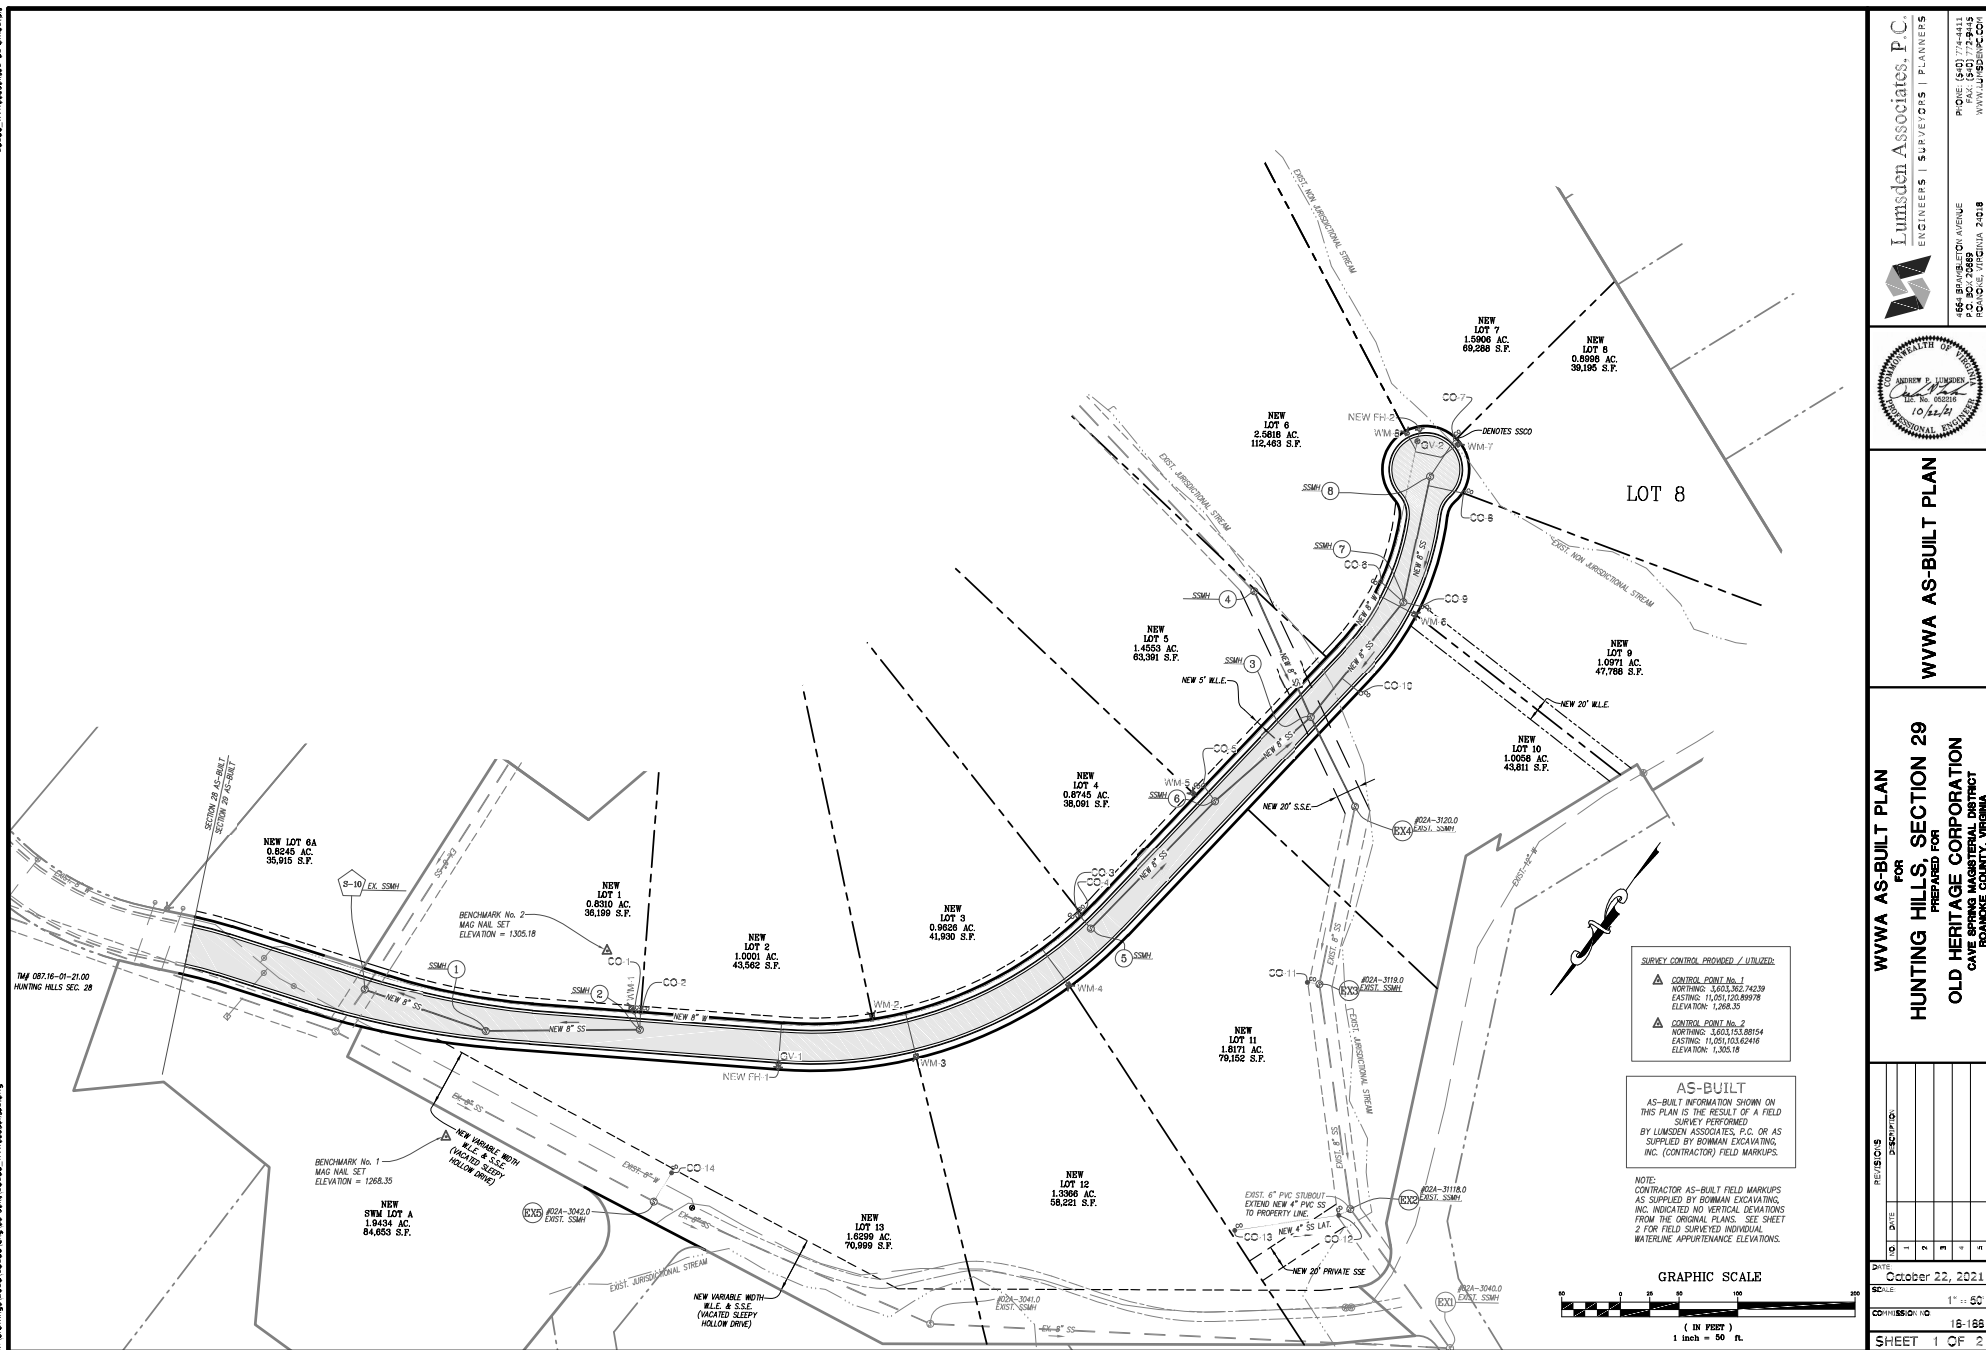


**WVWA AS-BUILT PLAN**

**WWVA AS-BUILT PLAN
FOR
HUNTING HILLS, SECTION 29
PREPARED FOR
OLD HERITAGE CORPORATION
CAVE SPRING MAGISTERIAL DISTRICT
ROANOKE COUNTY, VIRGINIA**

REVISIONS		DESCRIPTION
1	DATE	
2		
3		
4		
5		

DATE: October 22, 2021

SCALE: $1'' = 60'$

COMMISSION NO. 16-166

SHEET 1 OF 2