
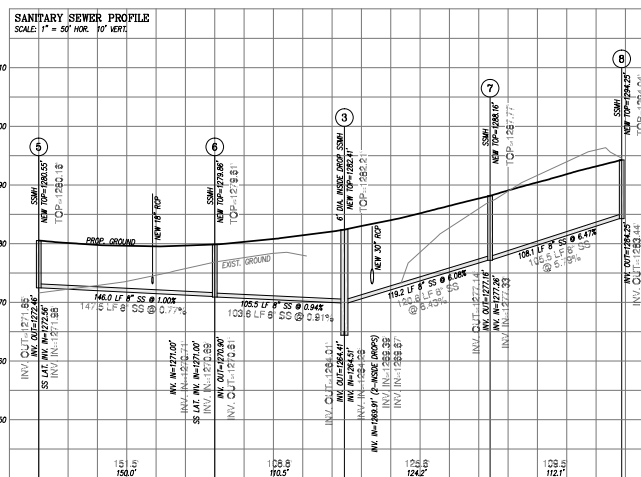


ID	Inn. In	Inn. Out	Structure Elev.
SSMH-EX2	1,232.99	1,232.70	1,239.68
	1,232.87		
SSMH-EX3	1,246.95	1,246.38	1,252.90
	1,247.34		
SSMH-EX5	1,248.34	1,248.17	1,252.90
	1,249.08		

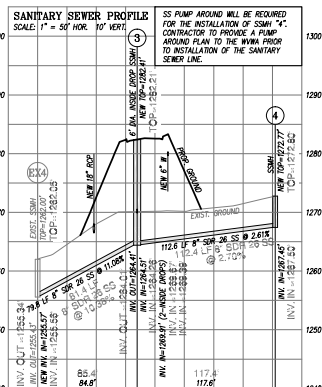

- DEVELOPMENT PLAN
FOR
HUNTING HILLS, SECTION 29
PREPARED FOR
OLD HERITAGE CORPORATION
CAVE SPRING MAGISTERIAL DISTRICT

REVISED		DESCRIPTION	
NO.	DATE	DESCRIPTION	AMOUNT
1	6/7/2021	ALL STOPS AND TRAVEL CHANGED TO 4-STAR (NCS) AVOID UNIT NOT A.I.	
2			
3			
4			
5			

DATE: October 22, 2021

SCALE: 1" = 60'


COMPILED BY: 18-166

SHEET 2 OF 2

 **Lumsden Associates, P.C.**
ENGINEERS | SURVEYORS | PLANNERS

855, BRANFLETTON AVENUE
P.O. BOX 20689
PISCATAWAY, VIRGINIA 22018

PHONE: (540) 774-4411
FAX: (540) 777-9445
WWW.LUMSDENPC.COM

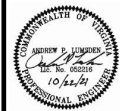

AS-BUILT SANITARY SEWER PROFILES