



DATE	BY	REVISION
AUG. 88	E. JOYNER	1. AS-BUILT
		2. CORRECTIONS
		3. REVISIONS
		4. CHANGES
		5. ADJUSTMENTS
		6. FINAL CHECK
		7. APPROVAL
		8. SIGNATURE
		9. DATE
		10. LOCATION
		11. SCALE
		12. SHEET NO.
		13. TOTAL SHEETS
		14. PROJECT NO.
		15. CLIENT NAME
		16. PROJECT ADDRESS
		17. PROJECT CITY
		18. PROJECT STATE
		19. PROJECT ZIP
		20. PROJECT PHONE
		21. PROJECT FAX
		22. PROJECT E-MAIL
		23. PROJECT WEBSITE
		24. PROJECT DESCRIPTION
		25. PROJECT PURPOSE
		26. PROJECT SCOPE
		27. PROJECT BOUNDARY
		28. PROJECT ADJACENTS
		29. PROJECT ZONING
		30. PROJECT PERMITS
		31. PROJECT AGREEMENT
		32. PROJECT SCHEDULE
		33. PROJECT BUDGET
		34. PROJECT RISK
		35. PROJECT QUALITY
		36. PROJECT SAFETY
		37. PROJECT ENVIRONMENT
		38. PROJECT HISTORY
		39. PROJECT LEGACY
		40. PROJECT FUTURE

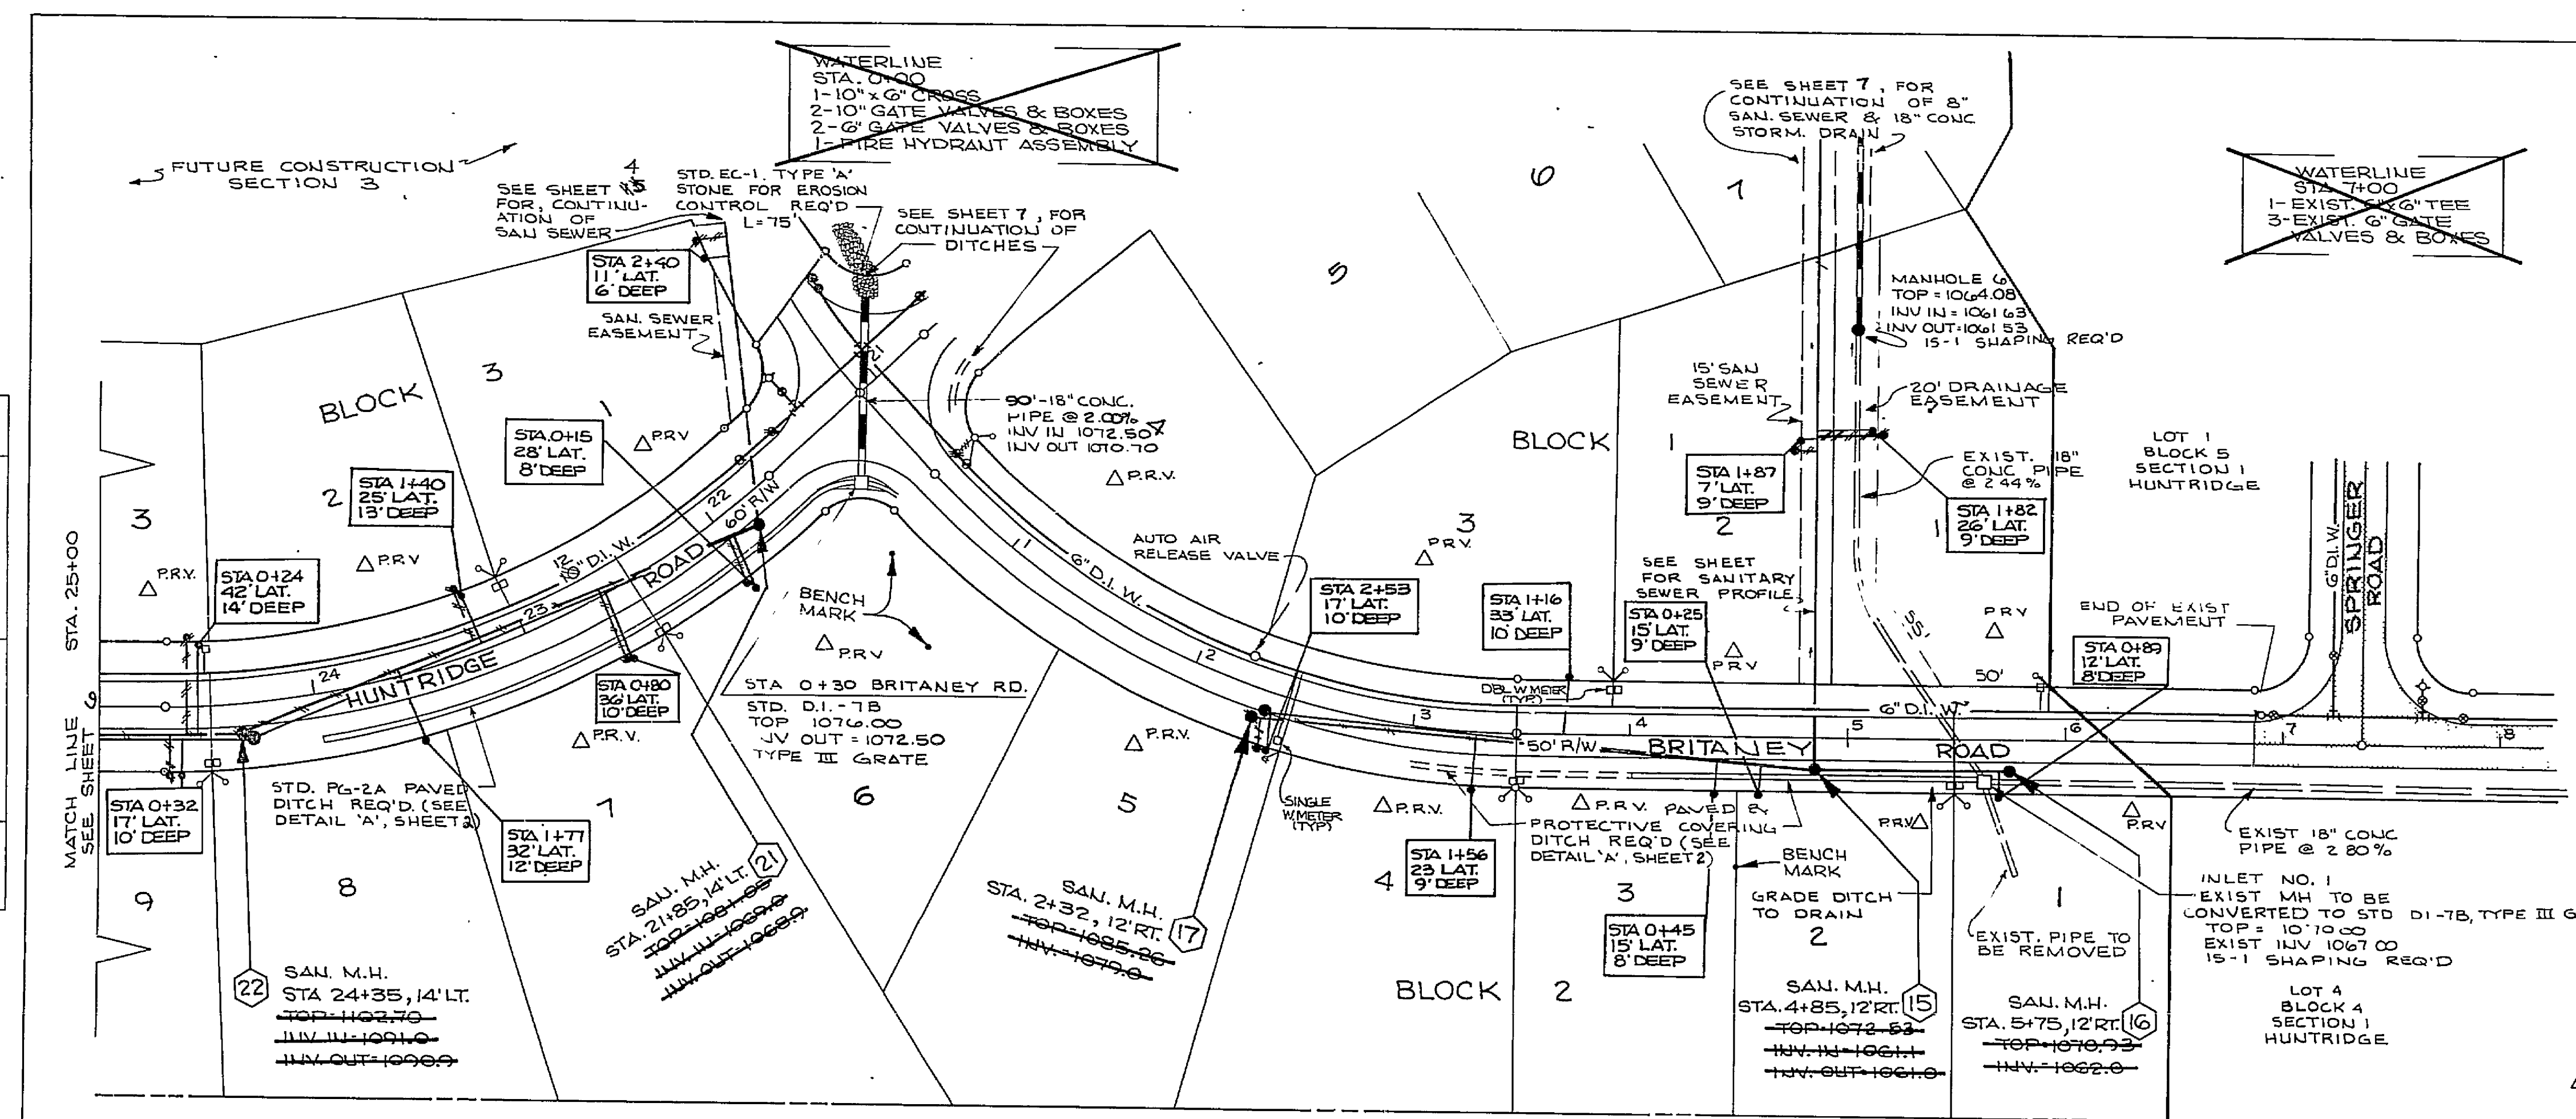


AS-BUILT PLAN
JAN. 3, 1989

WATERLINE & SANITARY SEWER
SERVICES ONLY

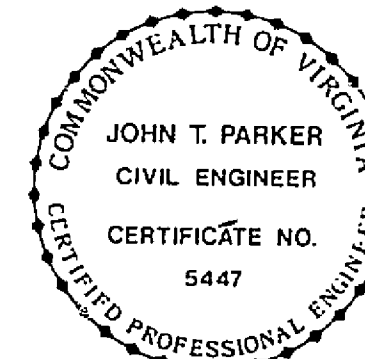

△ P.R.V. - DENOTES PRESSURE REDUCING
VALVE REQ'D. TO BE INSTALLED
BY DEVELOPER.

SCALE: 1" = 50' HORIZONTAL
1" = 10' VERTICAL

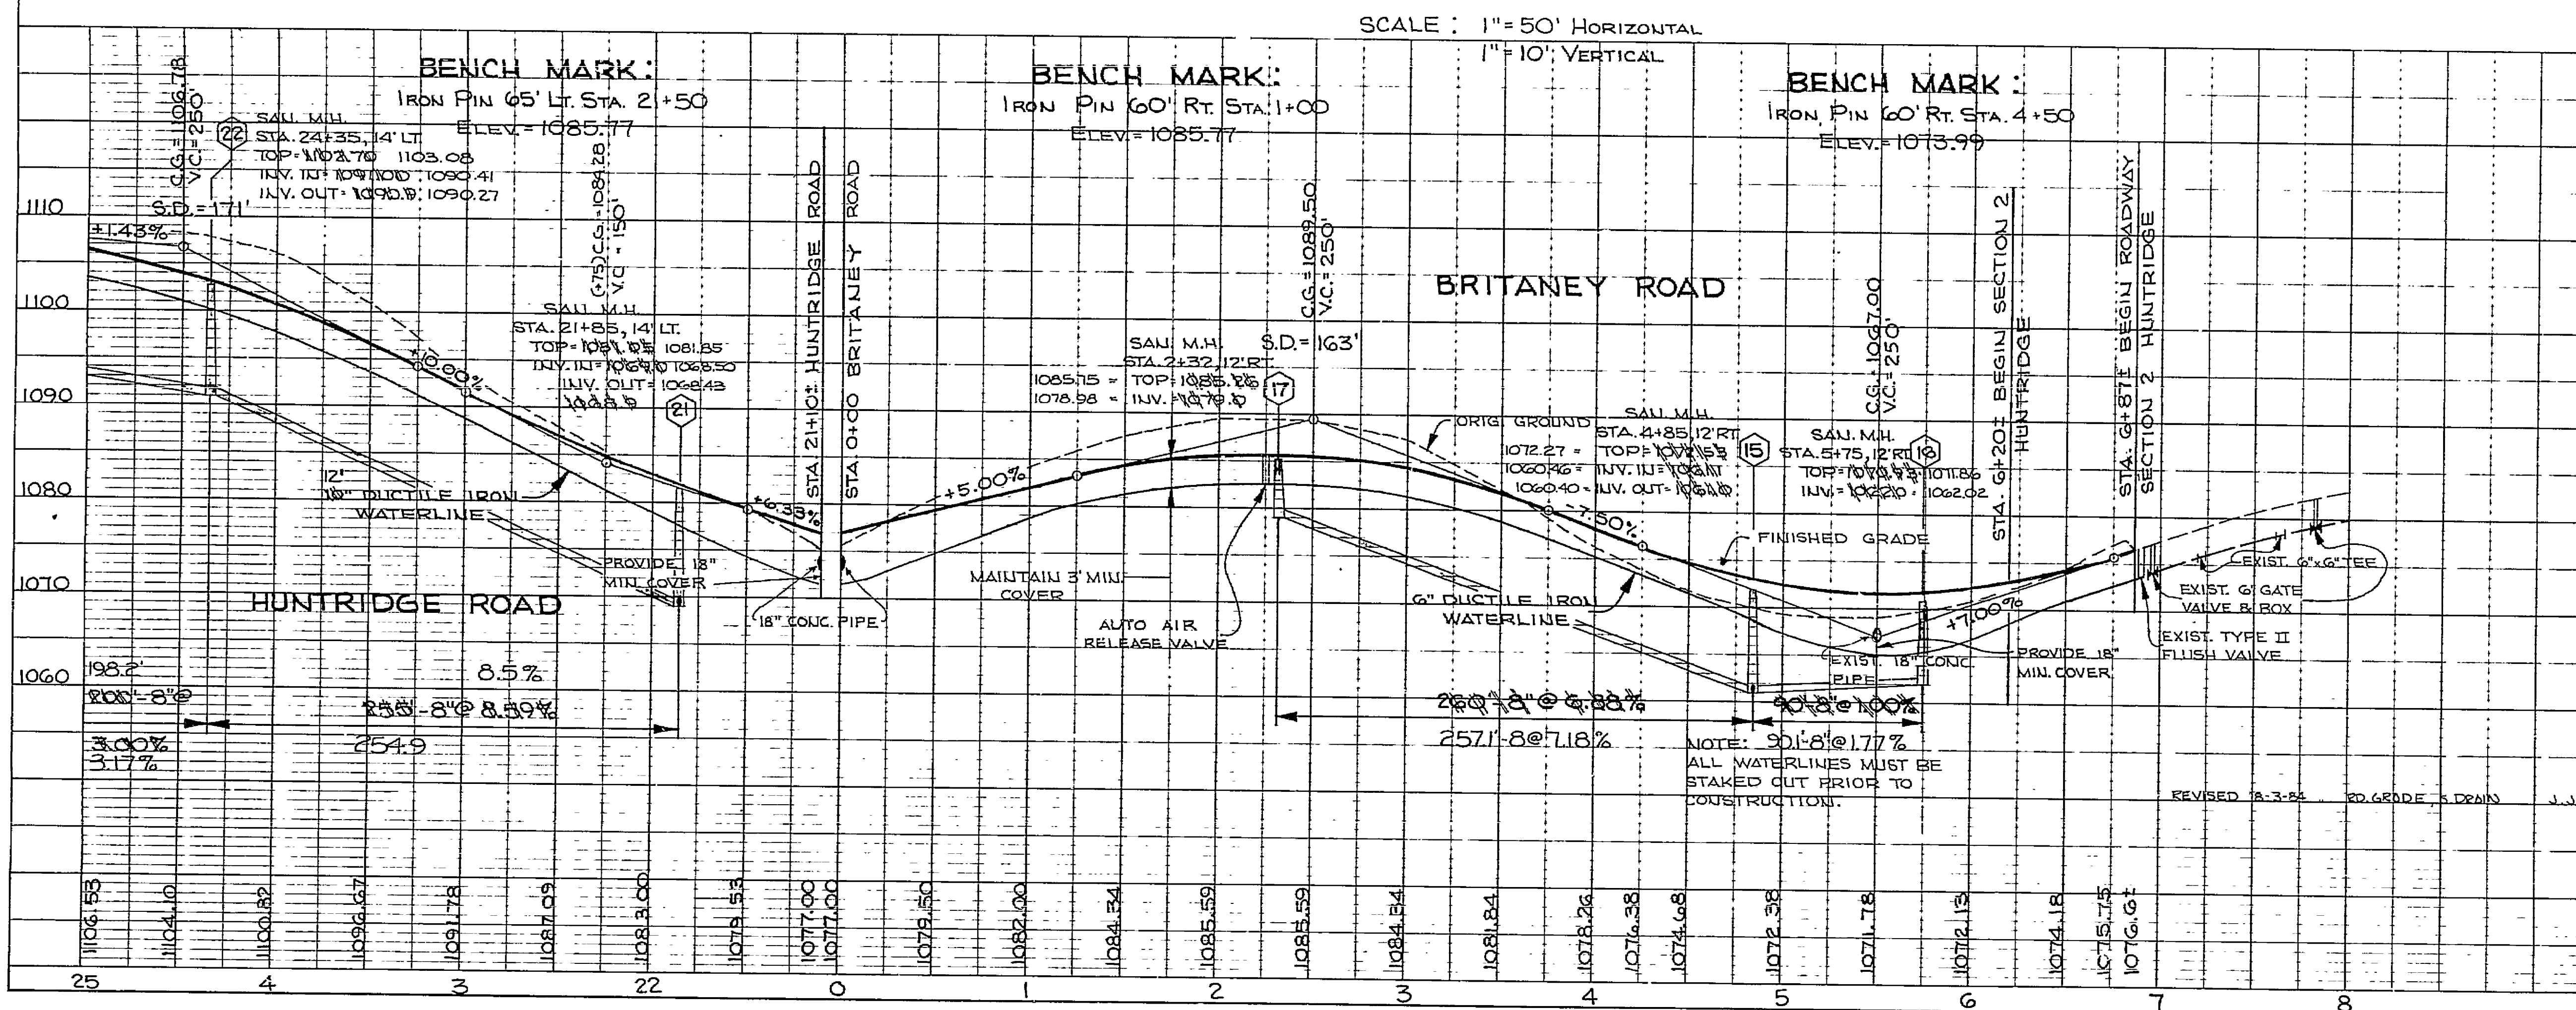

SECTION 2 HUNTRIDGE ROANOKE COUNTY, VIRGINIA	
DESIGNED BY: R. BROTHER DRAWN BY: E. JOYNER CHECKED BY: J. JOYNER	
PLAN & PROFILE HUNTRIDGE RD. & BRITANEY RD. STA. 8+00 - STA. 25+00	
T. P. PARKER & SON ENGINEERS & SURVEYORS LTD. SALEM, VIRGINIA	SCALE: AS SHOWN DATE: OCT. 21, '83 SHEET: 5 OF 10

RC-0277