


AS-BUILT PLAN
JAN. 3, 1989
WATERLINE & SANITARY SEWER
SERVICES ONLY

PLAN	DATE	BY	CHKD.
NO.	NO.	NO.	NO.

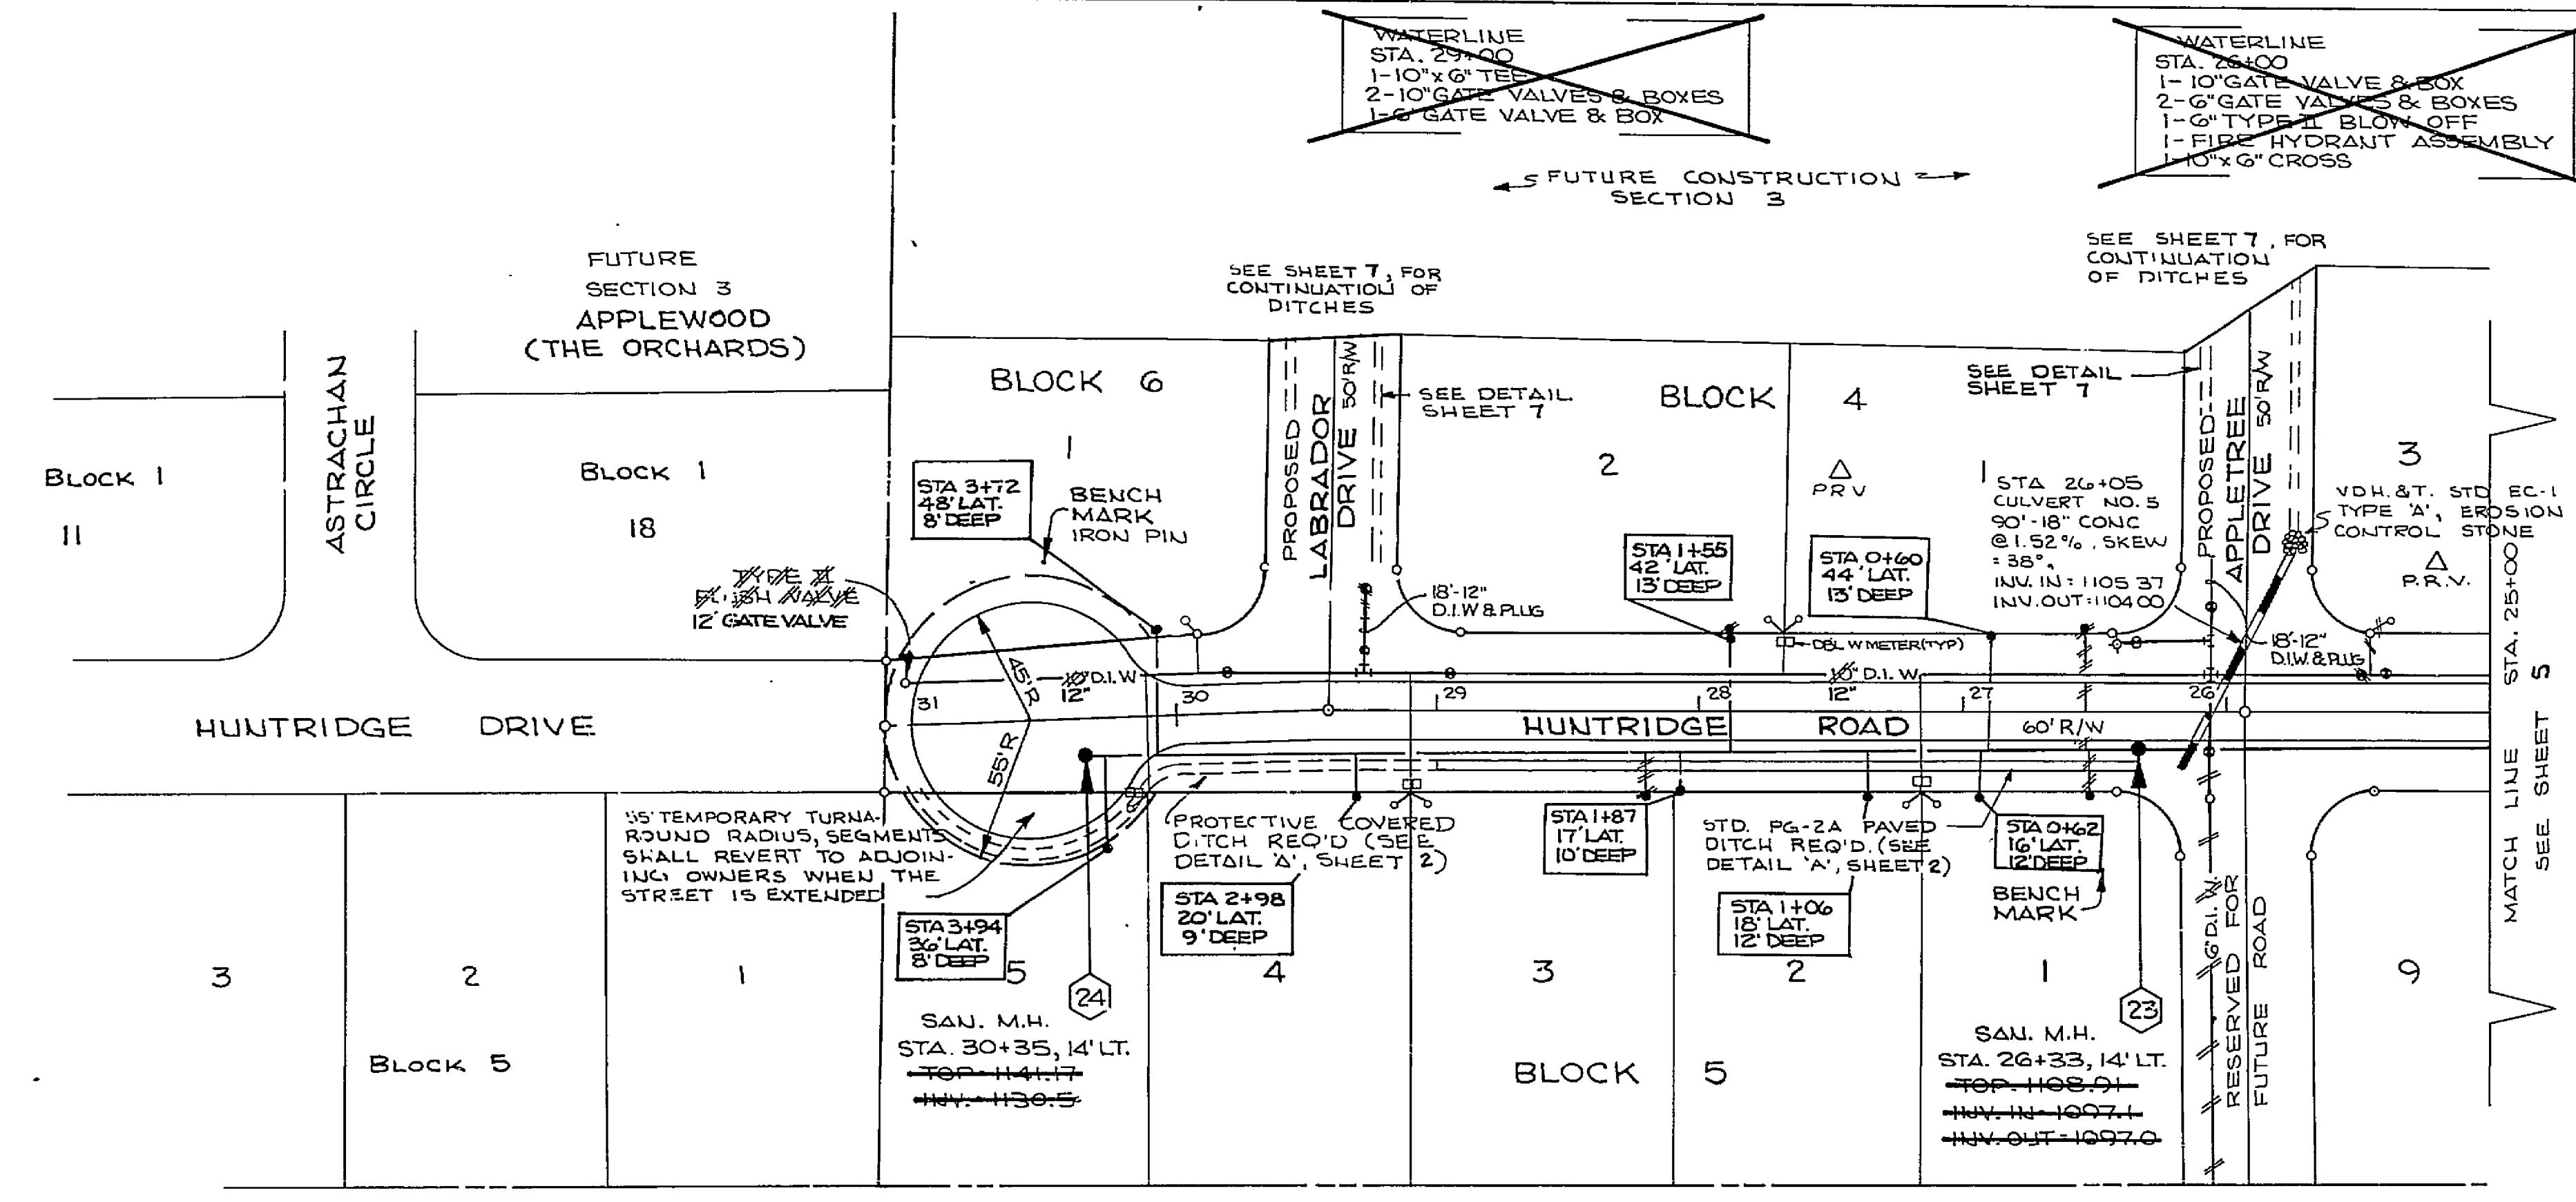


COMMONWEALTH OF VIRGINIA
JOHN T. PARKER
CIVIL ENGINEER
CERTIFICATE NO.
5447

Δ P.R.V. - DENOTES PRESSURE REDUCING
VALVE REQUIRED. TO BE INSTALLED
BY DEVELOPER.

SCALE: 1"=50' HORIZONTAL
1"=10' VERTICAL

PROFILE	DATE	BY	CHKD.
NO.	NO.	NO.	NO.

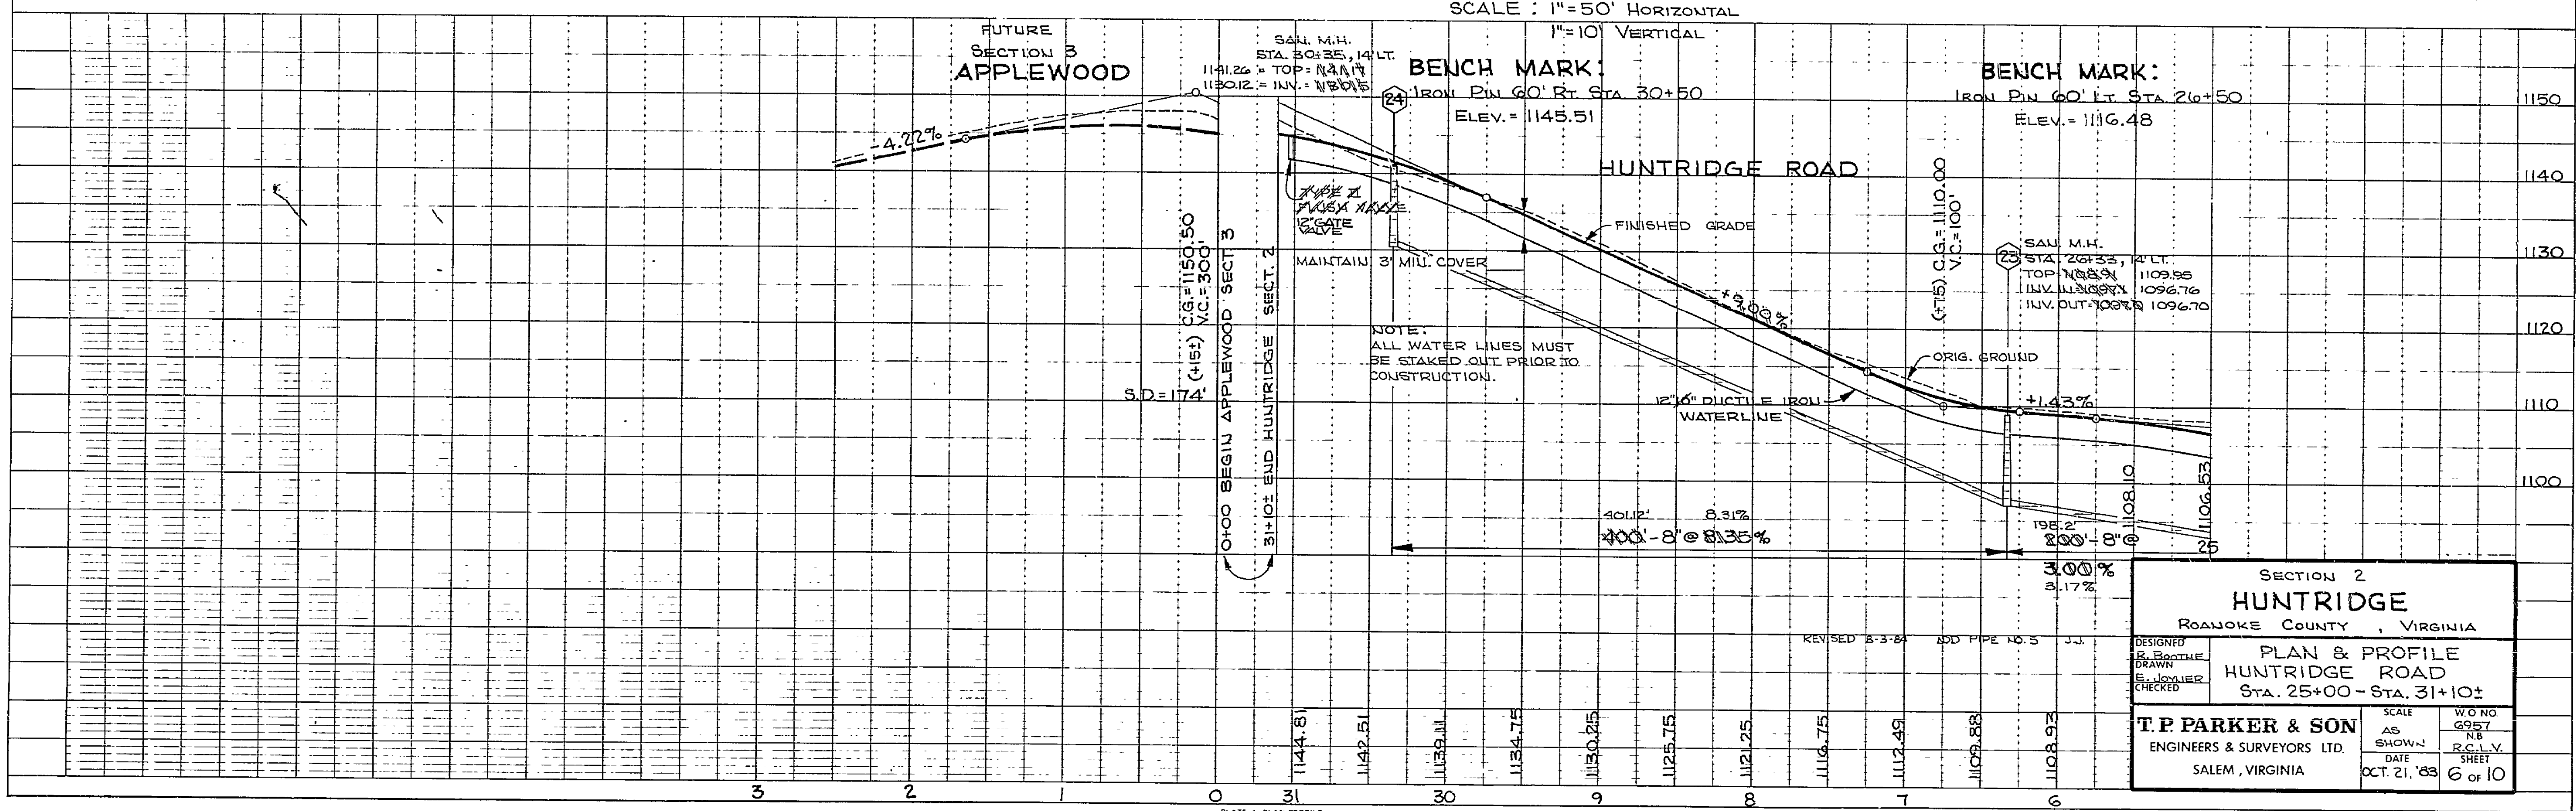

SECTION 2
HUNTRIDGE
ROANOKE COUNTY, VIRGINIA
DESIGNED
DRAWN
CHECKED
T.P. PARKER & SON
ENGINEERS & SURVEYORS LTD.
SALEM, VIRGINIA
SCALE
AS SHOWN
DATE
OCT 21, 83
W.O. NO.
5057
R.C.L.V.
SHEET
6 OF 10

RC-0278