


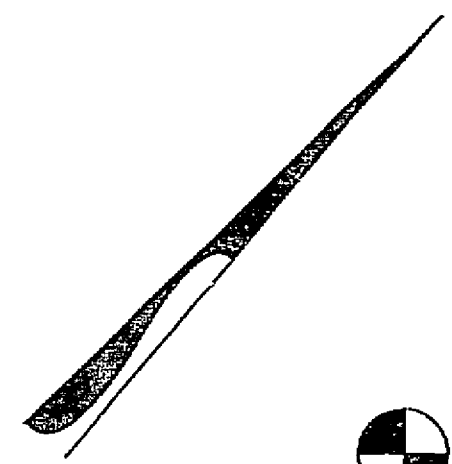

BENCHMARK
ARROWHEAD TOP OF
FIRE HYDRANT
ELEV. = 1115.39

LABRADORE
DRIVE

PROPERTY OF
ROANOKE COUNTY
LAND VENTURE, INC.
LOT 1, BLOCK 2, SECTION 3
HUNTRIDGE

PROPERTY OF
F & W COMMUNITY
DEVELOPMENT, CORP.
LOT 13, SECTION 1
APPLEWOOD

APPLETREE
DRIVE

CATEGORY I PAVEMENT DESIGN
SURFACE COURSE: PRIME AND DBL. SEAL
6" TYPE I AGGREGATE BASE COURSE

AS-BUILT PLAN
SEPT. 1, 1994

STORM DRAIN SYSTEM

SCALE: HORIZ: 1" = 20'
VERT: 1" = 5'


APPLETREE
DRIVE

HUNTRIDGE
PROPERTY OF
ROANOKE COUNTY LAND VENTURE, INC.

PLAN & PROFILE
APPLETREE DRIVE

T.P. PARKER & SON
8115 Boulevard
Post Office Box 39
Salem, Virginia 24153
Telephone: 703-387-1553
FAX: 703-389-5767





DESIGNED J.V.I. DRAWN J.V.J.
DATE DEC. 9 1992
W.D. NO. 92-1649
N.B. RCLY = 4
SHEET 6A OF 11

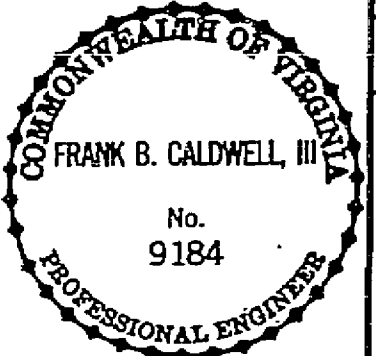

REVISED 12-21-92
PER ROANOKE CO.
& VDOT

PLAN
DATE
BY
NOTED
NO.

PROFILE
DATE
BY
NOTED
NO.

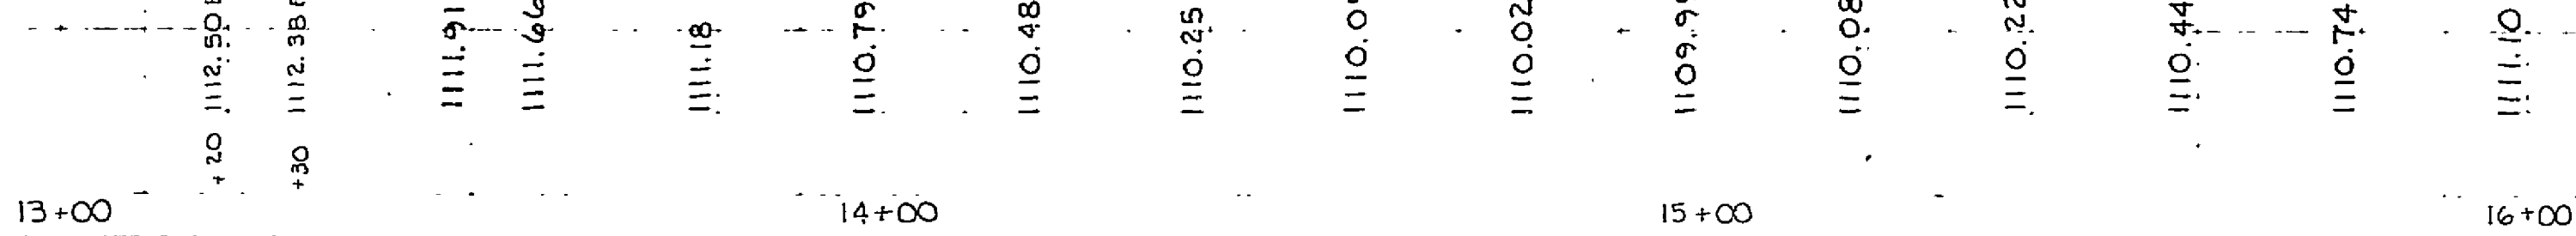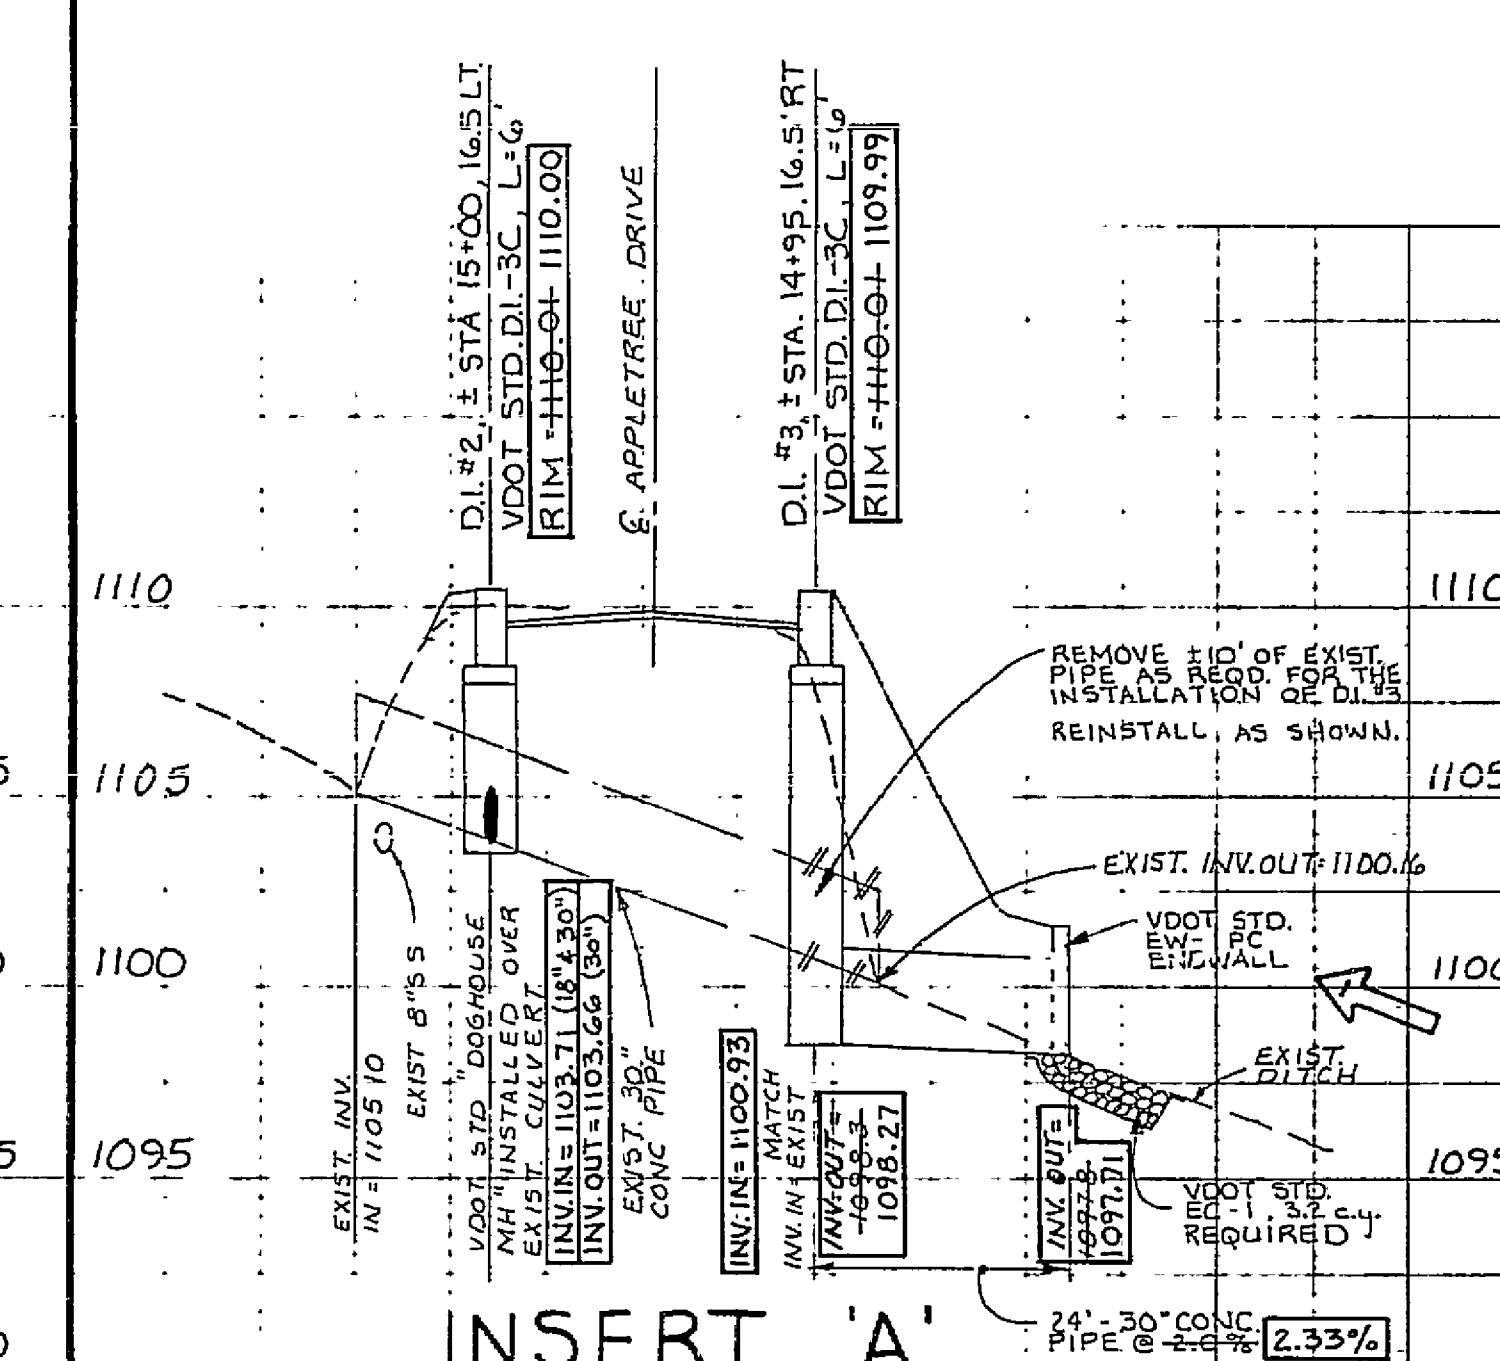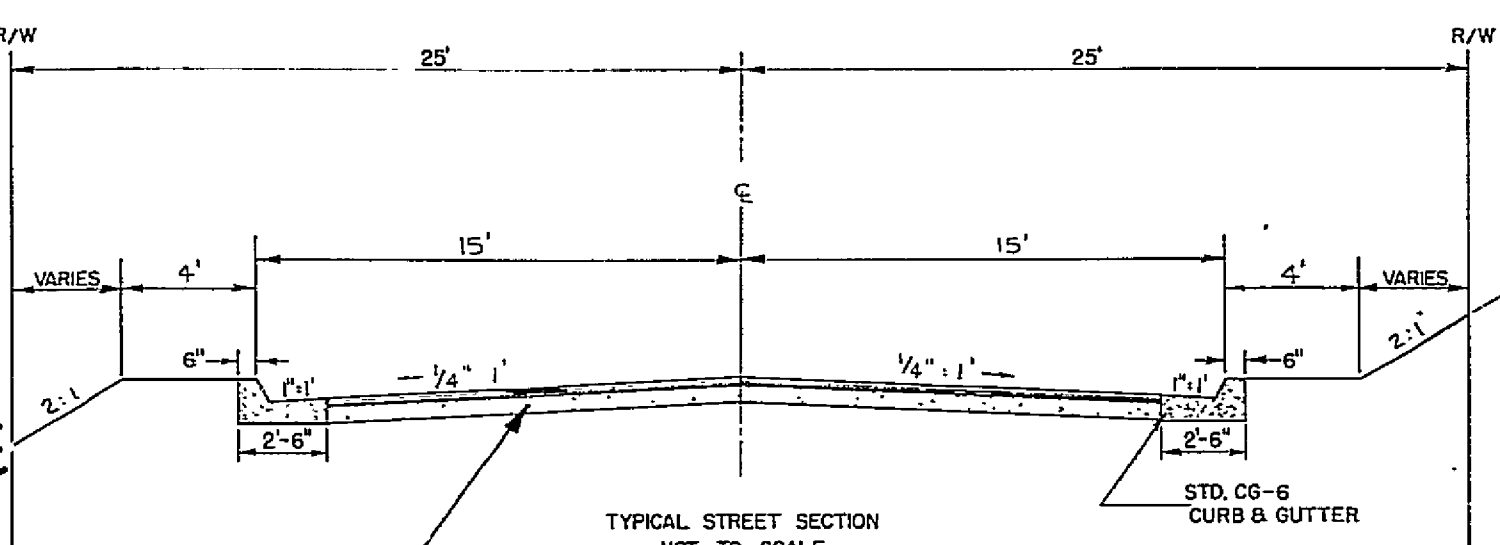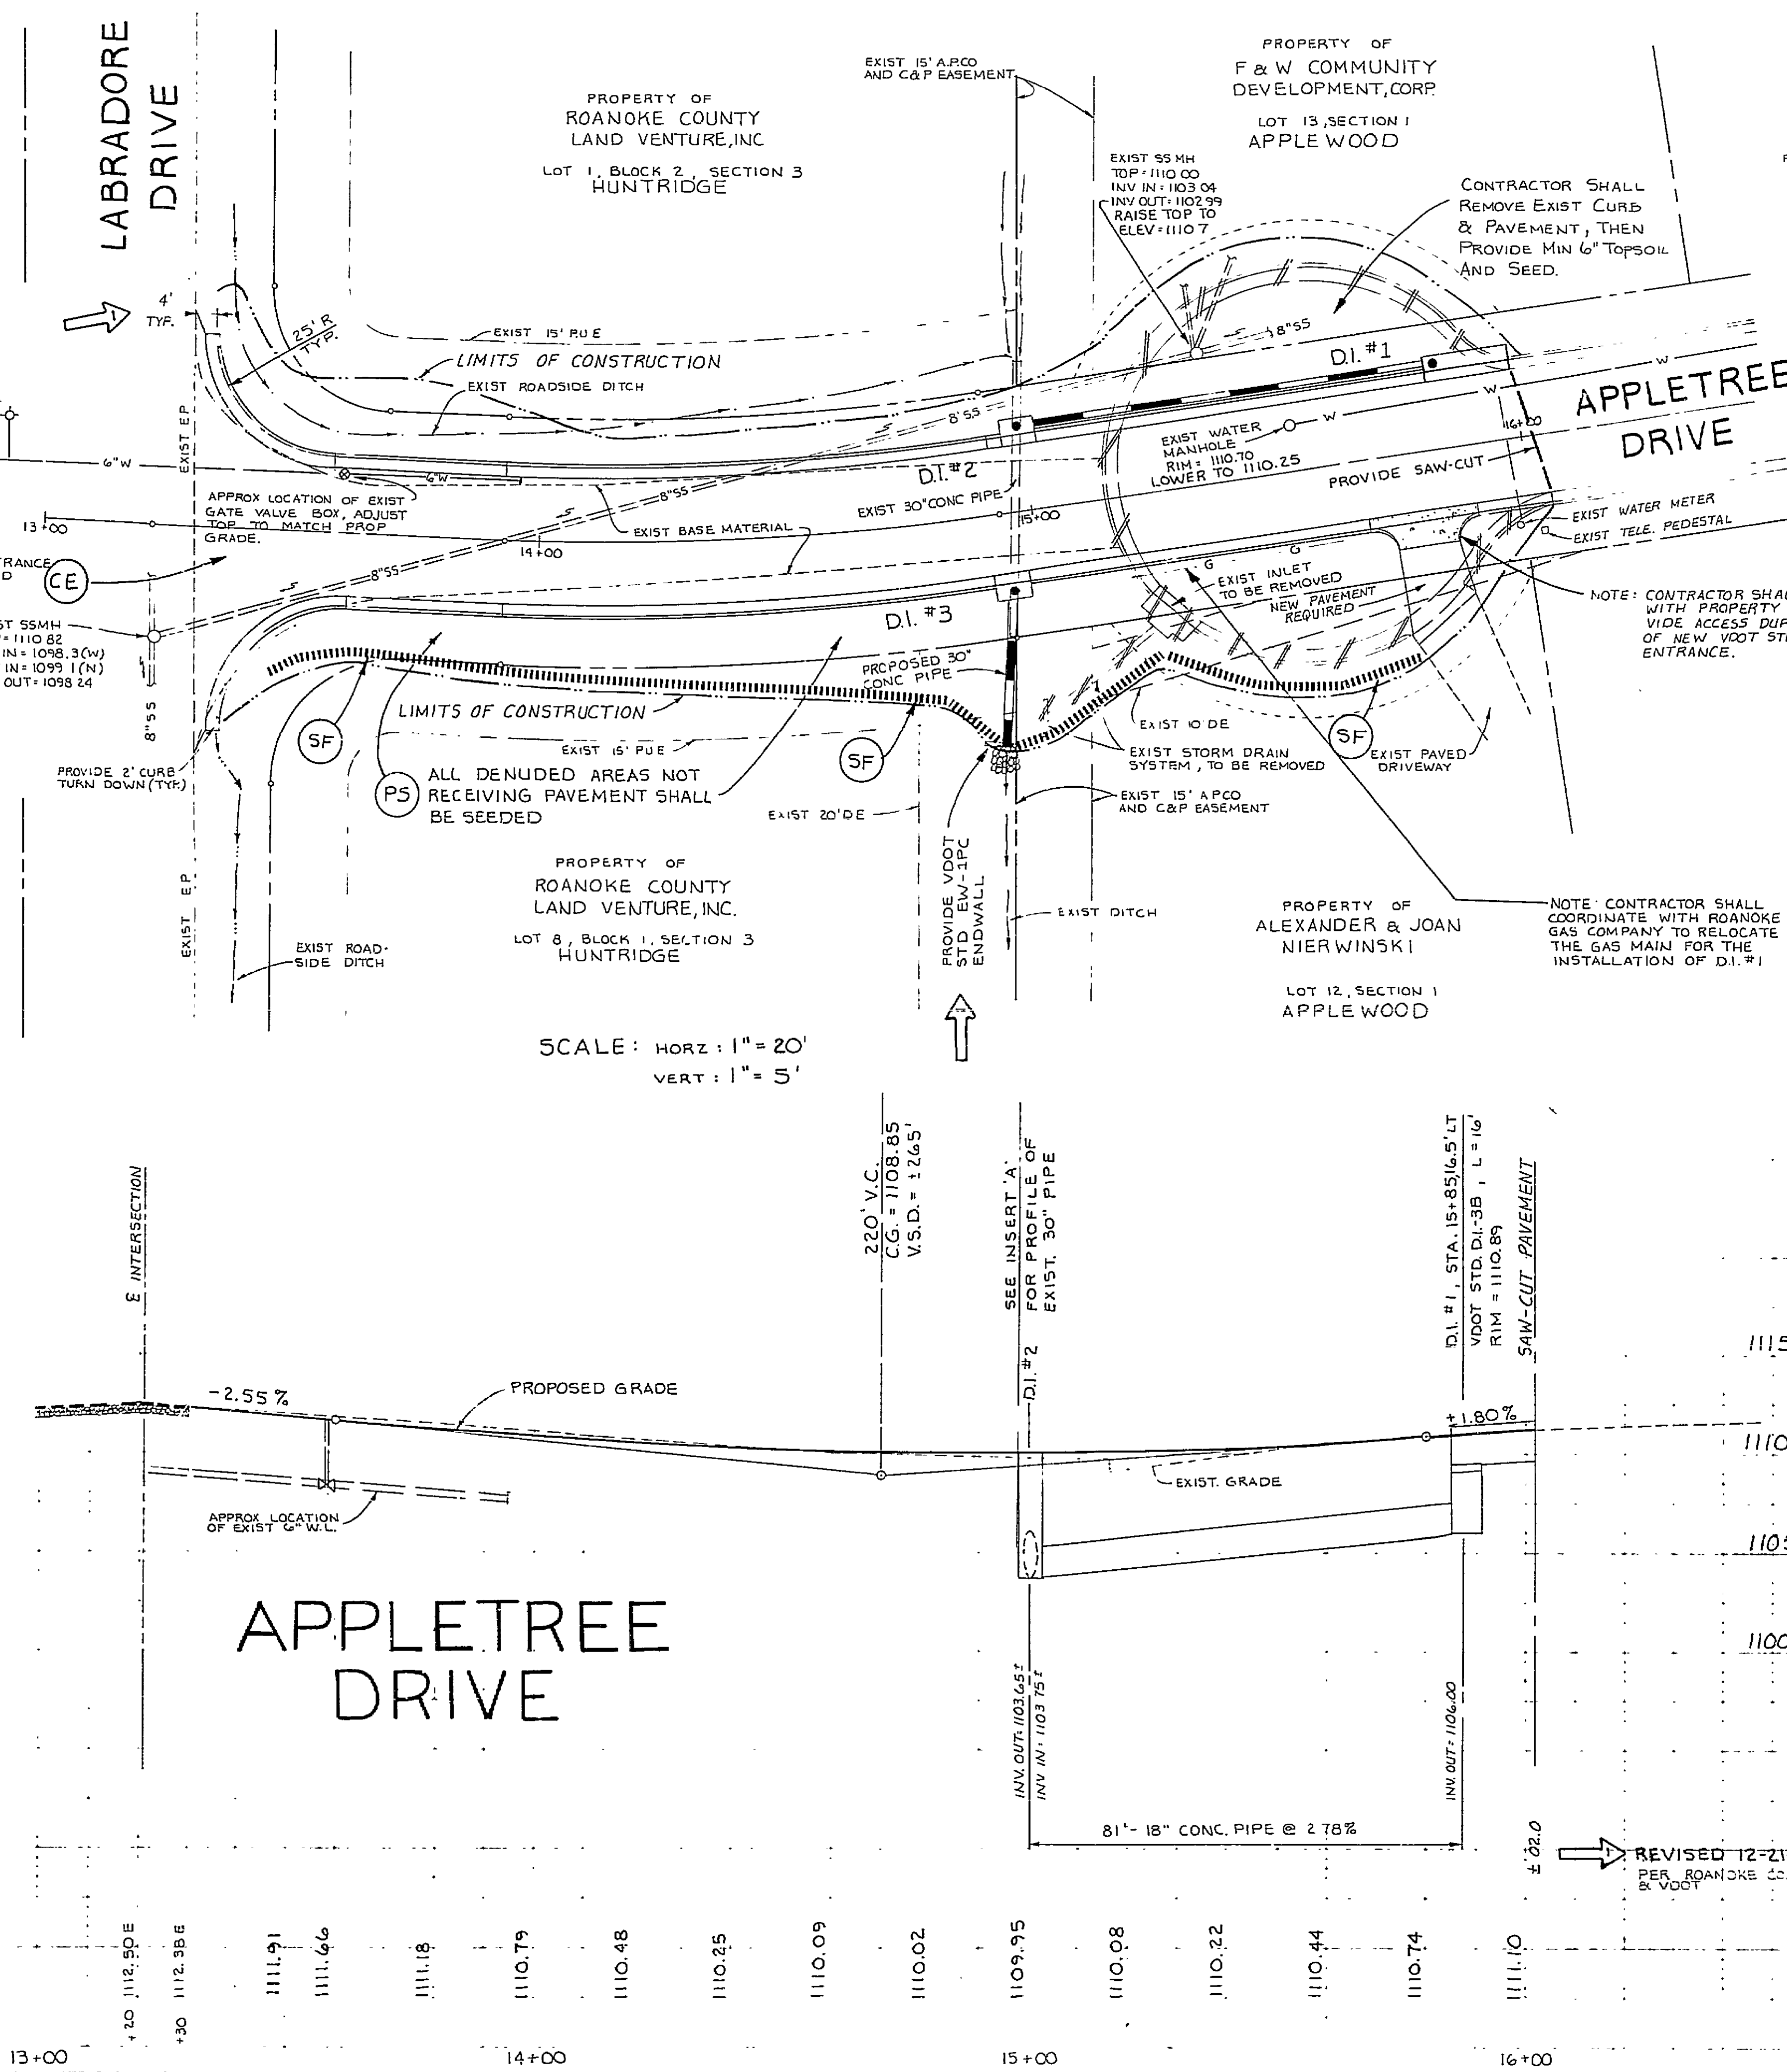

RC-2145A