


FINAL SURVEY	BY	DATE
NO.		

ORIGINAL SURVEY	BY	DATE
NO.		

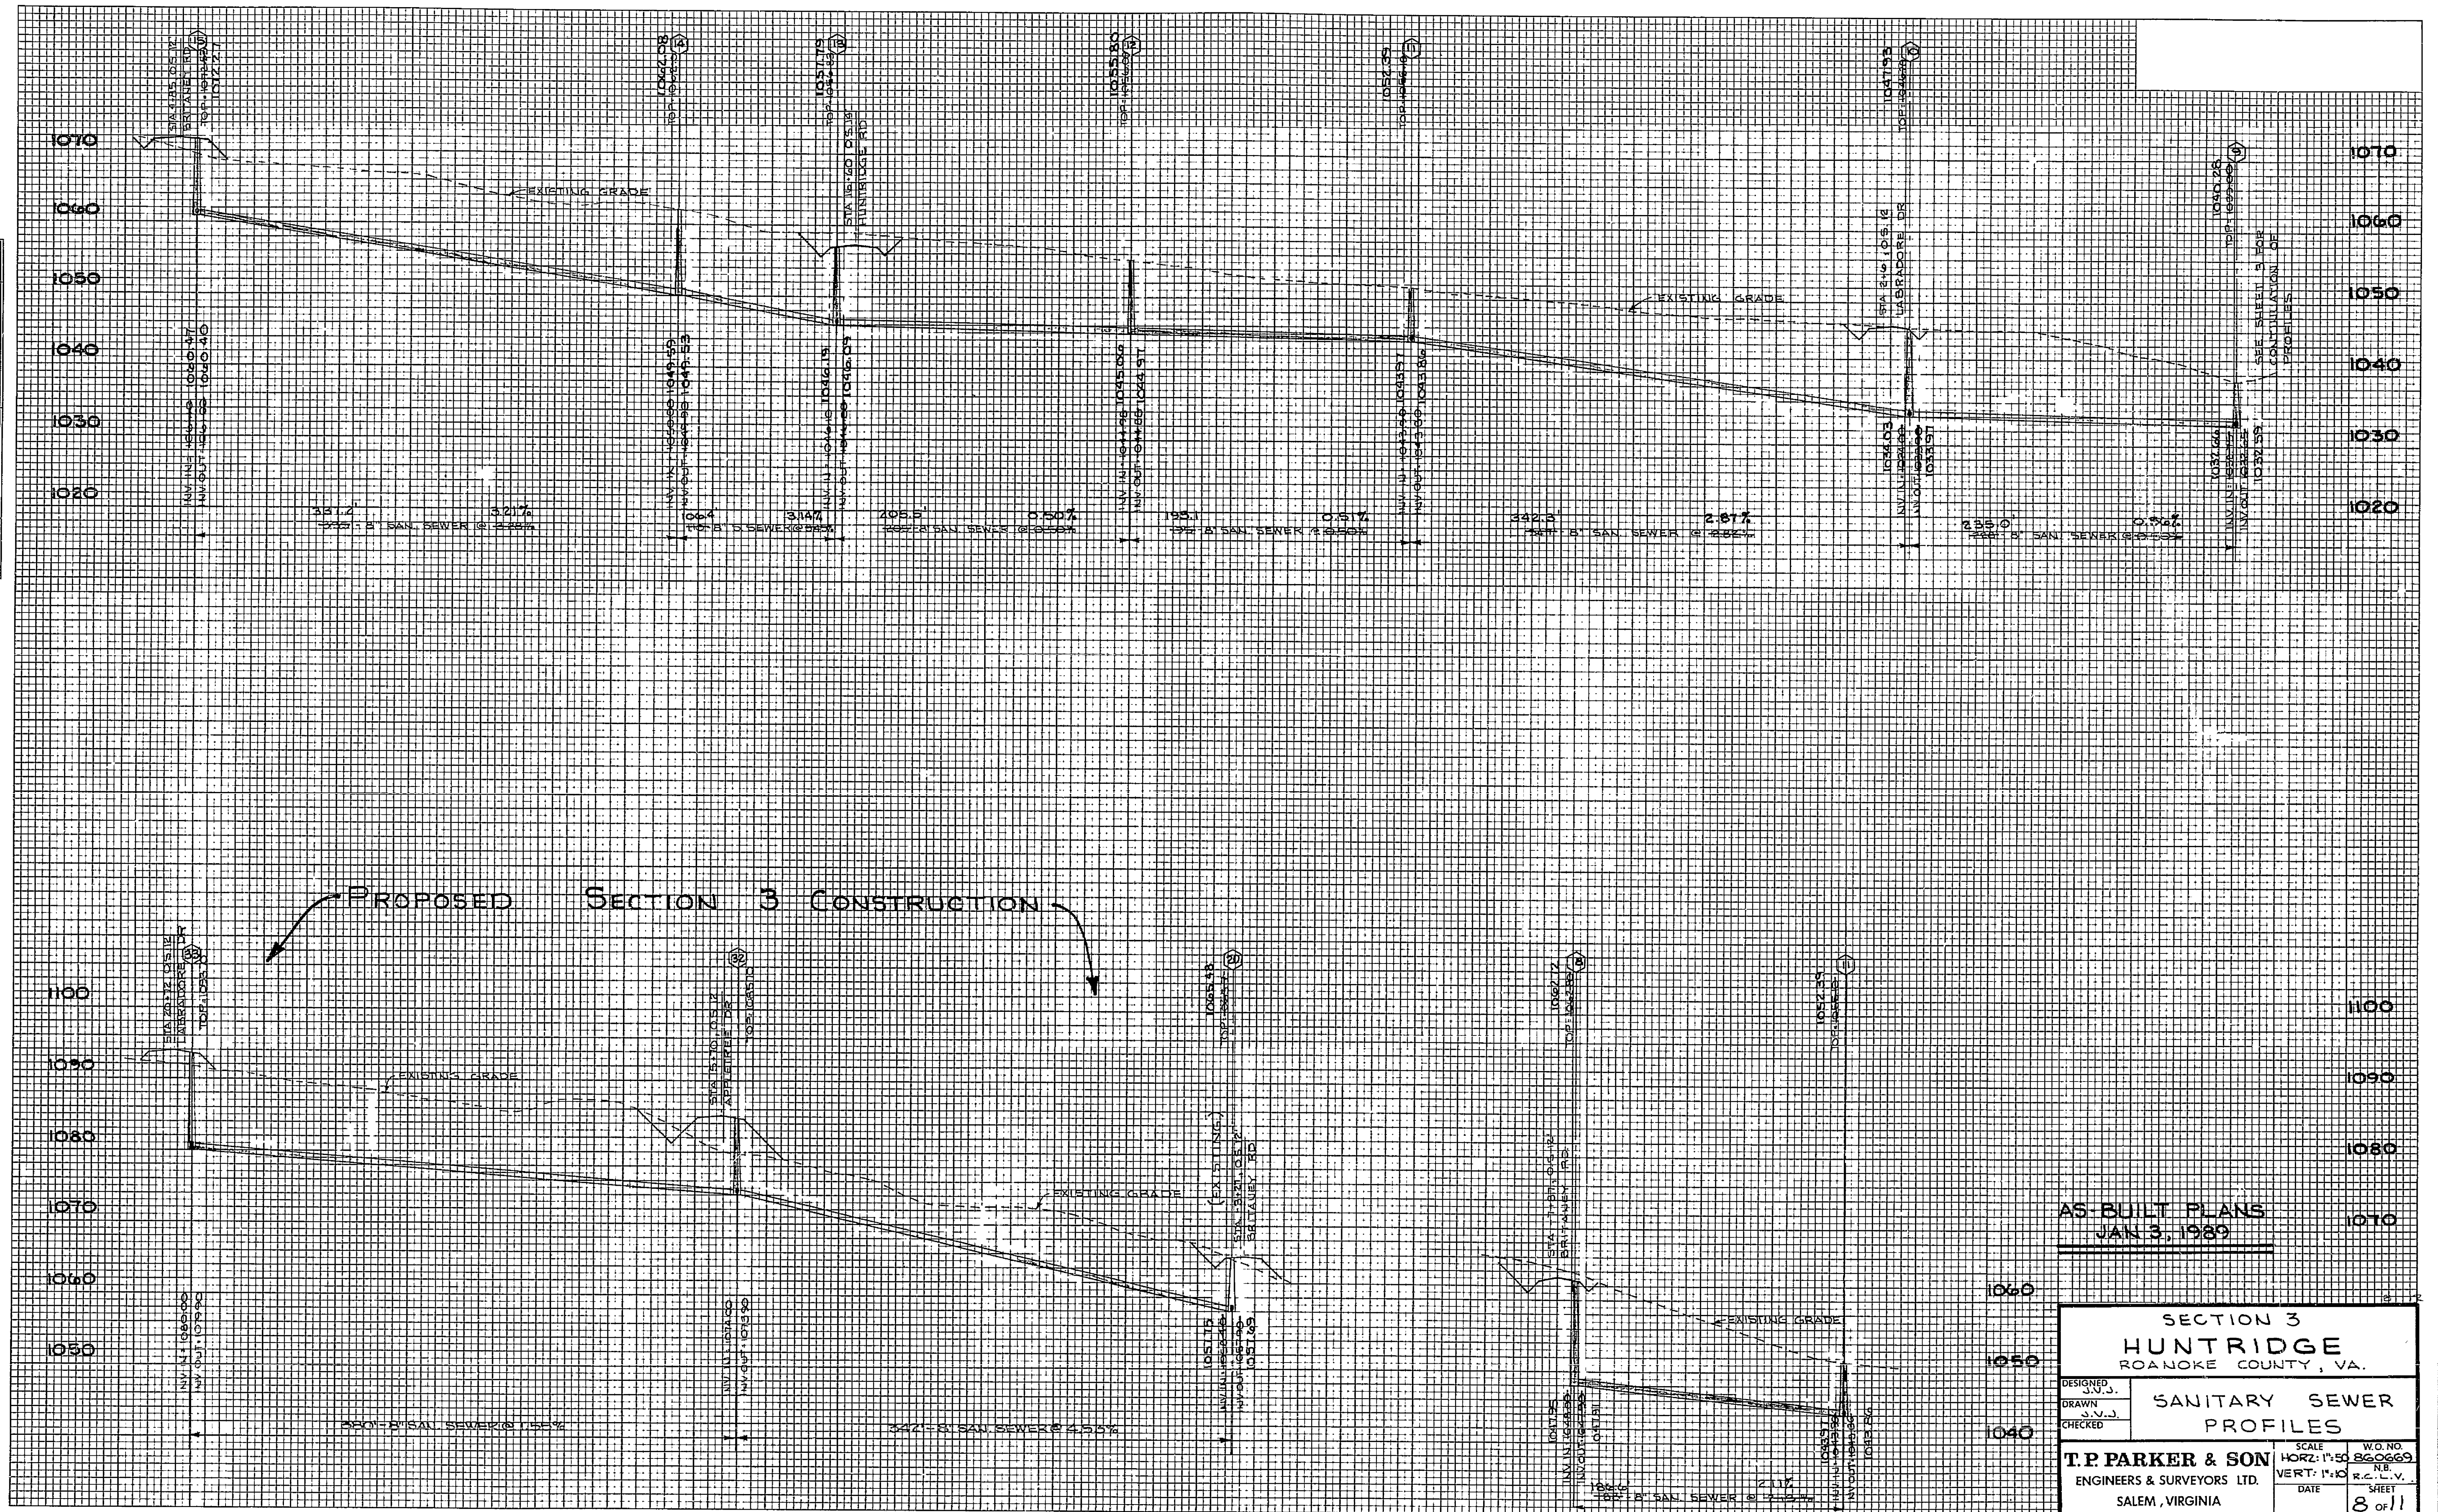

AS BUILT PLANS
JAN 3, 1989

SECTION 3 HUNTRIDGE ROANOKE COUNTY, VA.	
DESIGNED J.V.J.	SCALE HORIZ: 1"=50'
DRAWN J.V.J.	VERT: 1"=10'
CHECKED	DATE
T.P. PARKER & SON ENGINEERS & SURVEYORS LTD. SALEM, VIRGINIA	
W.D. NO. 800669	SHEET 8 of 11

PLATE 3 CROSS SECTION G. P. R. & R. E. STANDARD
BENTON CORPORATION

RC-2147

