



PLAN	DATE
NO. 1	

PROFILE	DATE
NO. 1	

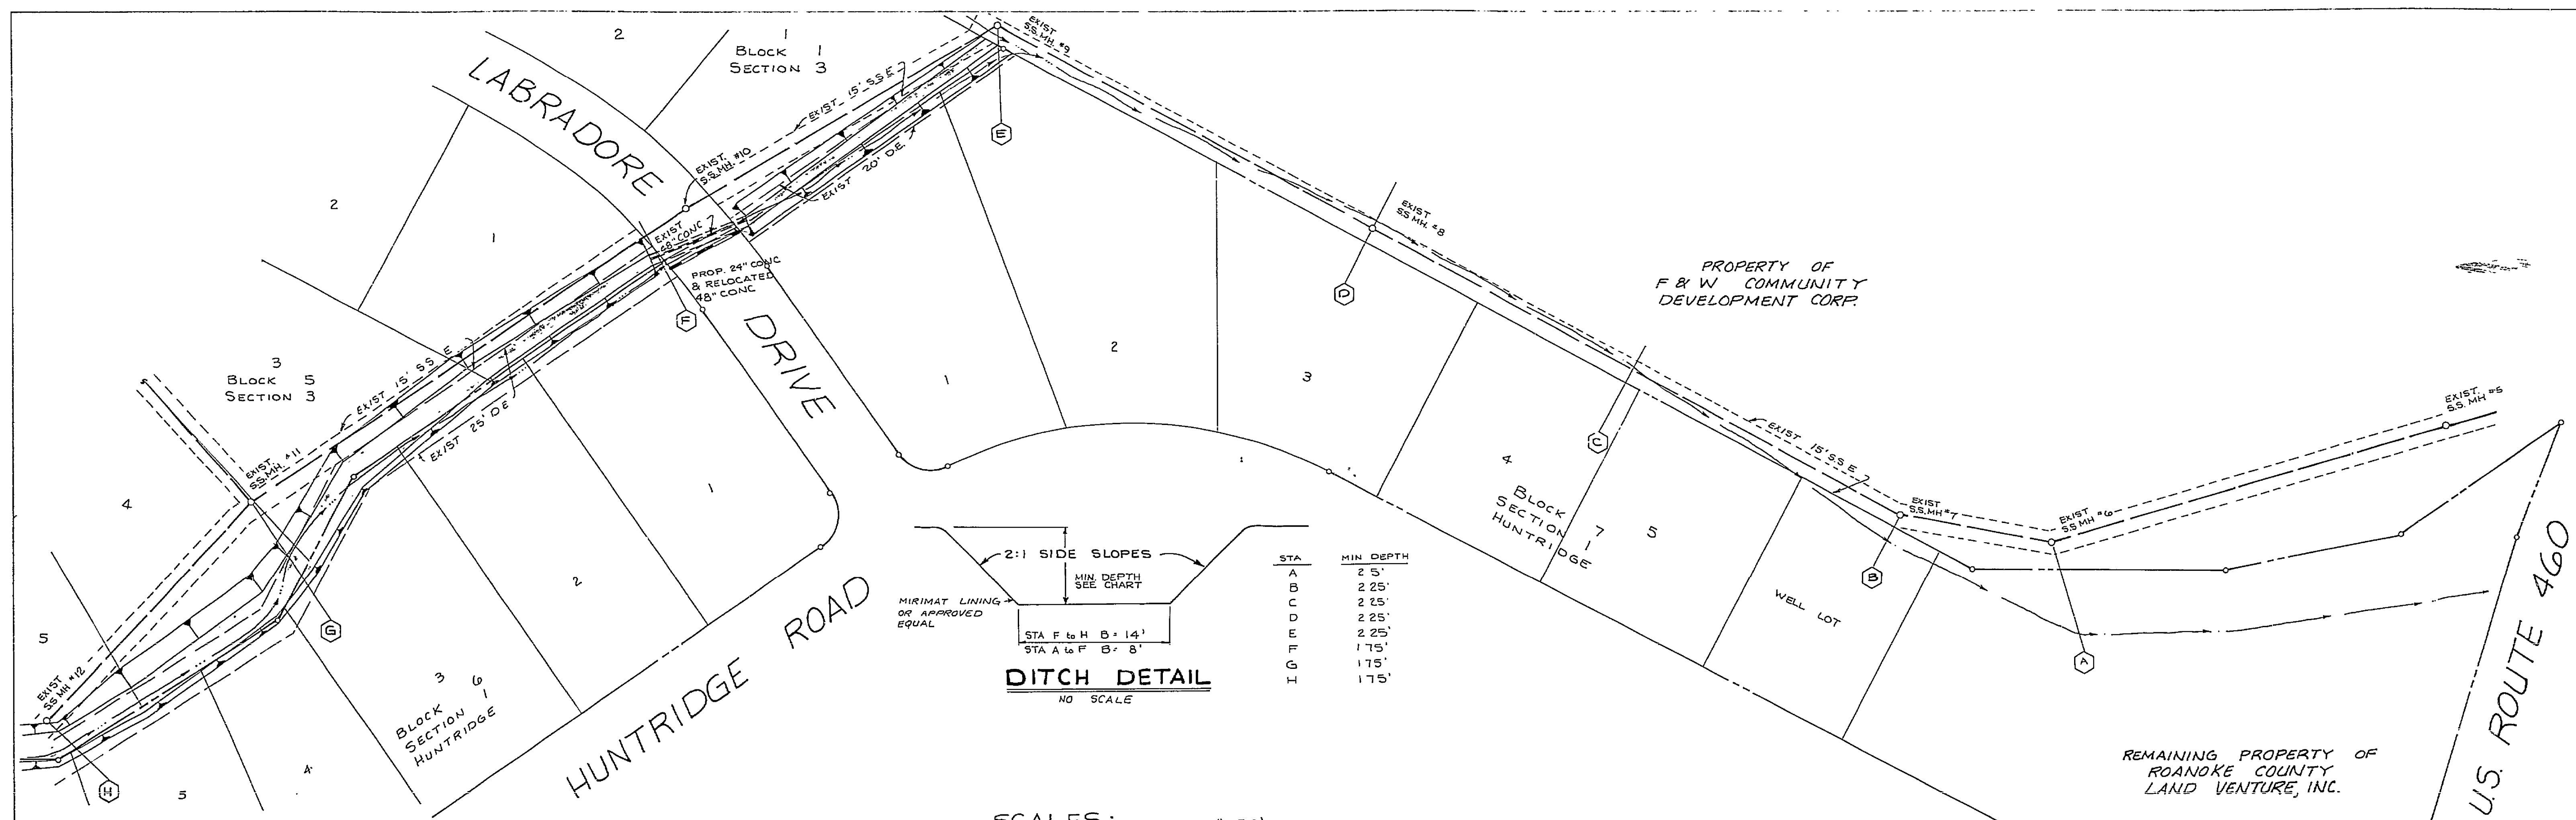

SCALES: HORIZ: 1" = 50'
VERT: 1" = 10'

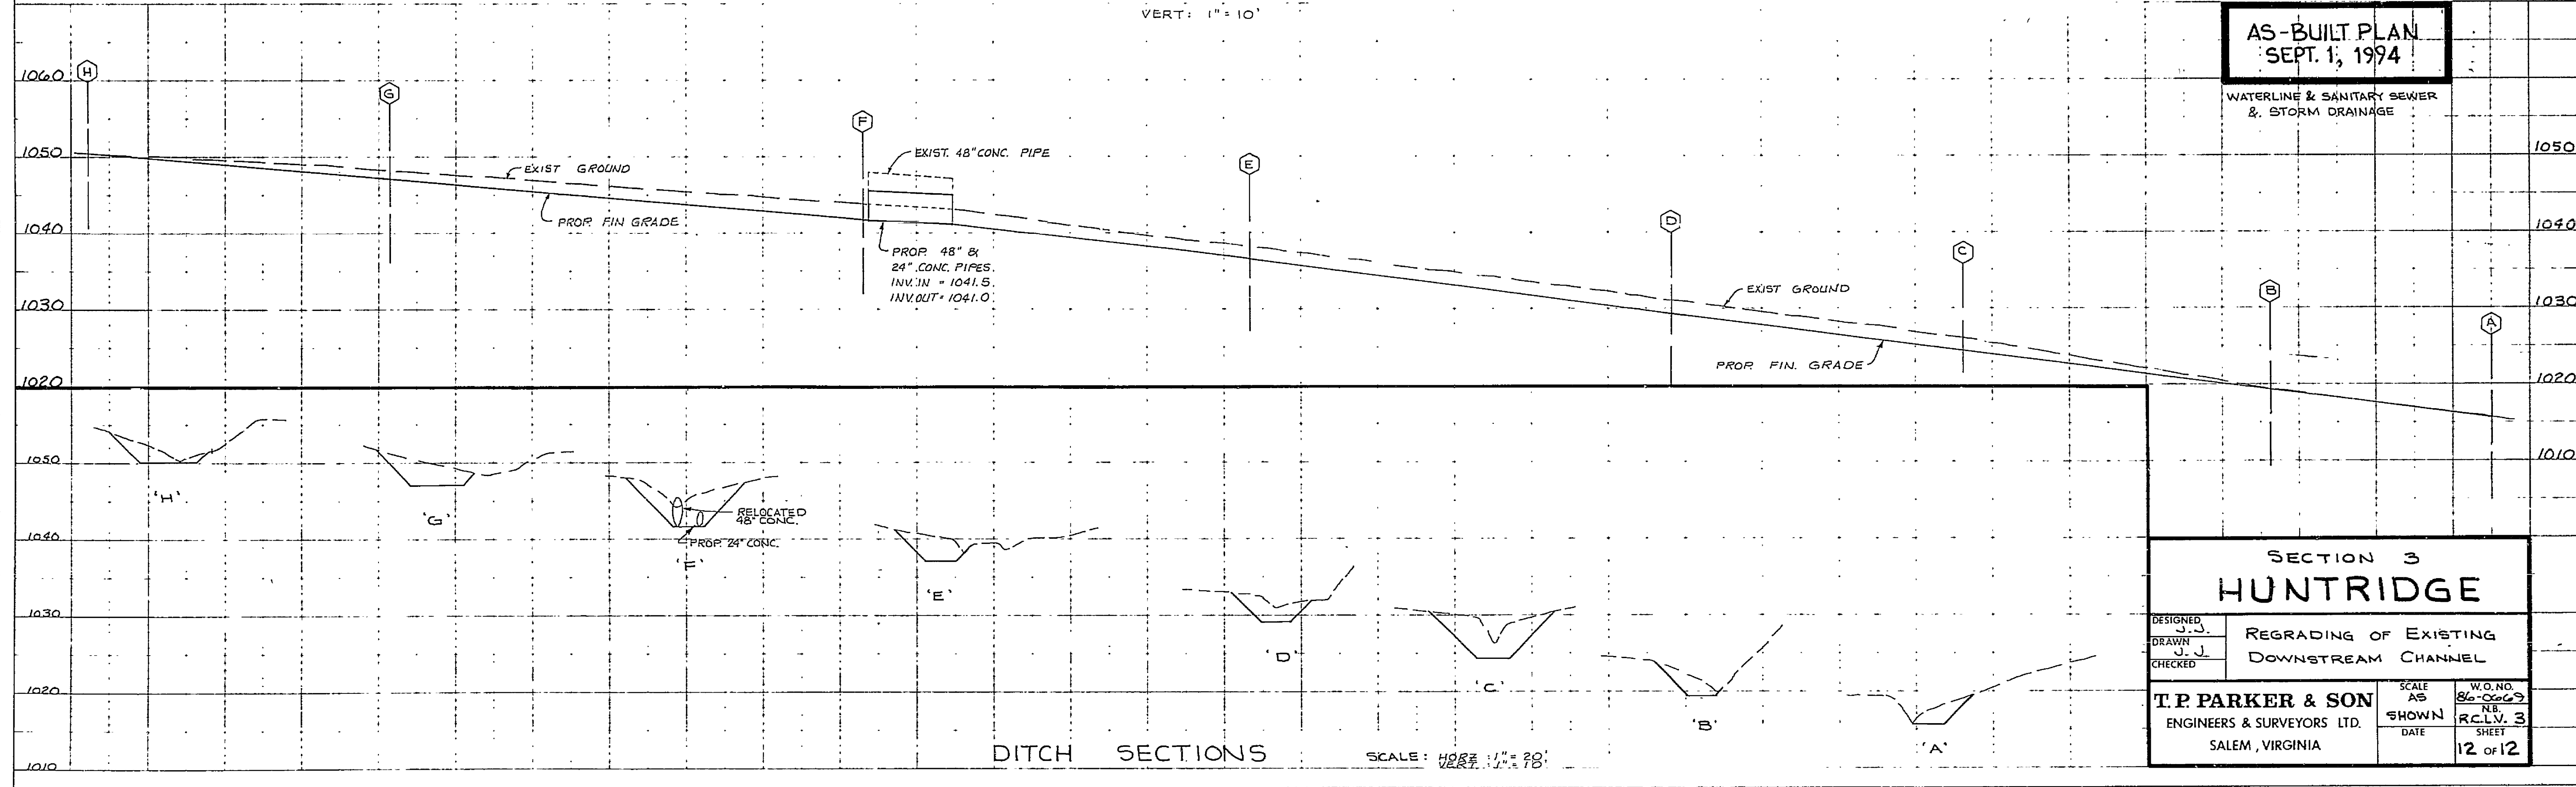

AS-BUILT PLAN
SEPT. 1, 1994

WATERLINE & SANITARY SEWER
& STORM DRAINAGE

SECTION 3
HUNTRIDGE

DESIGNED: J. J.
DRAWN: J. J.
CHECKED: J. J.

T. P. PARKER & SON
ENGINEERS & SURVEYORS LTD.
SALEM, VIRGINIA

SCALE: AS SHOWN
DATE: 12 OF 12

RC-2151