


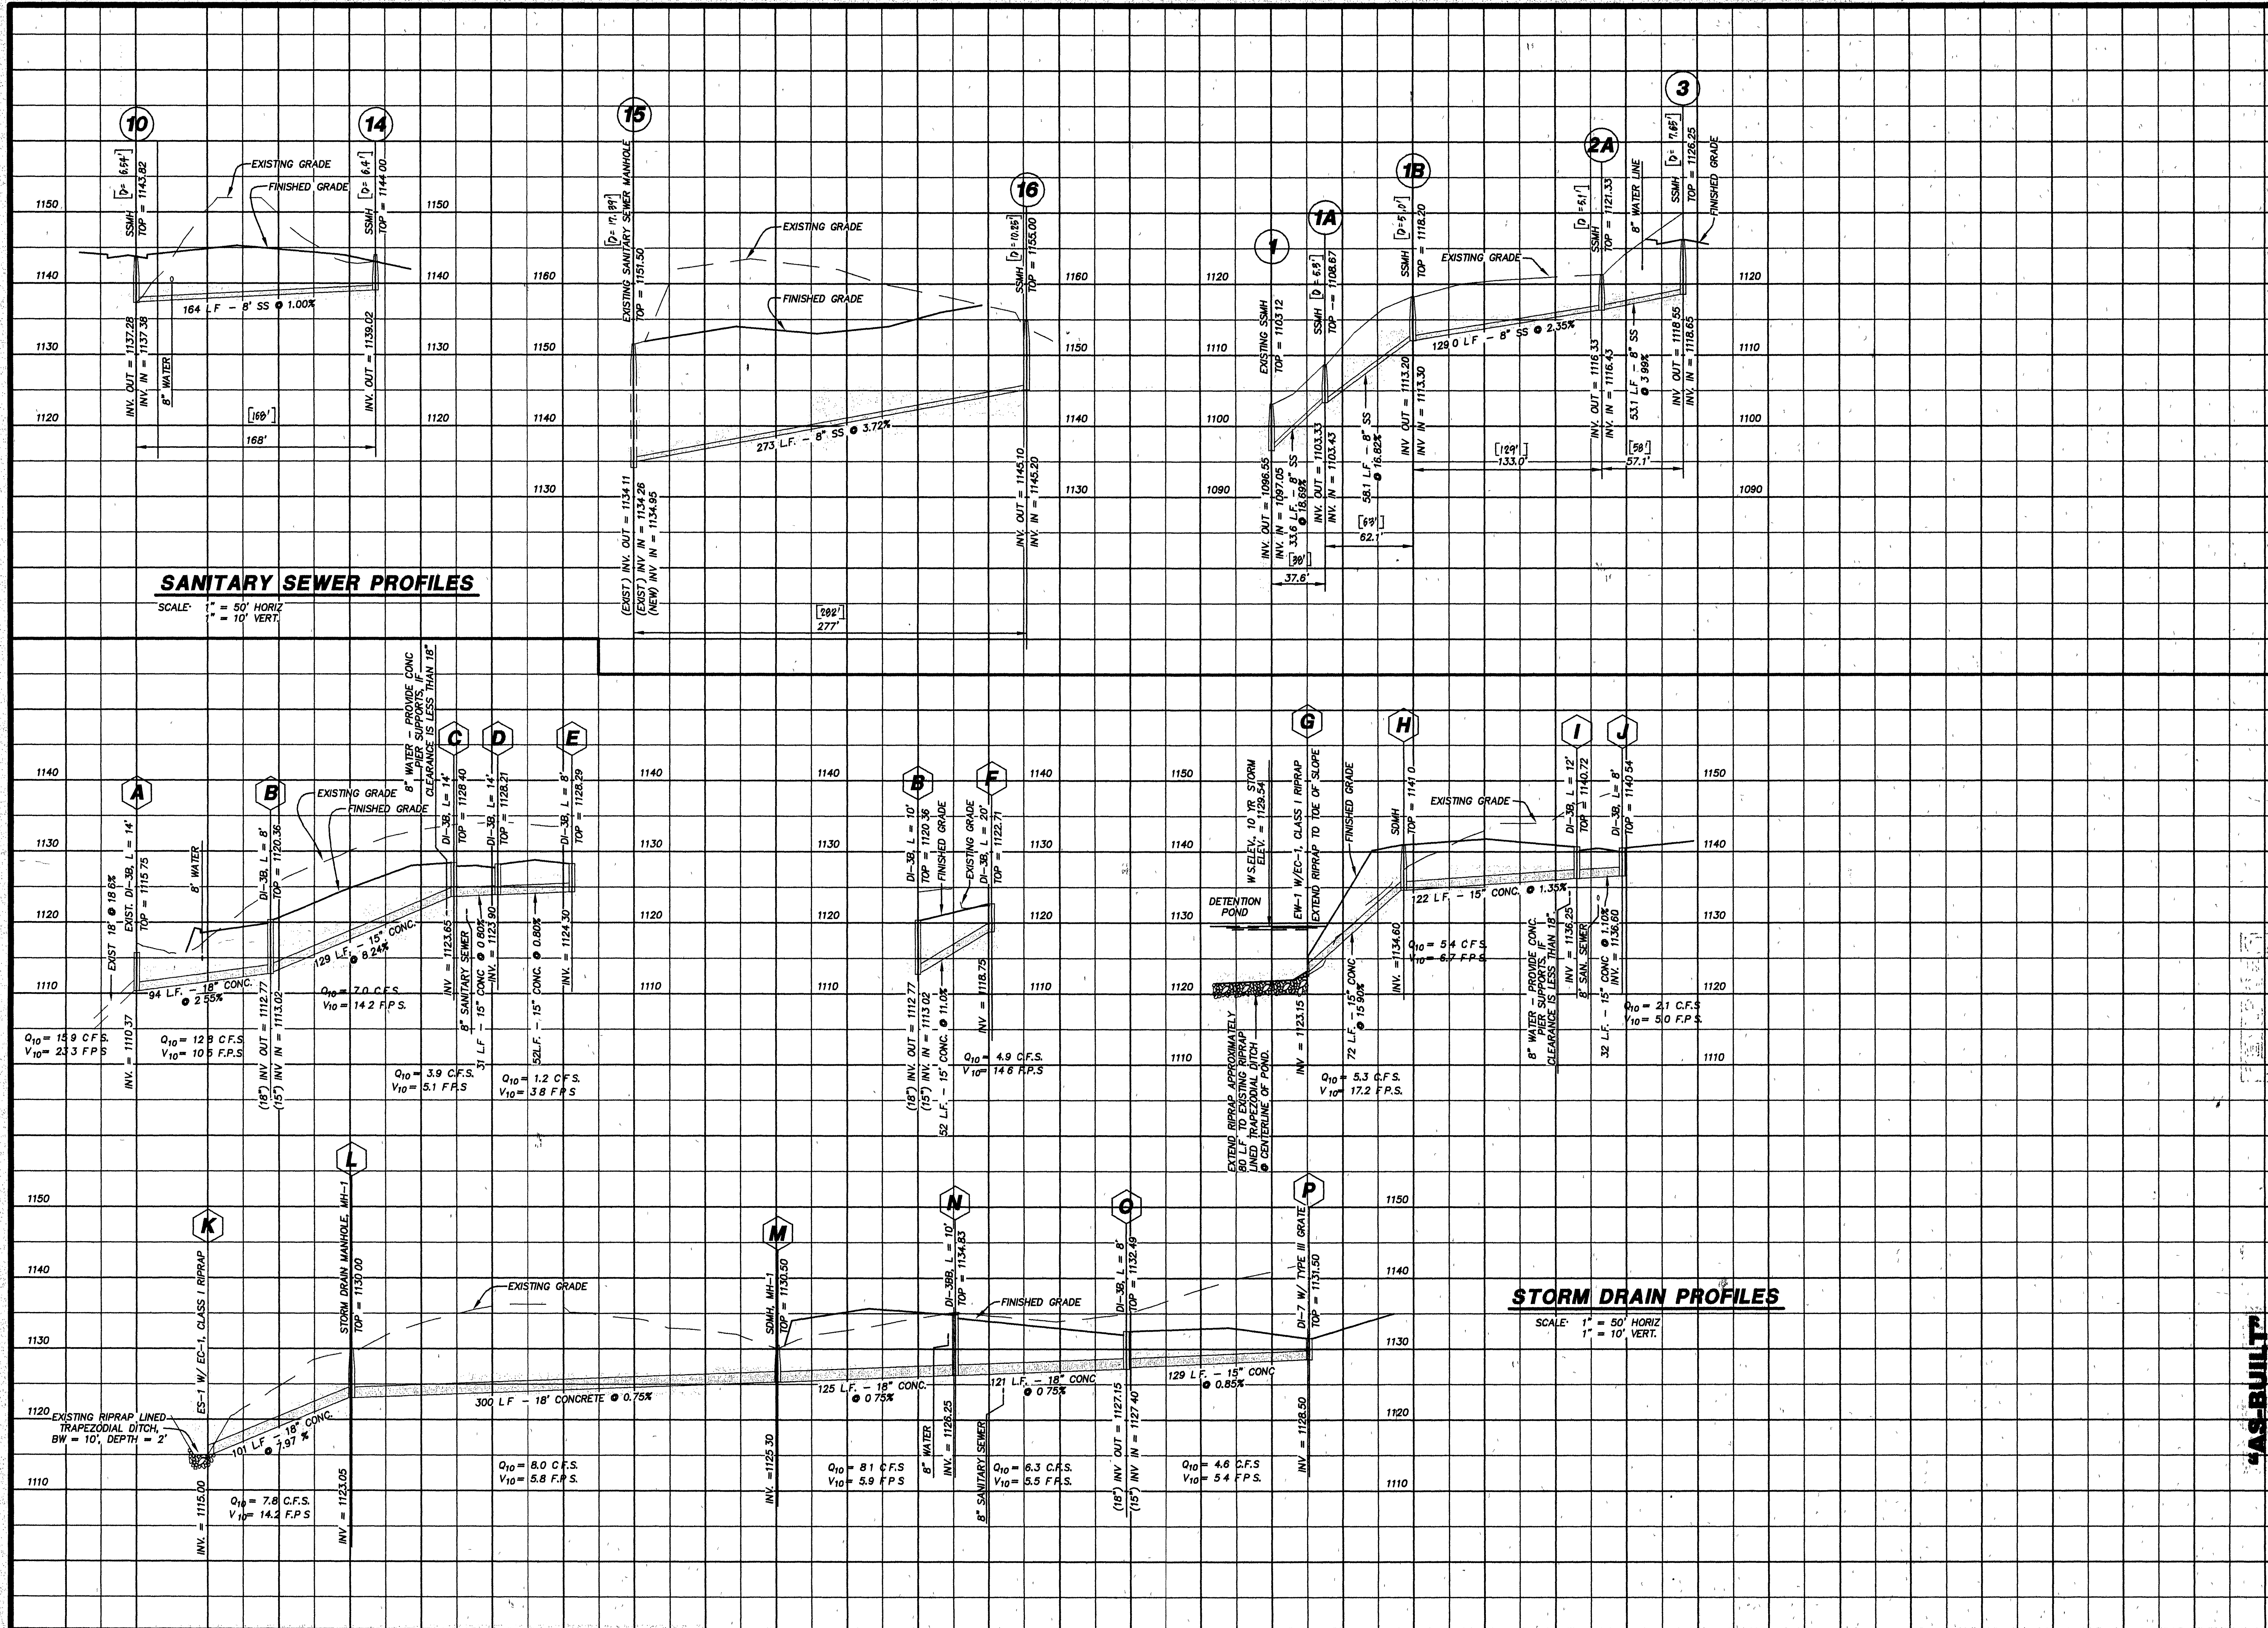

LUMSDEN ASSOCIATES, P.C.
ENGINEERS-SURVEYORS-PLANNERS
ROANOKE, VIRGINIA

PHONE (540) 774-4411
FAX (540) 775-9445
E-MAIL MAIL@LUMSDENPC.COM

Michael S. Webb
No. 012656
8-27-02
PROFESSIONAL ENGINEER

SANITARY SEWER & STORM DRAIN PROFILES

SECTION No. 1
"HUNTRIDGE GROVE"
PREPARED FOR
F. & W. DEVELOPMENT CORPORATION
HOLLINS MAGISTERIAL DISTRICT
ROANOKE COUNTY, VIRGINIA

WWW.ID#80QHJW

NO.	DATE	DESCRIPTION
1	6-24-02	ADDED CONCRETE PER SUPPORTS
2	8-27-02	REVISED SANITARY SEWER MANHOLES 1A & 2A
3	5/06/09	AS-BUILT SANITARY SEWER
4		
5		

DATE: 29 MAY 2002

SCALE: AS SHOWN

COMMISSION NO. 01-138

ADD FILE: P:\2007\0731\ENR\80Q\170138COMP

SHEET 8 OF 10