
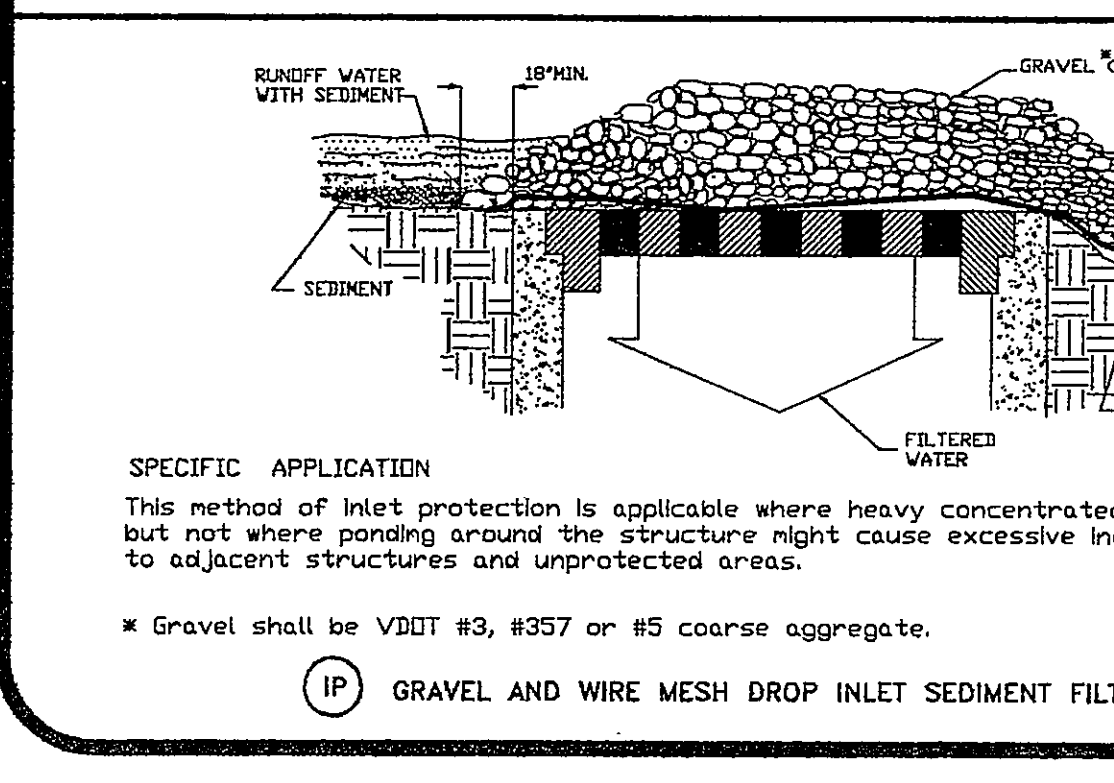
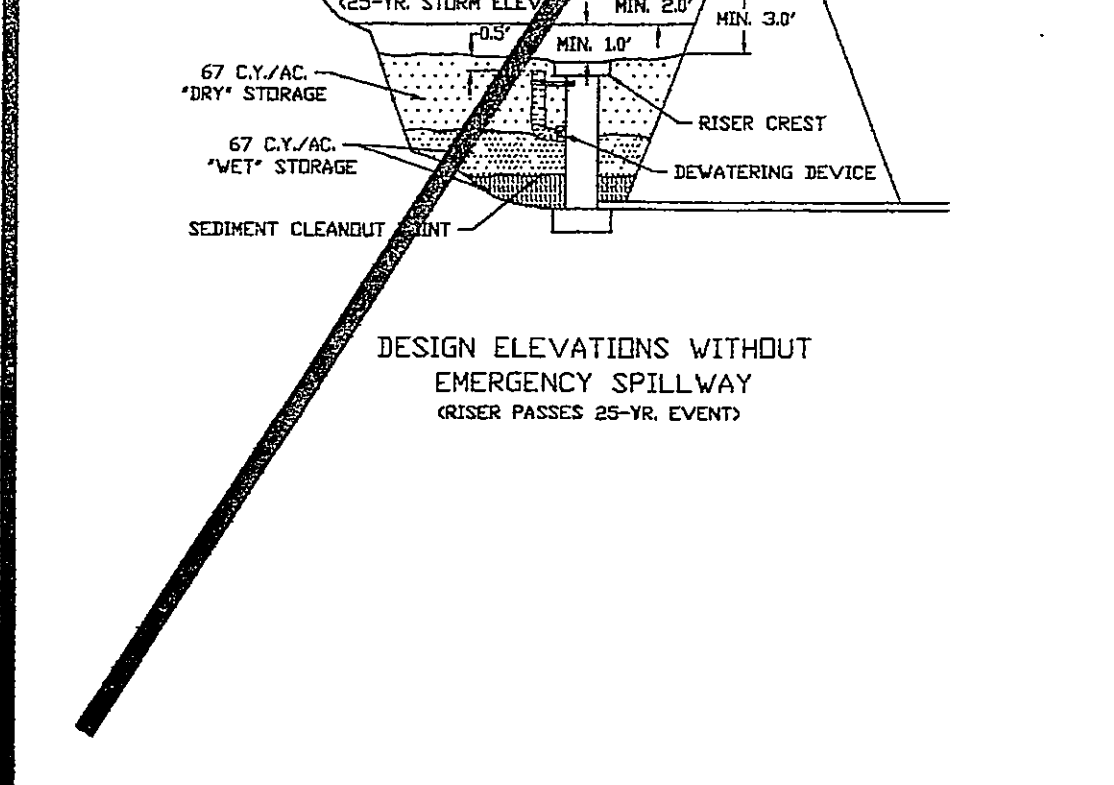


STORMWATER MANAGEMENT COST ESTIMATE. Table with 5 columns: DESCRIPTION, UNIT, QUANTITY, UNIT COST, TOTAL COST. Rows include CLEARING & GRUBBING, EXCAVATION, EMBANKMENT, FENCING, STRUCTURES, ACCESS ROAD, AS-BUILTS, SUB-TOTAL, 10% CONTINGENCY, and TOTAL PROJECT COST.

GENERAL NOTES. 1. DESIGN OF DETENTION BASINS SHALL CONFORM TO THE REQUIREMENTS OF THE COUNTY OF ROANOKE DRAINAGE STANDARDS (REF. SECTIONS 503.02, 503.03, AND 503.02). 2. ACCESS TO THE FACILITY MUST BE PROVIDED IN ACCORDANCE WITH THE COUNTY OF ROANOKE DESIGN AND CONSTRUCTION STANDARDS FOR DETENTION PONDS, LATEST EDITION. 3. IF THE FACILITY IS OVER FOUR (4) FEET DEEP, TAKES OVER TWO (2) HOURS TO DRAIN, OR THE INTERIOR SLOPE EXCEEDS 3 (3) H (V), PERMANENT FENCING MAY BE REQUIRED. 4. DETENTION PONDS SHALL BE BUILT IN ACCORDANCE WITH THE ROANOKE COUNTY BONDING POLICY FOR SUBDIVISION AND SITE DEVELOPMENT. 5. REFERENCE THE COUNTY OF ROANOKE DESIGN AND CONSTRUCTION STANDARDS FOR DETENTION PONDS, LATEST EDITION, FOR ACCEPTANCE AND MAINTENANCE OF THE FACILITY. CERTIFIED AS-BUILTS ARE REQUIRED AND MUST INCLUDE:

DETENTION BASIN, STORM DRAIN INLETS & PIPING, & PERMANANT VEGETATIVE IN PLACE VIA PREVIOUS CONSTRUCTION

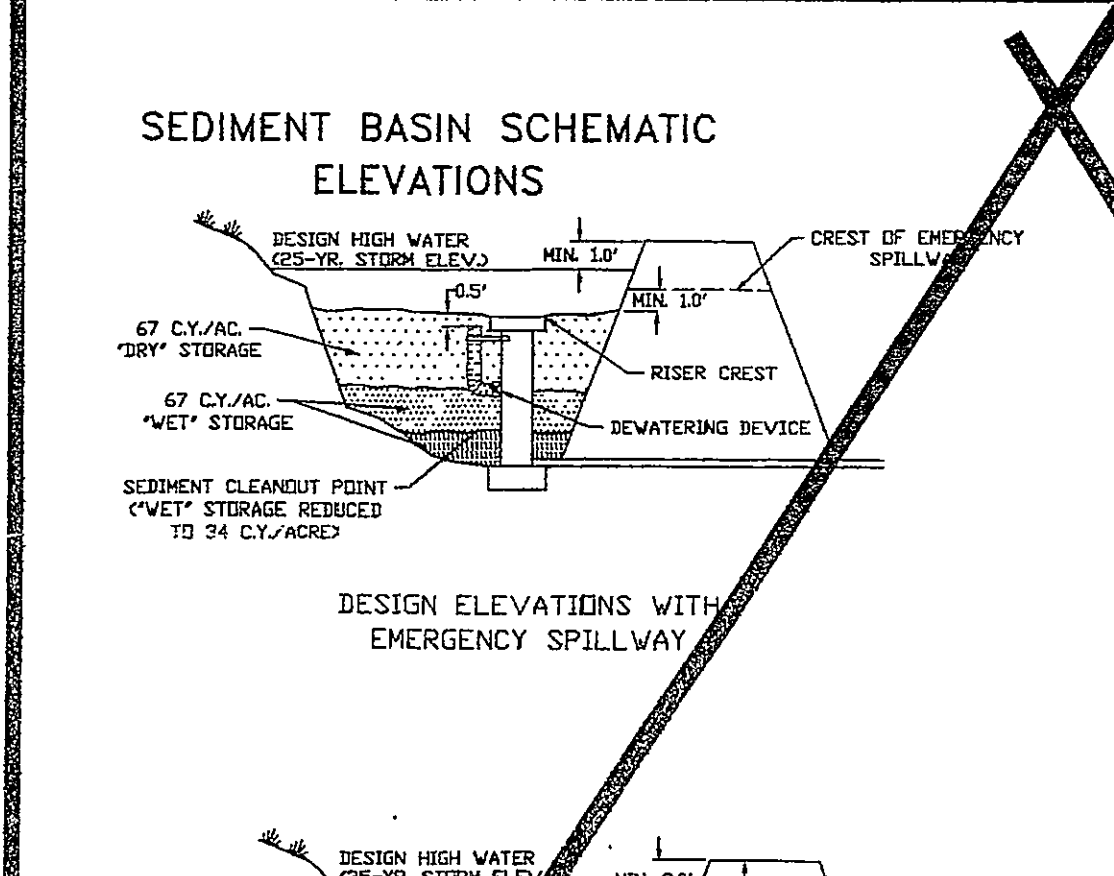

CONSTRUCTION NOTES. 1. SITE PREPARATION SHALL BE IN ACCORDANCE WITH THE COUNTY OF ROANOKE DESIGN AND CONSTRUCTION STANDARDS FOR DETENTION PONDS, LATEST EDITION. 2. SLOPES STEEPER THAN 3 TO 1 (HORIZONTAL TO VERTICAL) SHALL BE BENCH OR STEPPED PRIOR TO PLACING FILL ON THEM. 3. SITE FILL MATERIAL OR BORROW FILL MATERIAL MAY BE UTILIZED. 4. FILL MATERIAL SHALL BE COMPACTABLE. 5. FILL SHALL BE WITHIN AN ACCEPTABLE RANGE OF MOISTURE CONTENT WHICH IS READILY CONTROLLED. 6. FILL MATERIAL CONTAINING ROCKS LARGER THAN SIX (6) INCHES (152 CM) SHALL NOT BE USED. 7. THE APPROVED FILL SHALL BE PLACED IN EIGHT (8) INCH (20 CM) LIFT LIFTS. 8. EMBANKMENT MATERIAL IN FILL AREAS SHALL BE PLACED IN LIFTS NOT EXCEEDING EIGHT (8) INCHES AND SHALL BE COMPACTED TO A MINIMUM 92% DENSITY. 9. FIELD DENSITY TESTS ARE TO BE CONDUCTED BY AN INDEPENDENT SOILS TESTING LABORATORY. 10. THE MINIMUM SLOPE OF THE BASIN FLOOR SHALL BE ONE (1) PERCENT GRADED TO DRAIN TO THE PRINCIPAL SPILLWAY.










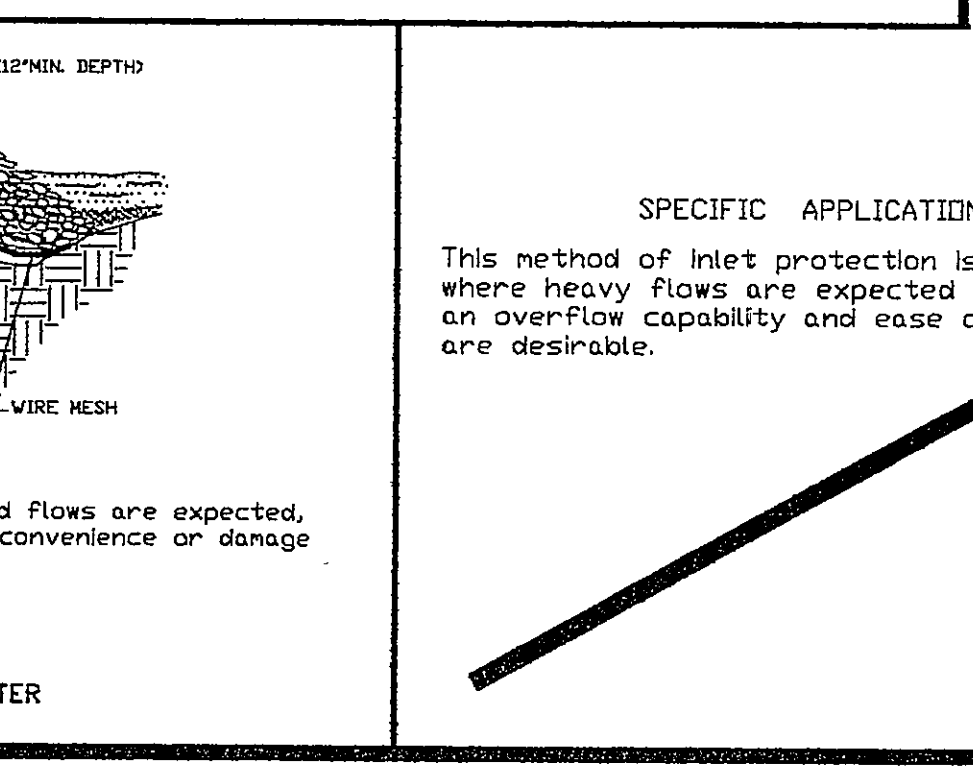


Table with 4 columns: NO., TITLE, KEY, SYMBOL. Rows include SAFETY FENCE, TEMPORARY GRAVEL CONSTRUCTION ENTRANCE, STRAW BALE BARRIER, SILT FENCE, BRUSH BARRIER, STORM DRAIN INLET PROTECTION, CULVERT INLET PROTECTION, TEMPORARY DIVERSION DIKE, TEMPORARY FILL DIVERSION, TEMPORARY RIGHT-OF-WAY DIVERSION, DIVERSION, TEMPORARY SEDIMENT TRAP, TEMPORARY SEDIMENT BASIN, TEMPORARY SLOPE DRAIN, PAVED FLUME, STORMWATER CONVEYANCE CHANNEL, OUTLET PROTECTION, RIPRAP, ROCK CHECK DAMS, LEVEL SPREADER, VEGETATIVE STREAMBANK STABILIZATION, STRUCTURAL STREAMBANK STABILIZATION, TEMPORARY VEHICULAR STREAM CROSSING, UTILITY STREAM CROSSING, DEWATERING STRUCTURE, TURBIDITY CURTAIN, SUBSURFACE DRAIN, SURFACE ROUGHENING, TOPSOILING, TEMPORARY SEEDING, PERMANENT SEEDING, SODDING, BERMUDA GRASS AND ZOYSIAURASS ESTABLISHMENT, MULCHING, SOIL STABILIZATION, BLANKETS AND MATTING, TREES, SHRUBS, VINES AND GROUND COVERS, TREE PRESERVATION AND PROTECTION, DUST CONTROL.

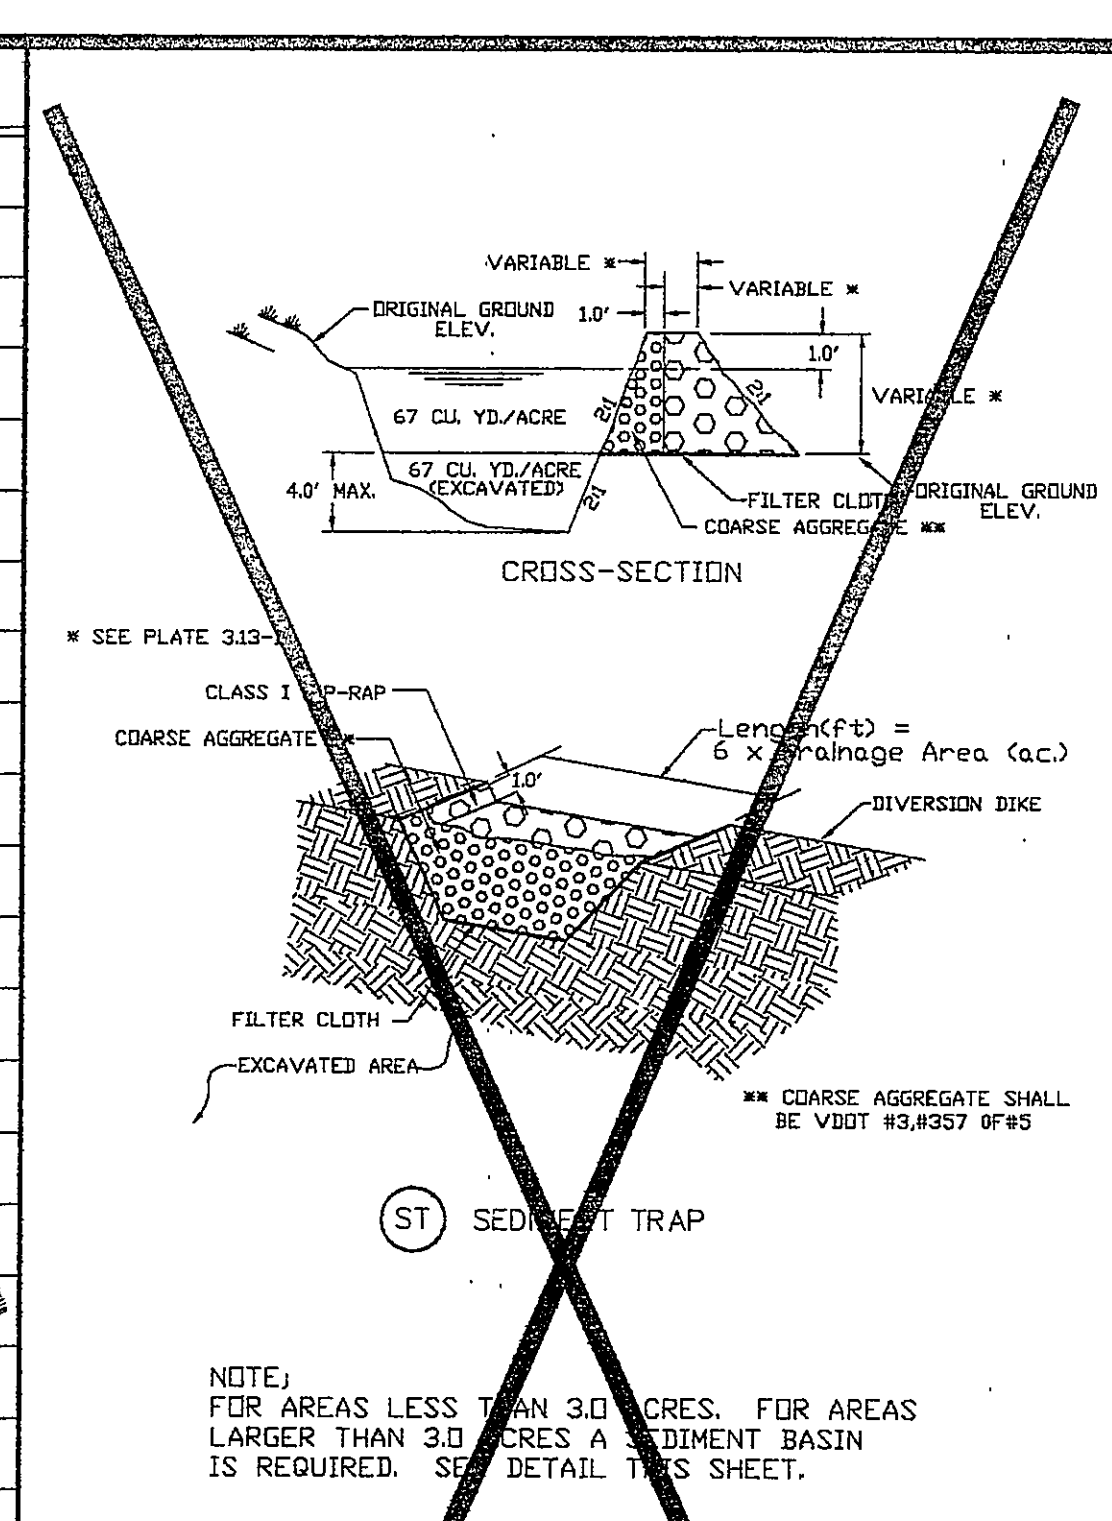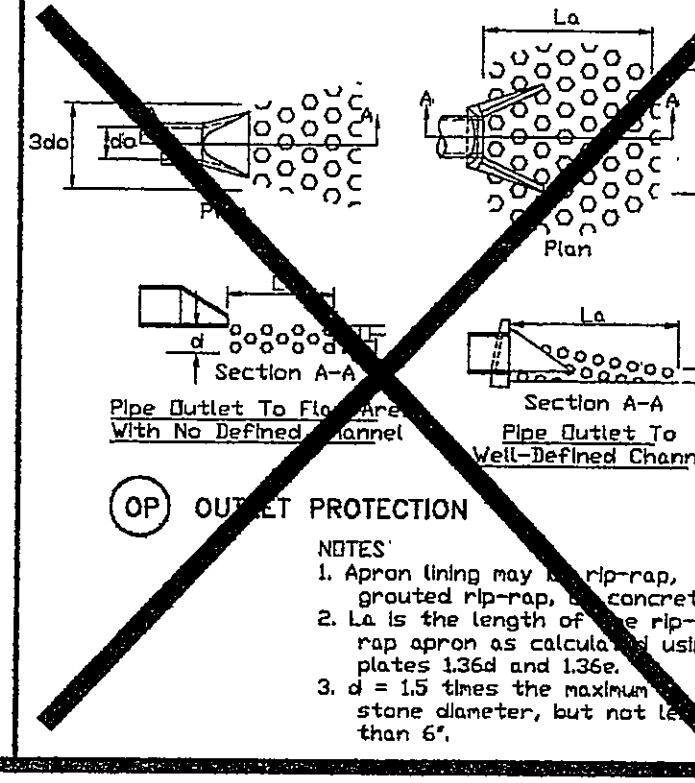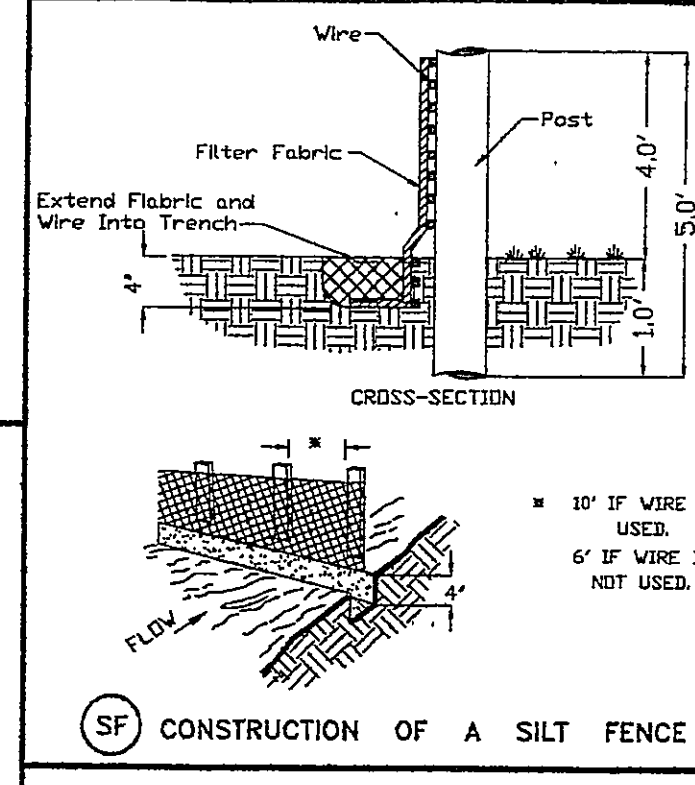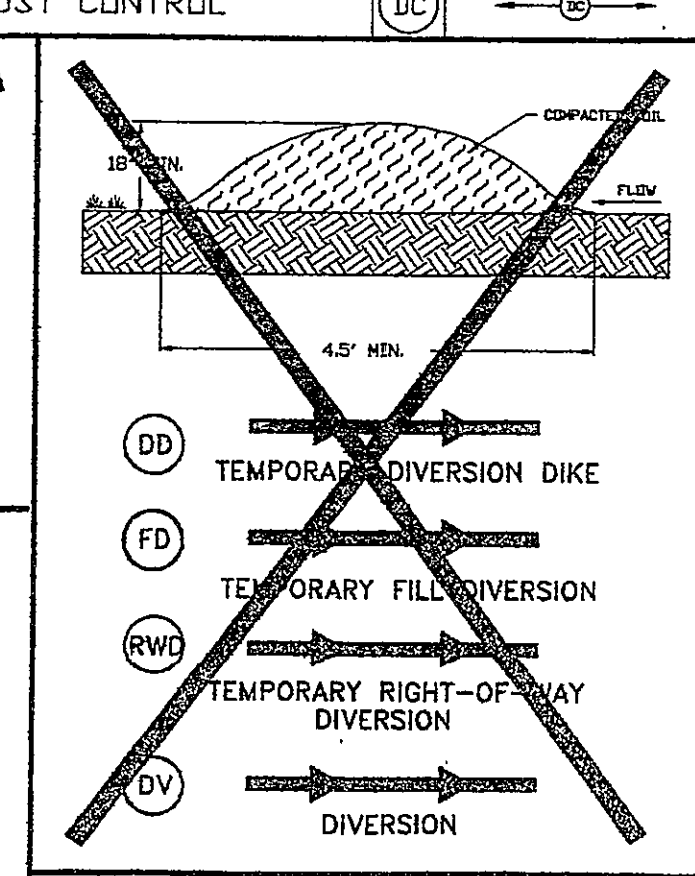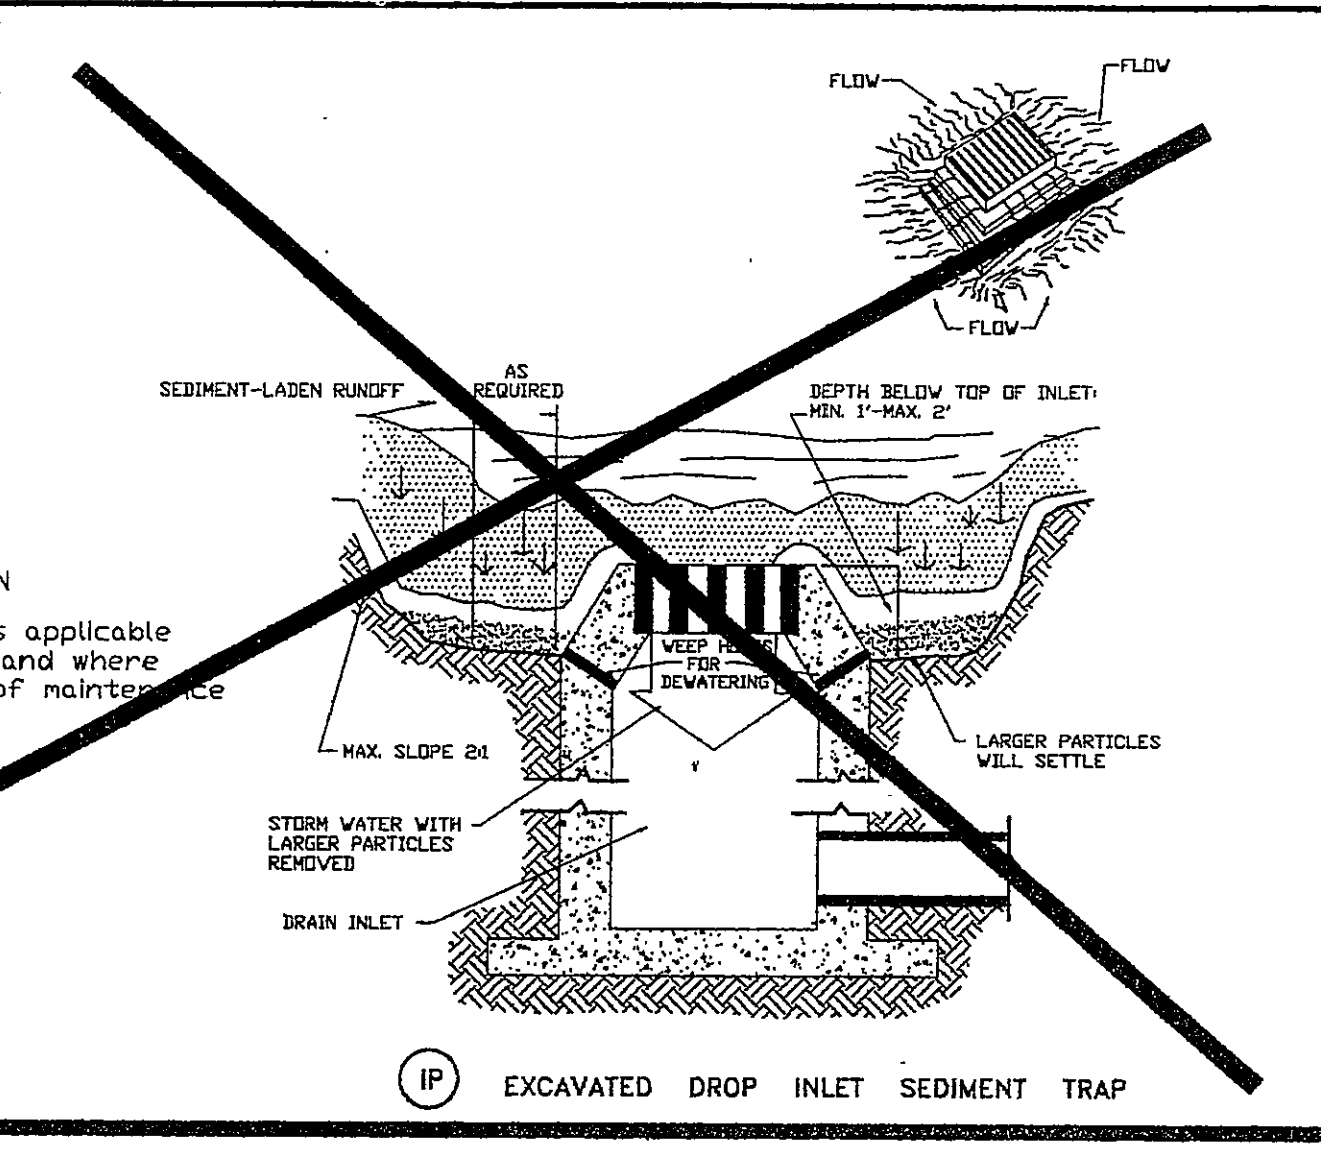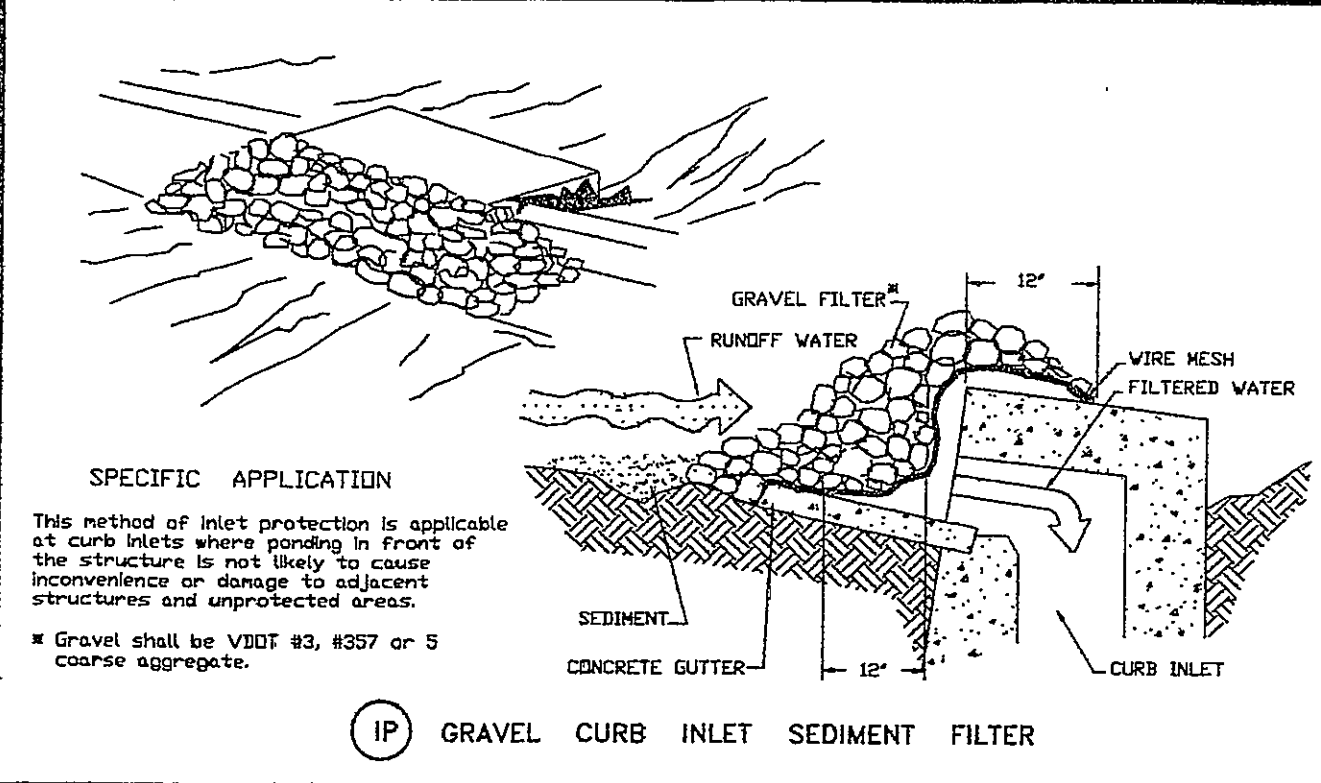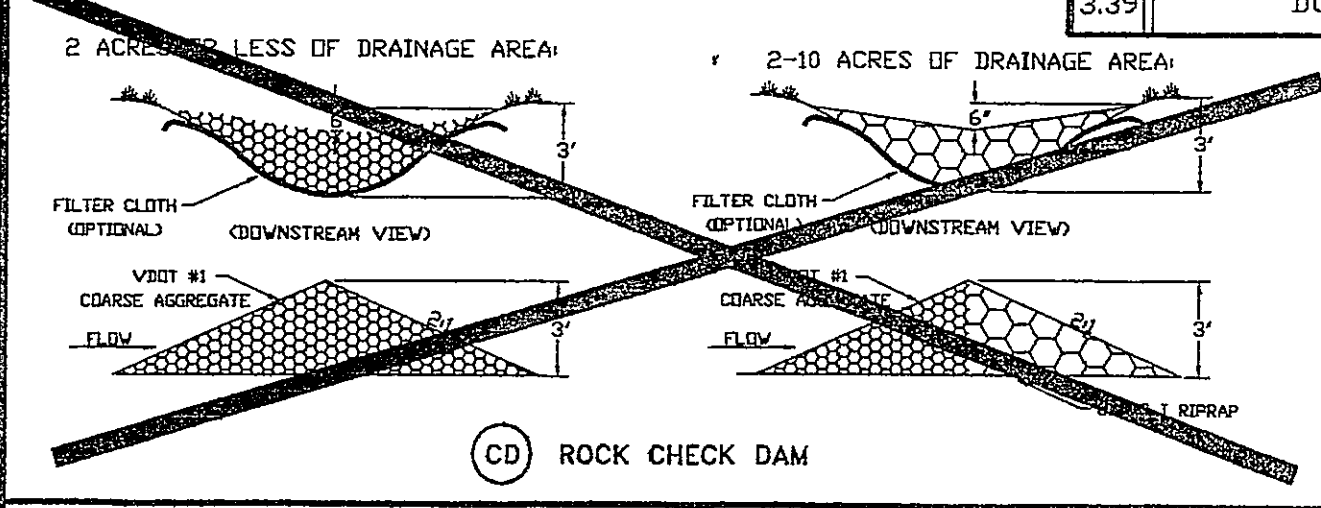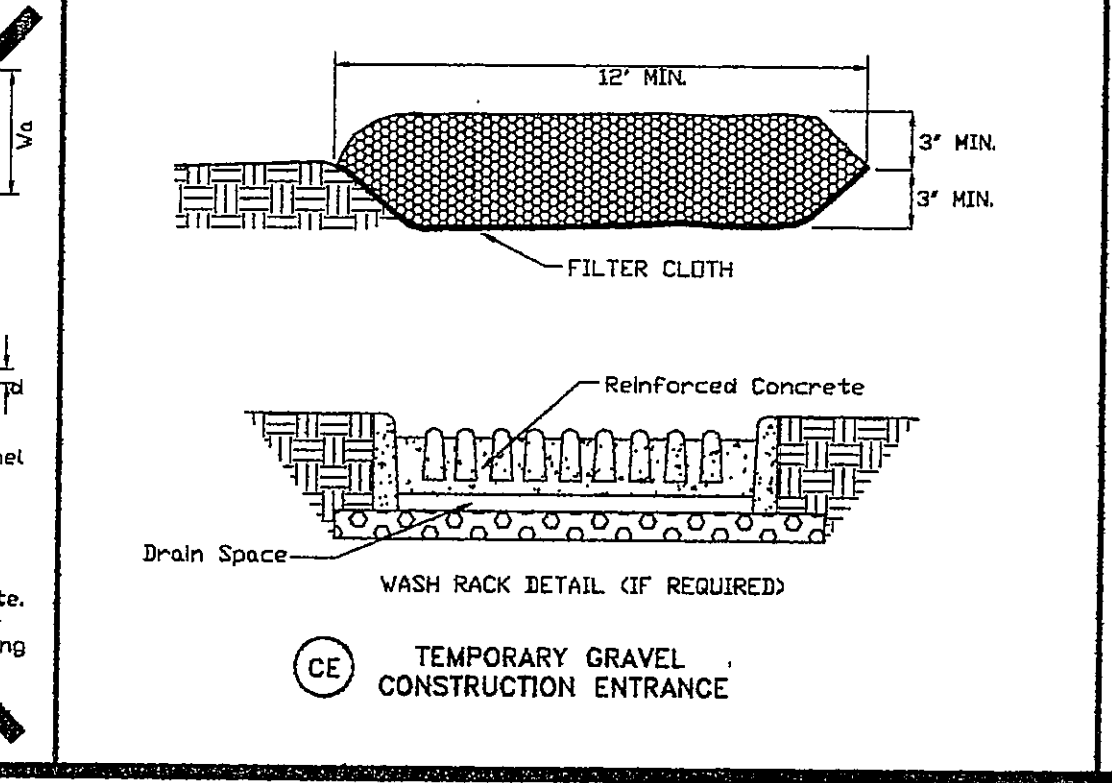

TEMPORARY SEDIMENT TRAP DATA. Table with 5 columns: STRUCTURE, DRAINAGE (ACRES), STORAGE (CY), WEIR HEIGHT (FT), BERM HEIGHT (FT). Rows include DRILL, TEMPORARY DIVERSION DIKE, TEMPORARY FILL DIVERSION, TEMPORARY RIGHT-OF-WAY DIVERSION, DIVERSION.

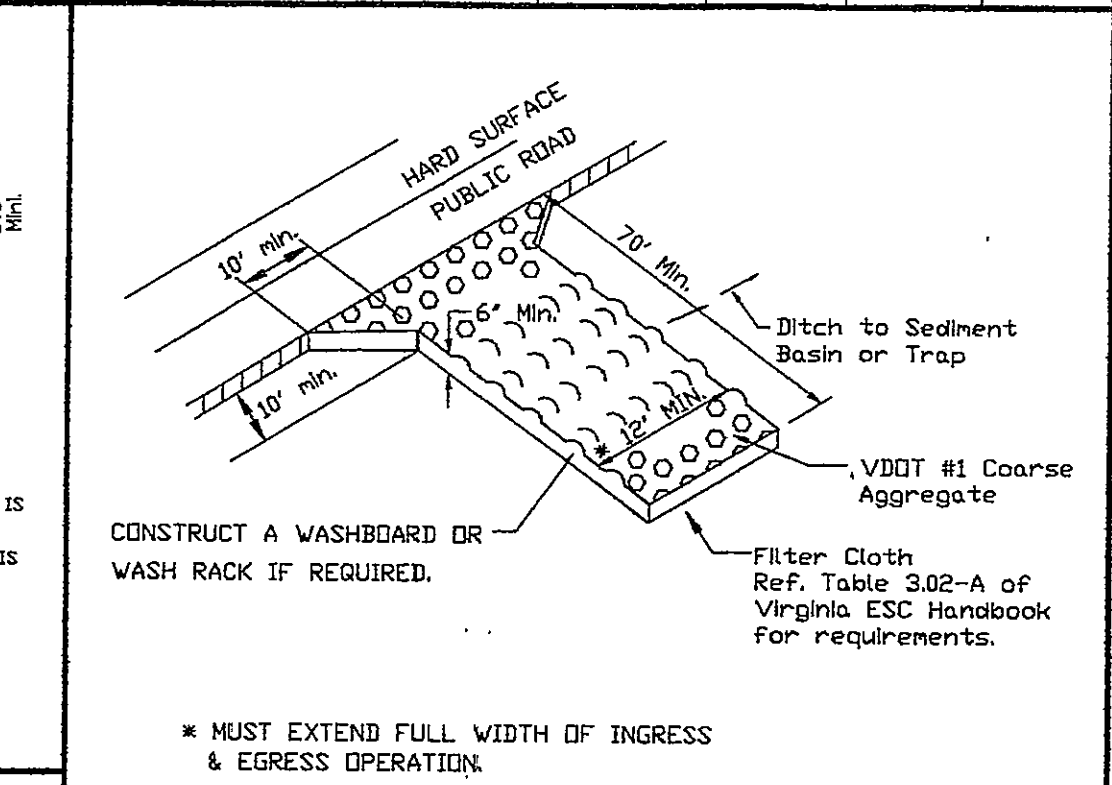

EROSION-SILTATION CONTROL COST ESTIMATE. Table with 5 columns: DESCRIPTION, UNIT, QUANTITY, UNIT COST, TOTAL COST. Rows include CONSTRUCTION ENTRANCE, SILT FENCE, INLET PROTECTION, TEMPORARY DIVERSION DIKE, TEMPORARY FILL DIVERSION, SEDIMENT TRAP, CHECK DAM, PERMANENT SEEDING, OUTLET PROTECTION, SEDIMENT BASIN, SUB-TOTAL, 10% CONTINGENCY, and TOTAL PROJECT COST.

GENERAL EROSION AND SEDIMENT CONTROL NOTES. 1. ALL SOIL EROSION & SEDIMENT CONTROL MEASURES SHALL BE ACCOMPLISHED IN STRICT ACCORDANCE WITH THE STANDARDS AND SPECIFICATIONS CONTAINED IN THE VIRGINIA EROSION AND SEDIMENT CONTROL HANDBOOK, LATEST EDITION. 2. THE APPROVING AUTHORITY MAY ADD TO, DELETE, RELOCATE, CHANGE, OR OTHERWISE MODIFY CERTAIN EROSION AND SEDIMENT CONTROL MEASURES WHERE FIELD CONDITIONS ARE ENCOUNTERED THAT WARRANT SUCH MODIFICATIONS. 3. ALL SOIL EROSION AND SEDIMENT CONTROL MEASURES AS SHOWN ON THE PLAN SHALL BE PLACED IN ADVANCE OF THE WORK BEING PERFORMED, AS FAR AS PRACTICAL. 4. IN NO CASE DURING CONSTRUCTION SHALL WATER RUNOFF BE DIVERTED OR ALLOWED TO FLOW TO LOCATIONS WHERE ADEQUATE PROTECTION HAS NOT BEEN PROVIDED. 5. IT SHALL BE THE CONTRACTOR'S RESPONSIBILITY TO LEAVE THE SITE ADEQUATELY PROTECTED AGAINST EROSION, SEDIMENTATION, OR ANY DAMAGE TO ANY ADJACENT PROPERTY AT THE END OF EACH DAY'S WORK. 6. FOR THE EROSION CONTROL KEY SYMBOLS SHOWN ON THE PLANS, REFER TO THE VIRGINIA EROSION AND SEDIMENT CONTROL HANDBOOK, LATEST EDITION. THESE SYMBOLS AND KEYS ARE TO BE UTILIZED ON ALL EROSION CONTROL PLANS SUBMITTED TO ROANOKE COUNTY.

PERMANENT SEEDING MIXTURE. TYPE A (SLOPES 3:1 OR STEEPER). TYPE B (SLOPES 3:1 OR STEEPER). Table showing seeding rates for various grasses and legumes. Includes notes on lime, fertilizer, mulch, soil conditioning, and seed application.