

NOTES:

1. CONSTRUCTION NEAR GAS MAIN AND GAS MAIN CROSSINGS SHALL FOLLOW THE REQUIREMENTS FOR WORKING AROUND ROANOKE GAS COMPANY ROW MANUAL.

PROPOSED ROAD AND GRADING BY OTHERS (REFER TO LOT B & C ACCESS ROAD PLANS)

SUB-STATION

PROPOSED DETENTION POND GRADING FROM PROJECT SHOOTING STAR

PROPOSED STORM OUTLET (BY OTHERS)

AS-BUILT MH 11
RIM = 1335.78
INV. IN 15" PVC (NW) = 1325.82
INV. OUT 15" PVC (SE) = 1325.75

AS-BUILT MH 12
RIM = 1337.67
INV. IN 8" PVC (NW) = 1329.75
INV. OUT 15" PVC (S) = 1328.47

AS-BUILT MH 13
RIM = 1337.67
INV. IN 8" PVC (NW) = 1329.75
INV. OUT 8" PVC (SE) = 1328.47

SDR-35 PIPE

PROPOSED 27" STORM OUTLET (BY OTHERS)


NEW 20" SEWER EASEMENT

PROPOSED LOCATION OF SANITARY EXTENSION FROM PROJECT SHOOTING STAR

PROPOSED STORM CULVERTS BY OTHERS (REFER TO LOT B & C ACCESS ROAD PLANS)

GRAPHIC SCALE

(IN FEET)
1 inch = 30 ft.

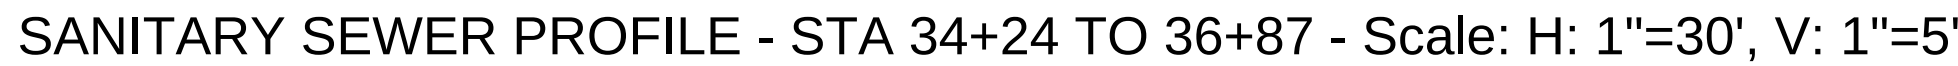

REVISIONS		
NO.	DESCRIPTION	DATE
1	ISSUED FOR CONSTRUCTION	8/6/2021
2	CO #2	09/08/21
3	CO#3	10/06/21
4	CO#4	11/16/21
5	RECORD DWG	03/22/22
DESIGNED BY: RCN		
DRAWN BY: NRK		
CHECKED BY: EBH		
SCALE: SEE PLAN		
DATE: 03/22/2022		
PROJECT NUMBER: 2109323-06		
C-05		