

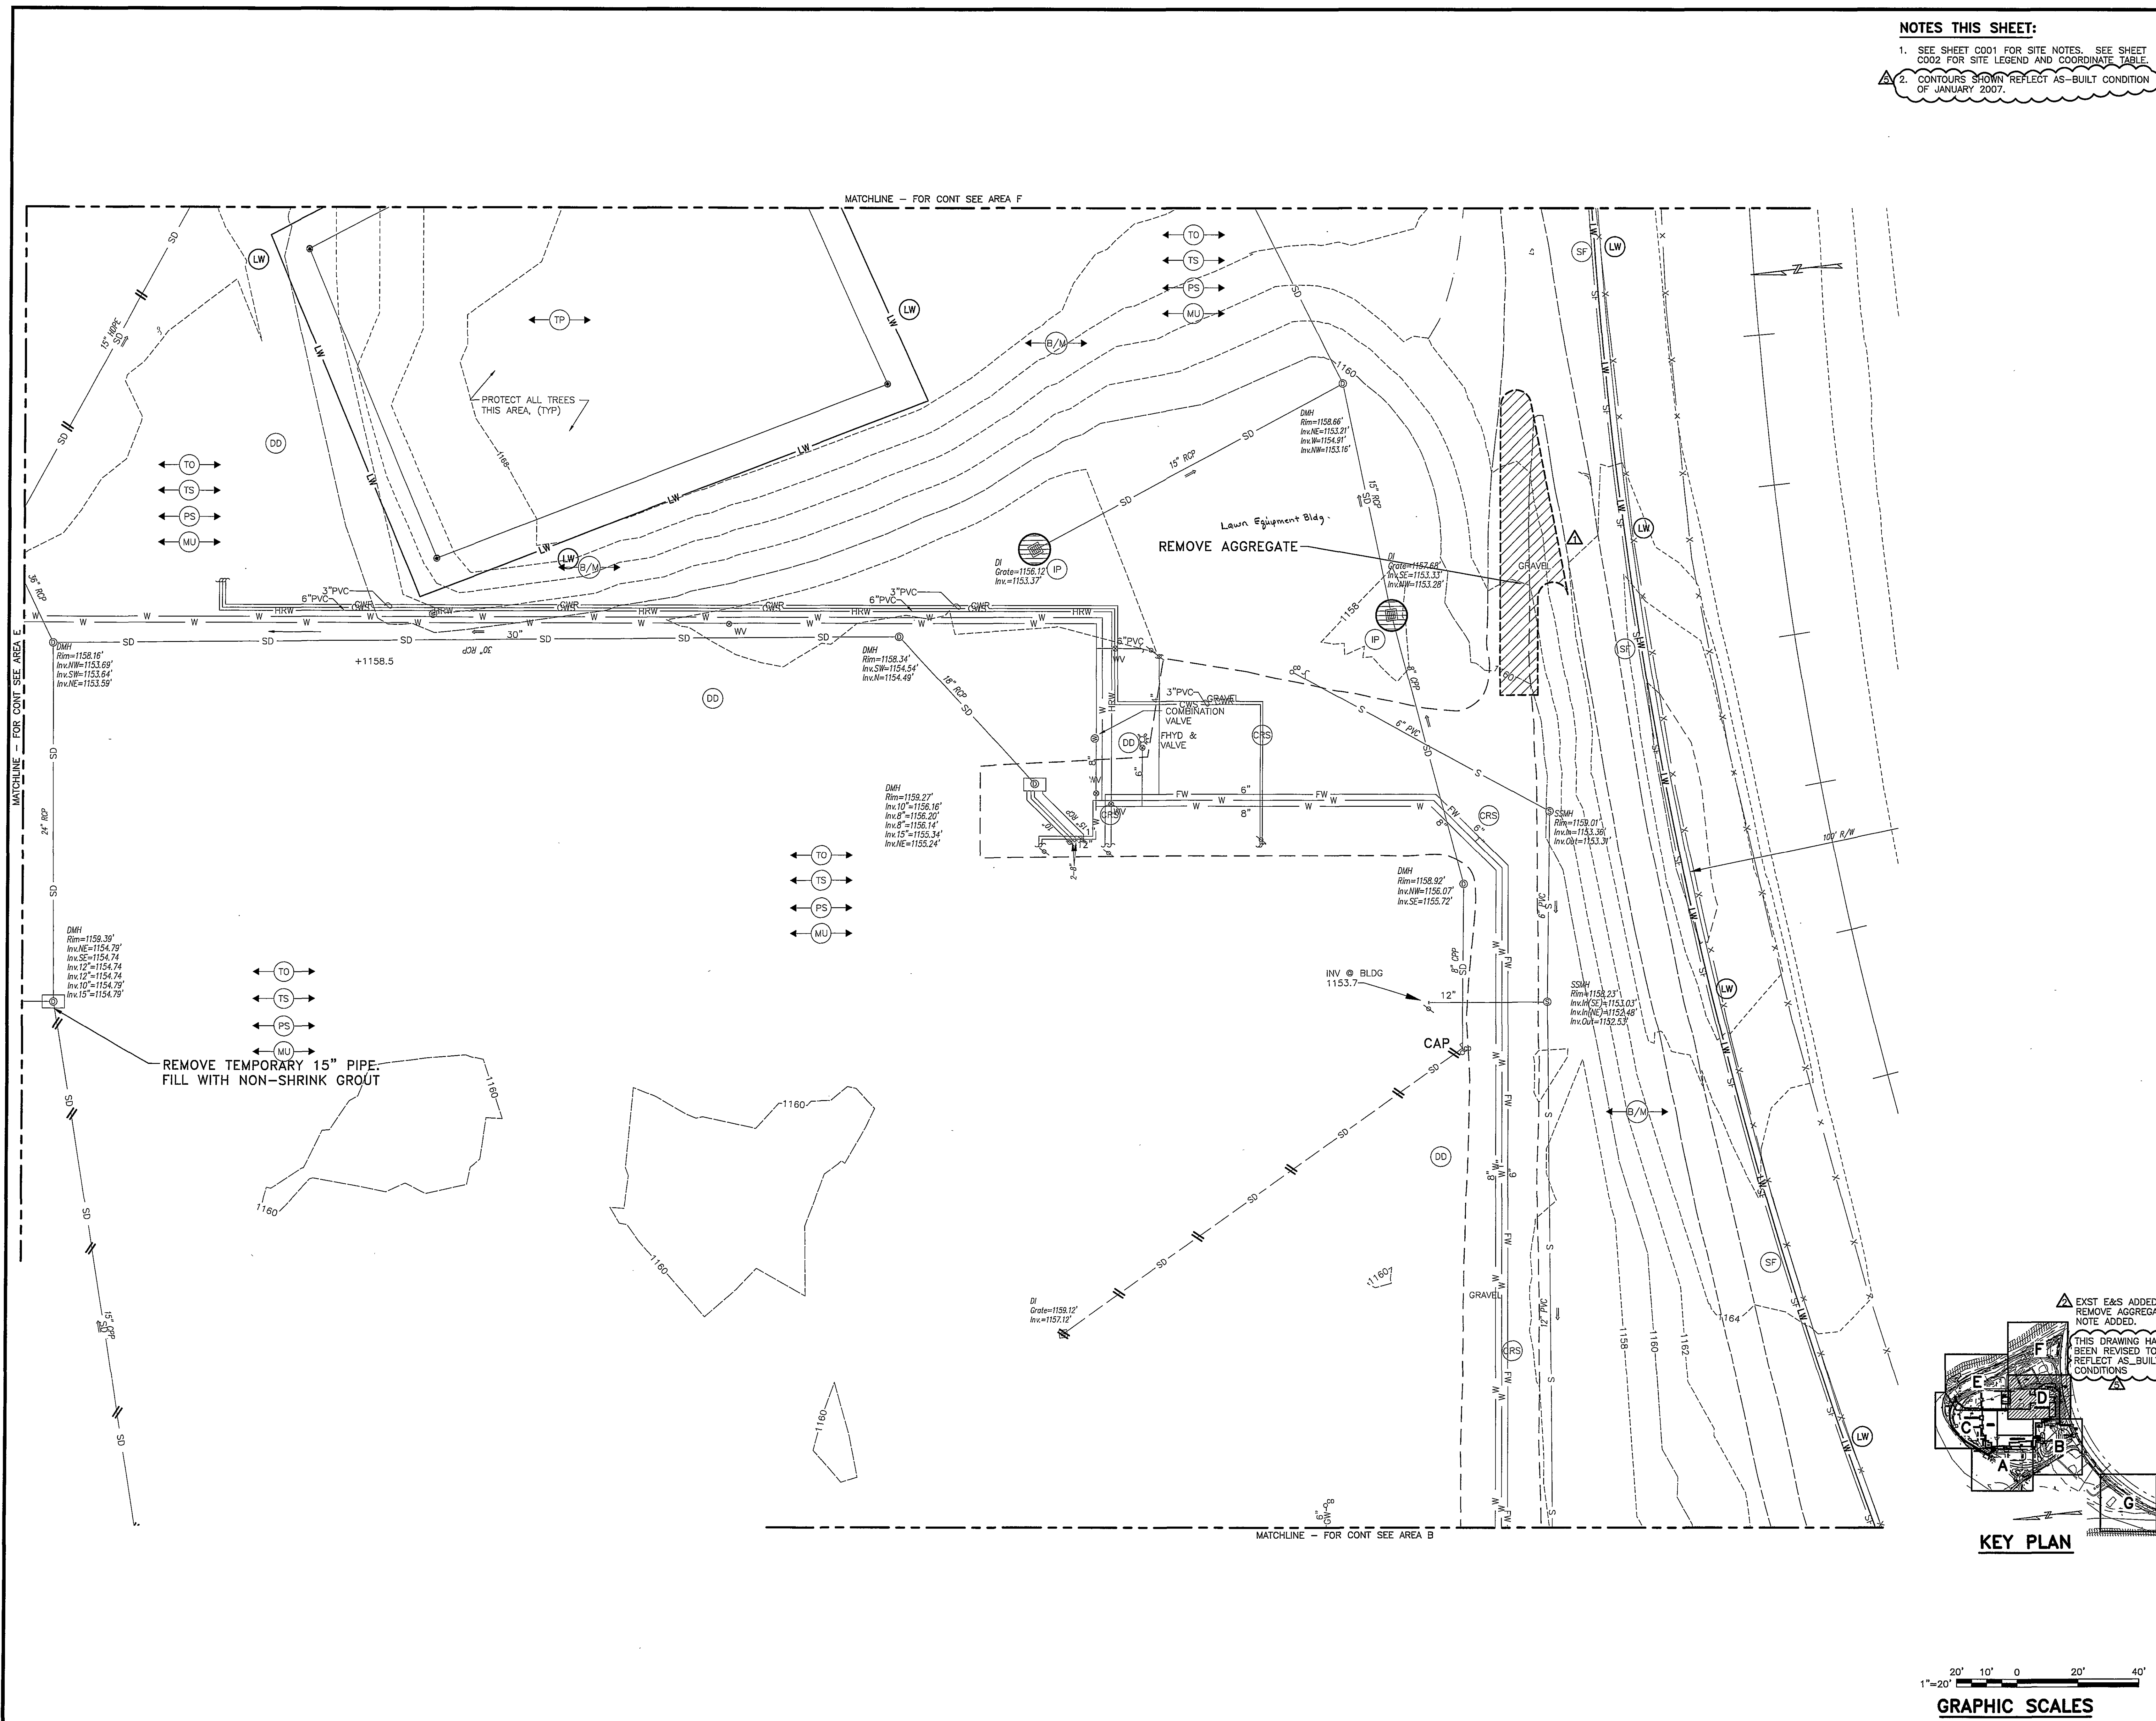


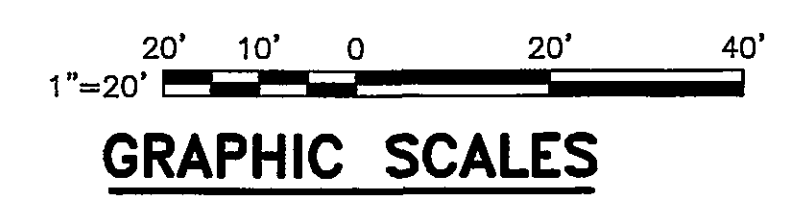

NOTES THIS SHEET:

1. SEE SHEET C001 FOR SITE NOTES. SEE SHEET C002 FOR SITE LEGEND AND COORDINATE TABLE.
2. CONTOURS SHOWN REFLECT AS-BUILT CONDITION OF JANUARY 2007.

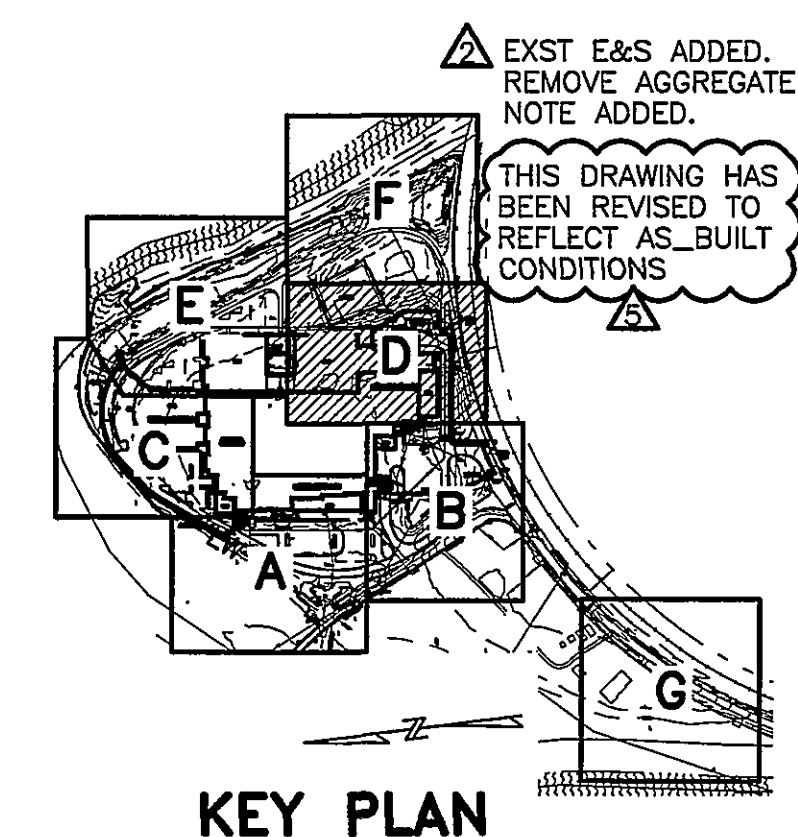

HSMM

ARCHITECTS ENGINEERS PLANNERS

HAYES, SEAY, MATTERN & MATTERN, INC.
1315 FRANKLIN ROAD
ROANOKE, VA 24016
(540) 857-3100 WWW.HSMM.COM

SEALS

CONSULTANT

THOMPSON & LITTON
P.O. Box 1307
103 East Main Street
Wise, Virginia 24293

Rolf Jensen & Associates, Inc.
Life Safety Consultants
3040 Williams Drive, Suite 400
Fairfax, Virginia 22031

Faassen & Associates, Inc.
Food Service & Laundry Consultant
8526 Sunflower Road
Charlotte, NC 28227

David E. Musacchio & Associates
Security/Detention Consultant
Cookeville, Tennessee

WESTERN VIRGINIA REGIONAL JAIL

WESTERN VIRGINIA REGIONAL JAIL AUTHORITY
ROANOKE COUNTY, VIRGINIA

REV	DATE	DESCRIPTION	APP
1	10/02/06	ADDENDUM 1	JMC
2	10/16/06	ADDENDUM 2	JMC
5	01/29/07	GENERAL REVISIONS	JMC

COMM NO: 10075
ISSUE DATE: FEBRUARY 1, 2007
DESIGNED BY: SMS DRAWN BY: SMS
CHECKED BY: MLC SUBMITTED BY: JMC
© HAYES, SEAY, MATTERN & MATTERN, INC., 2005. ALL RIGHTS RESERVED.

CIVIL

EXST CONDITIONS AND DEMO PLAN, AREA D

CD101D