


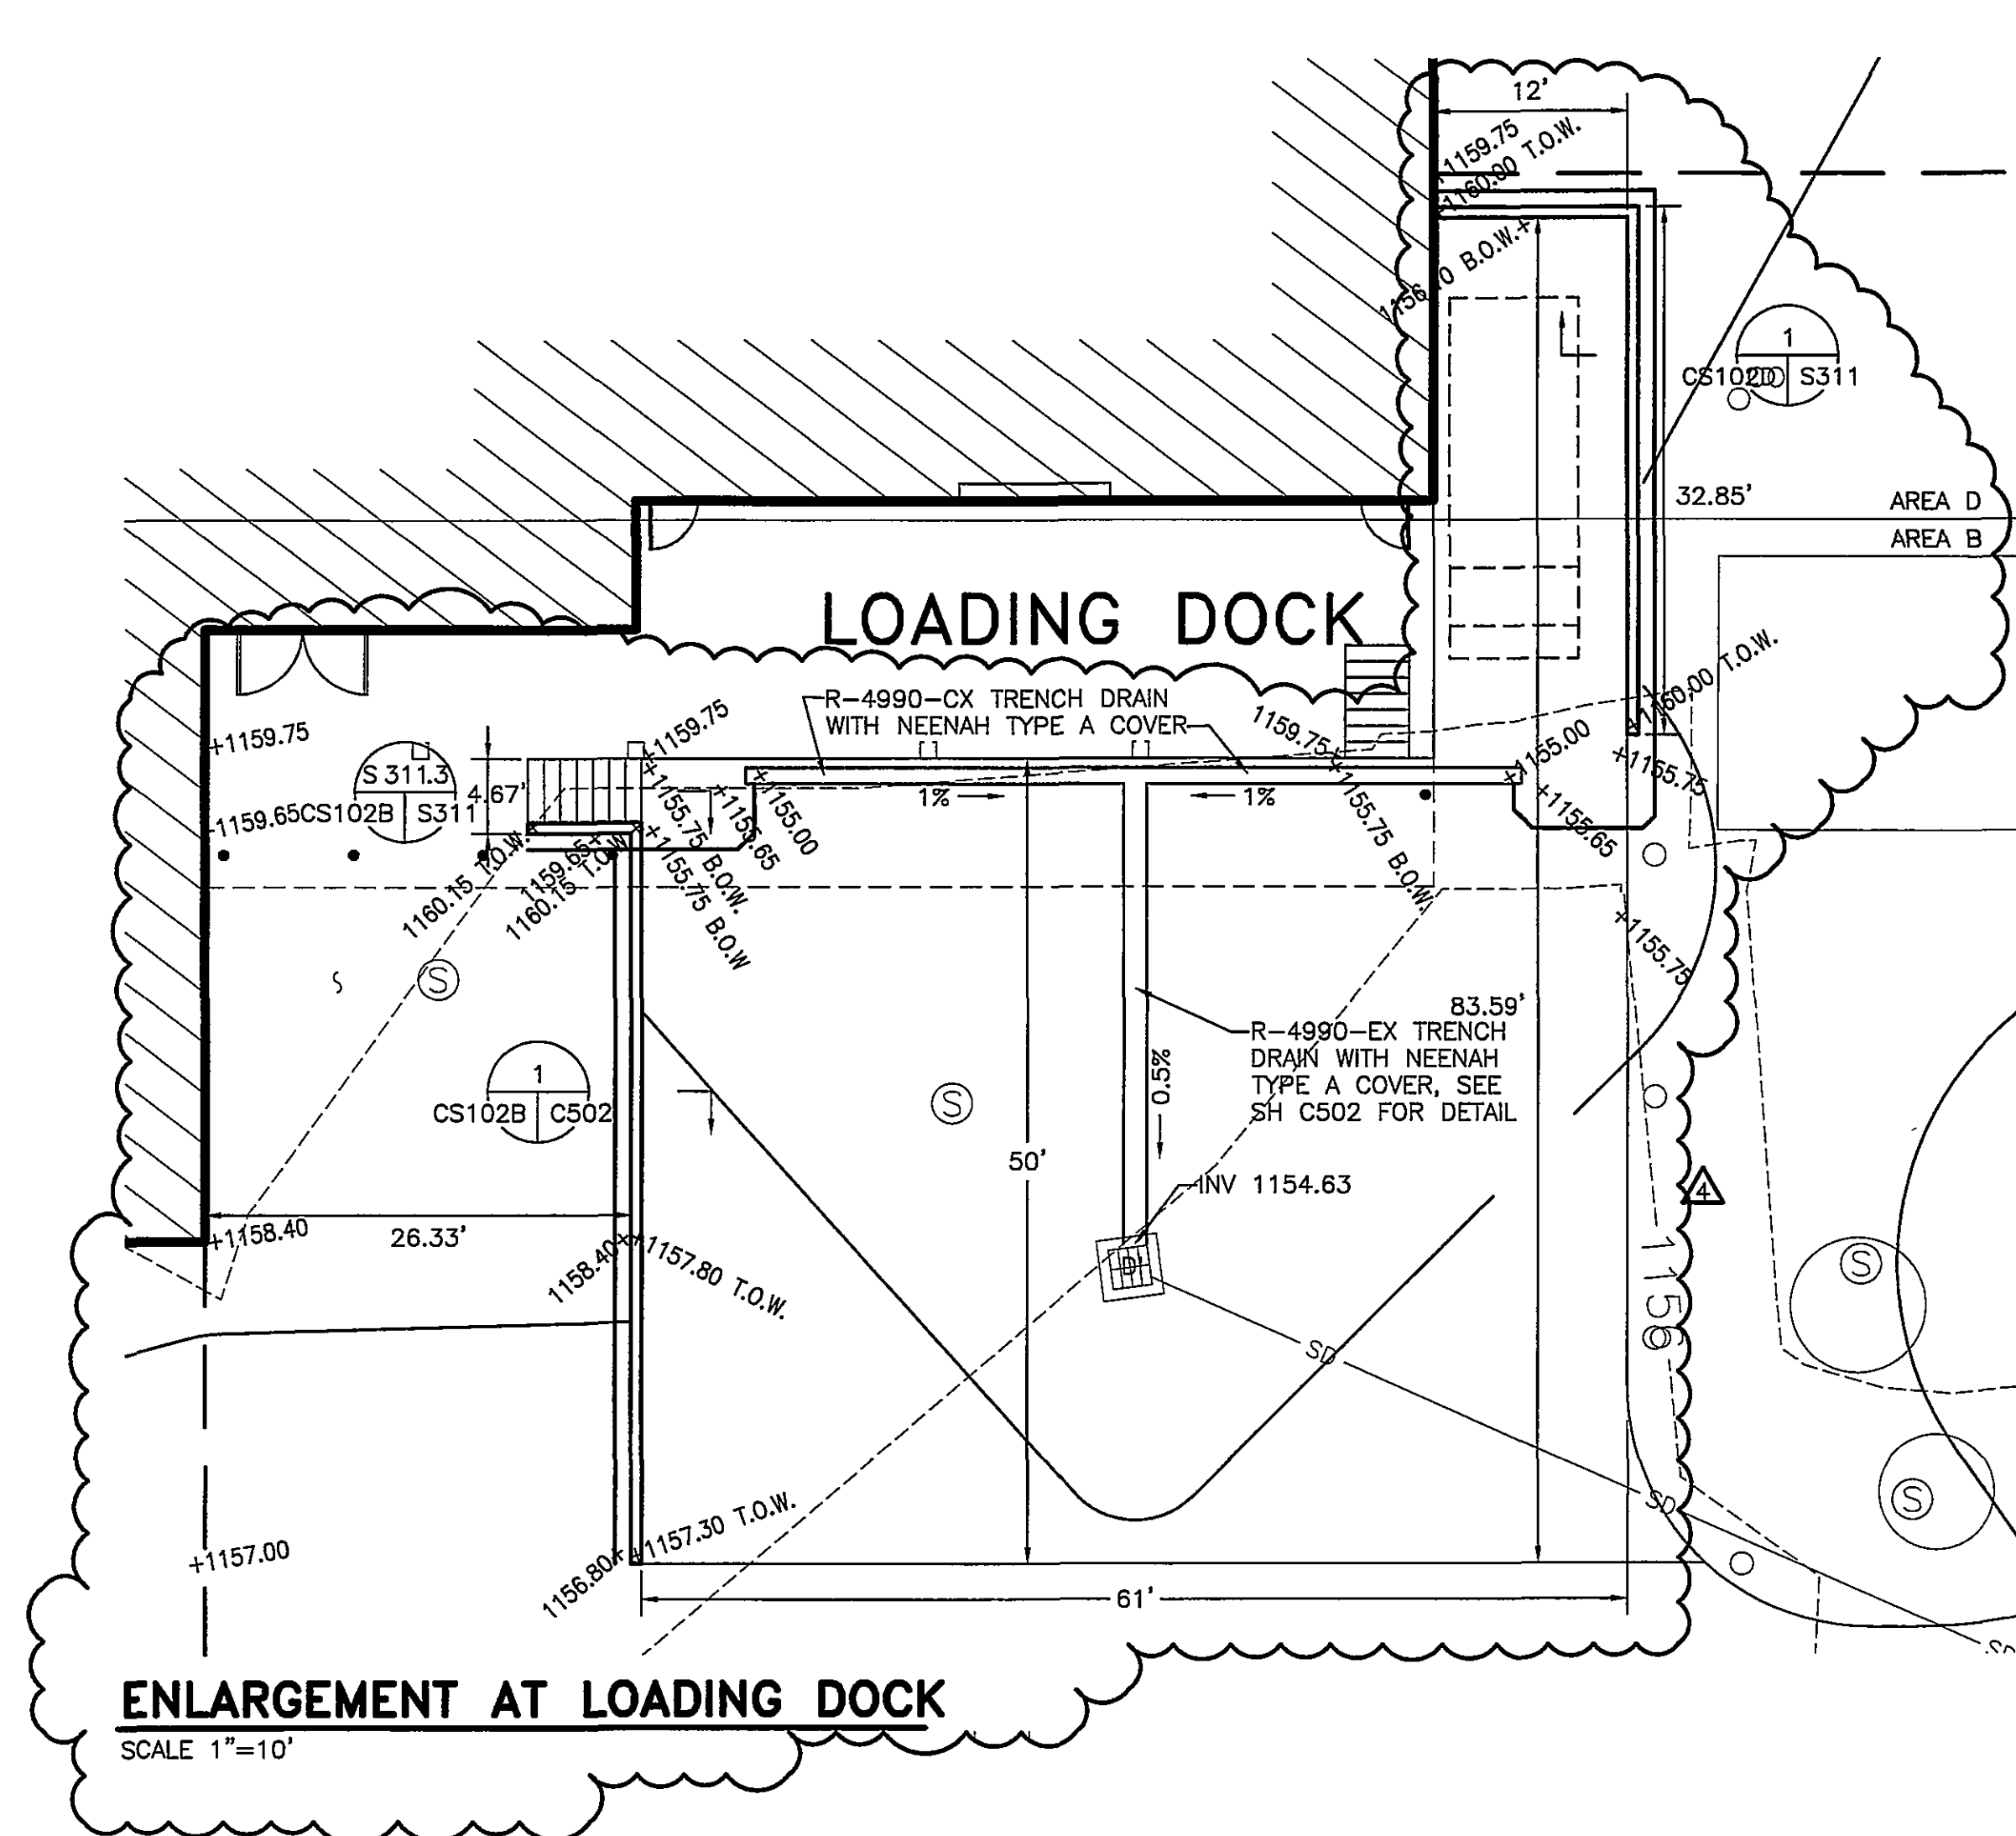

1. SEE SHEET C001 FOR SITE NOTES. SEE SHEET C002 FOR SITE LEGEND AND COORDINATE TABLE.
2. CONTRACTOR SHALL ADJUST FINISHED GRADING UNDER PAVED SECTIONS IN ACCORDANCE WITH THE PAVEMENT CROSS SECTION DETAIL ON SHEET C501.
3. SEE ENLARGEMENT AT DOCK, THIS SHEET.

David E. Musacchio & Associates
Security/Detention Consultant
Cookeville, Tennessee

WESTERN VIRGINIA
REGIONAL JAIL AUTHORITY
ROANOKE COUNTY, VIRGINIA


REV	DATE	DESCRIPTION	APP
1	10/02/06	ADDENDUM 1	JMC
3	10/24/06	ADDENDUM 3	JMC
4	11/14/06	REVIEW COMMENTS	JMC
5	01/29/07	GENERAL REVISIONS	JMC

COMM NO: 10075
 ISSUE DATE: FEBRUARY 1, 2007
 DESIGNED BY: SMS DRAWN BY: SMS
 CHECKED BY: MLC SUBMITTED BY: JMC
 © HAYES, SEAY, MATTERN & MATTERN, INC.,
 2005. ALL RIGHTS RESERVED.

CIVIL

GRADING AND DRAINAGE
PLAN,
AREA B

CG103B

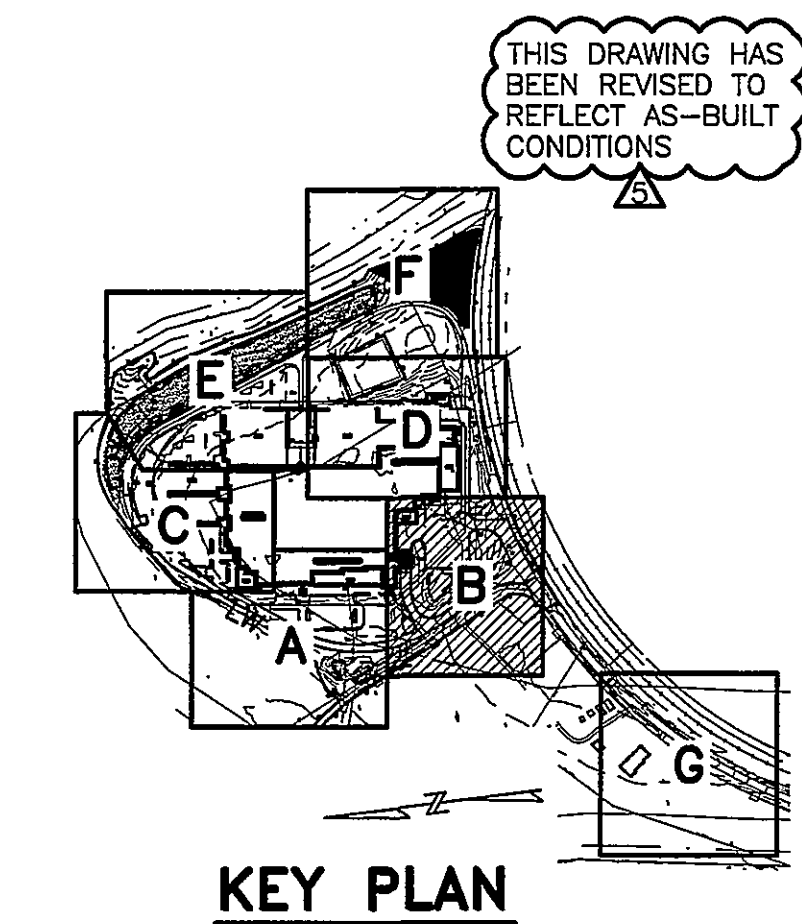

1"=10' 10' 5' 0 10' 2'

1"=20' 20' 10' 0 20' 4'

GRAPHIC SCALES