

$\triangle 4$

NOTE:
1. ORIFICE OPENING SHALL REMAIN PLUGGED DURING CONSTRUCTION. INSTALL 4" ORIFICE PLATE AFTER SITE IS STABILIZED AND COUNTY APPROVES CONVERSION OF TEMPORARY SEDIMENT BASIN TO PERMANENT SWM POND.

1. SEE SHEET C001 FOR SITE NOTES. SEE SHEET C002 FOR SITE LEGEND AND COORDINATE TABLE.
2. CONTRACTOR SHALL ADJUST FINISHED GRADING UNDER PAVED SECTIONS IN ACCORDANCE WITH THE PAVEMENT CROSS SECTION DETAIL ON SHEET C501.

ARCHITECTS ENGINEERS PLANNERS



THOMPSON &
LITTON
P.O. Box 1307
103 East Main Street
Wise, Virginia 2429

Rolf Jensen & Associates, Inc.
Life Safety Consultants
3040 Williams Drive, Suite 400
Fairfax, Virginia 22031

Faassen & Associates, Inc.
Food Service & Laundry Consultant
8526 Sunflower Road
Charlotte, NC 28227

David E. Musacchio & Associates
Security/Detention Consultant
Cookeville, Tennessee

**WESTERN VIRGINIA
REGIONAL JAIL**


WESTERN VIRGINIA
REGIONAL JAIL AUTHORITY
ROANOKE COUNTY, VIRGINIA

THIS DRAWING HAS
BEEN REVISED TO
REFLECT AS-BUILT
CONDITIONS

© HAYES, SEAY, MATTERN & MATTERN, INC.,
2005. ALL RIGHTS RESERVED.

GRADING AND DRAINAGE
PLAN,
AREA E

CG103E

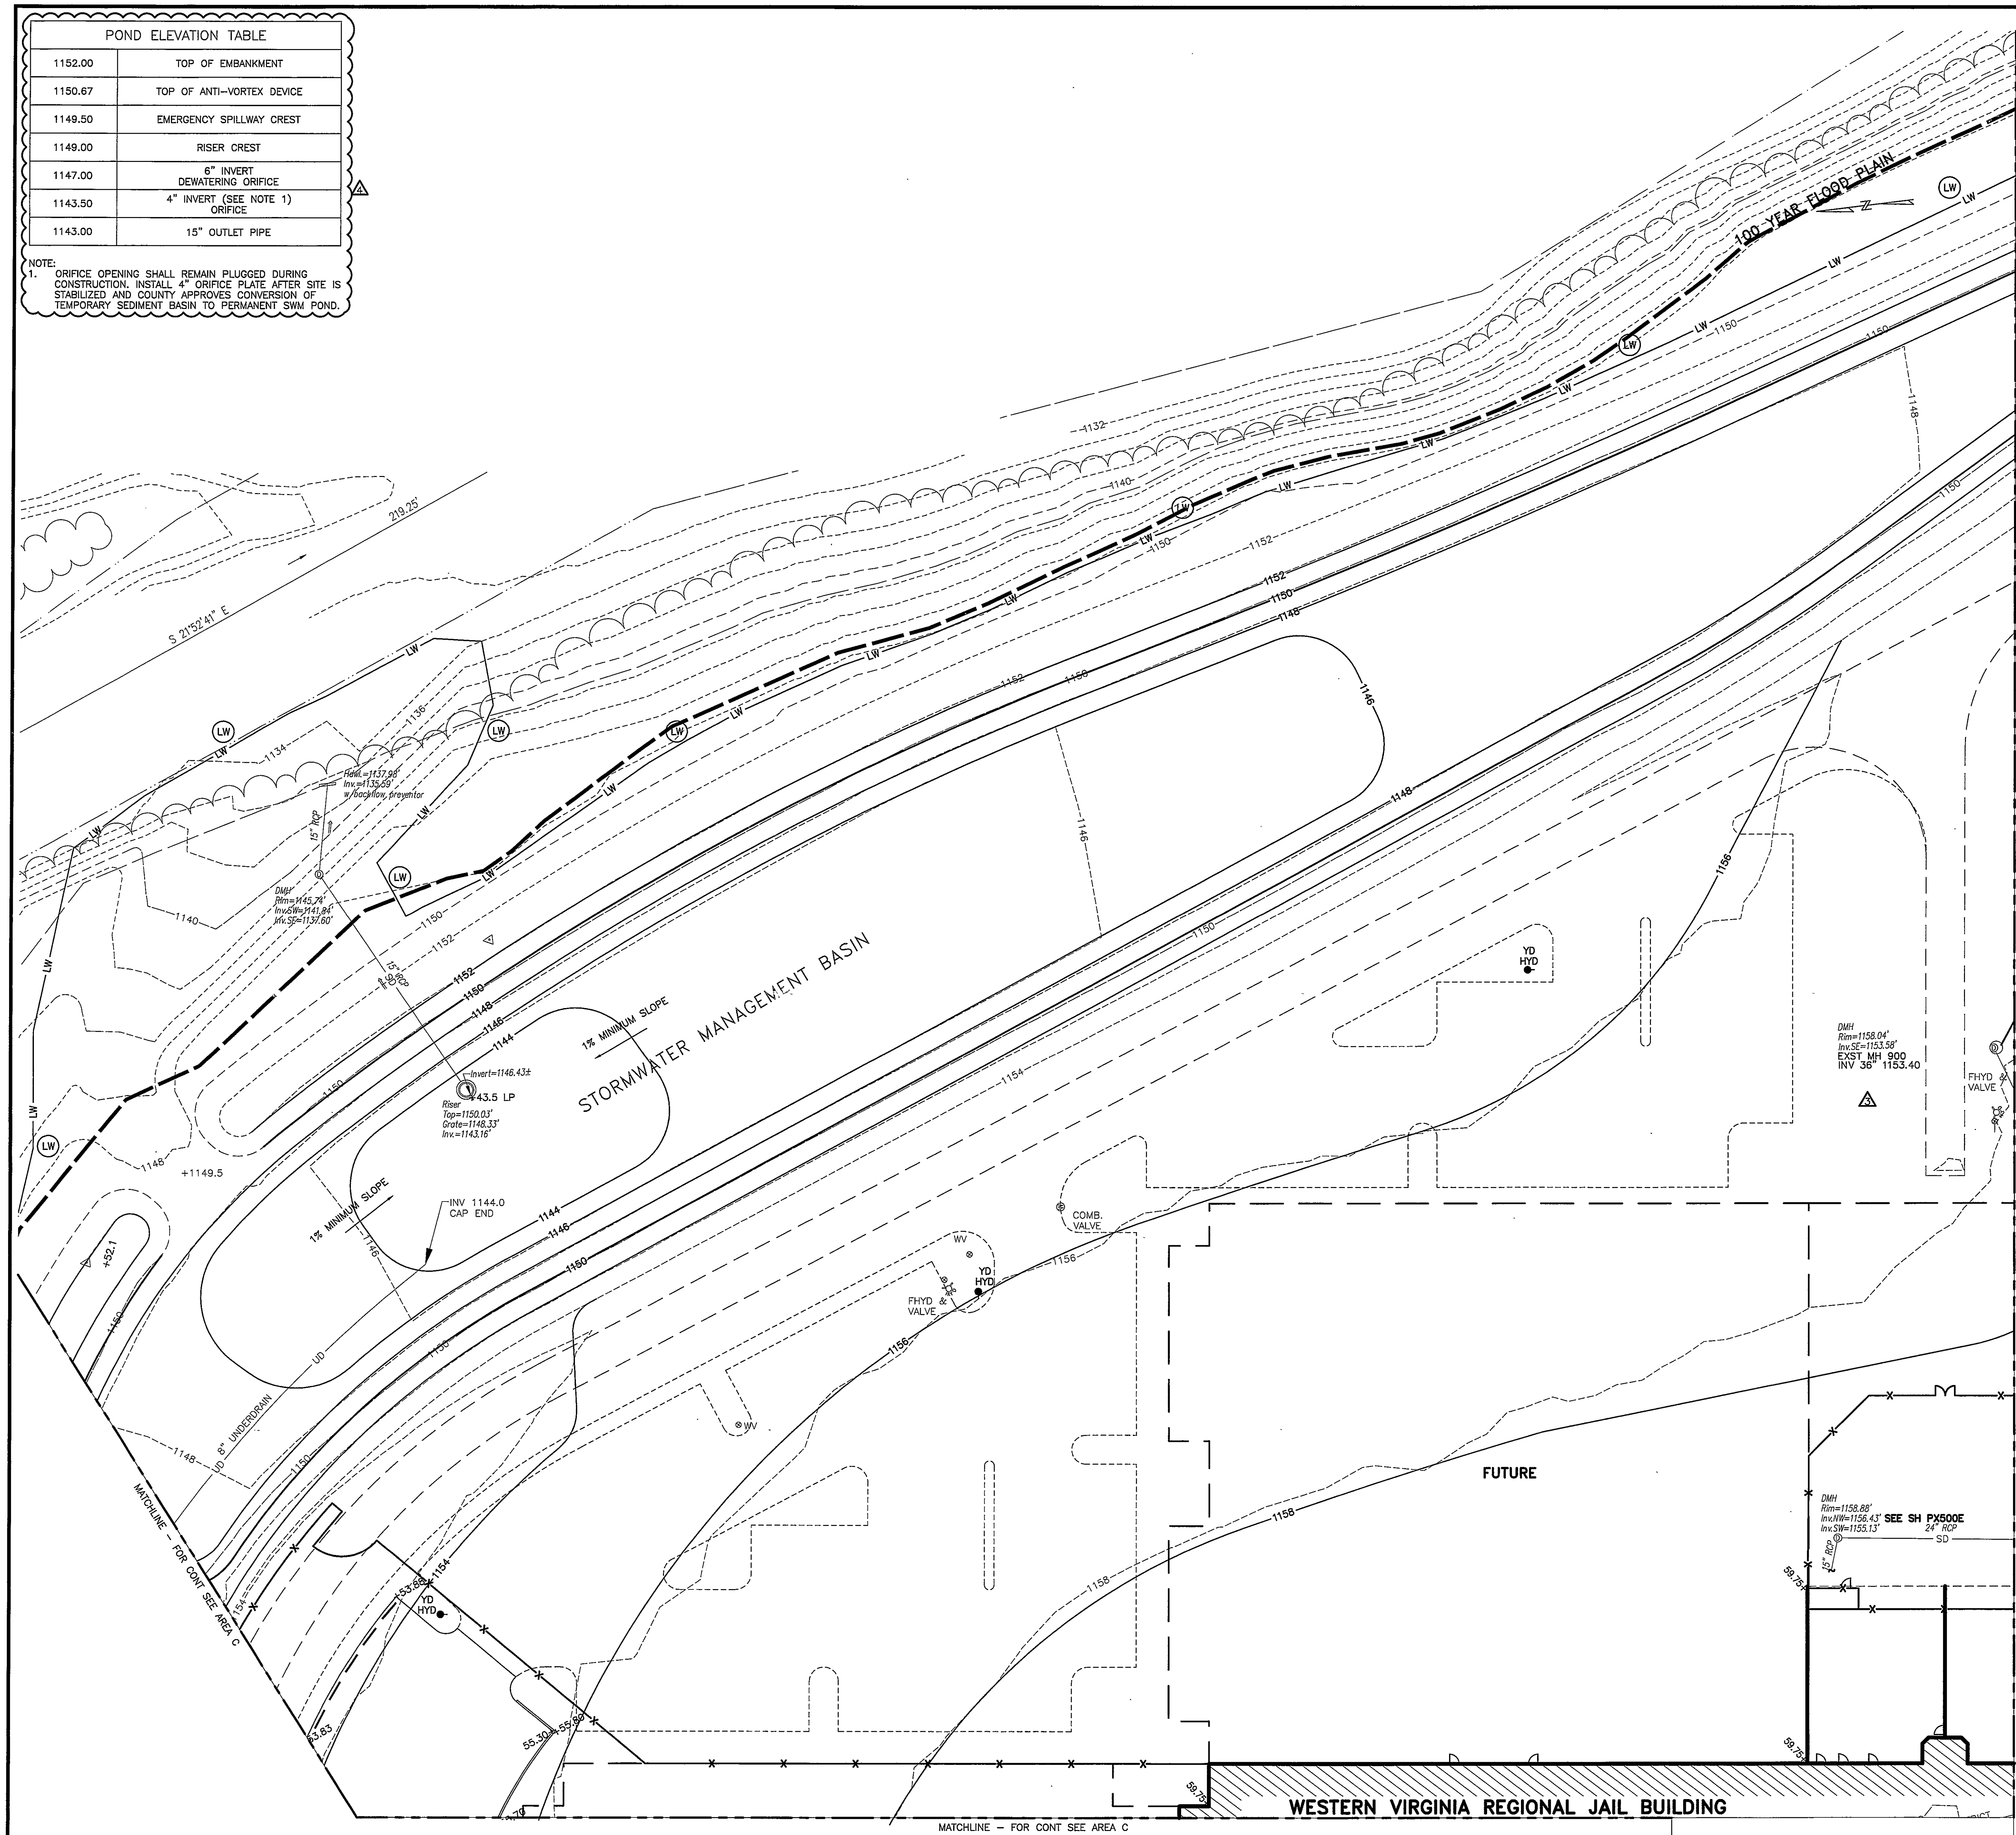

20' 10' 0 20' 40'

1"=20'

GRAPHIC SCALES

M:\10000SERIES\10075\CADD\DWG\FJ4CGN_0103E.DWG 10075 01/29/2007 06:01:53 ANDY FREELAND
HSM-M-Full.ctb RF: f4c4cxpml00 f4c4c exp00 f4c4cxpsv00 f4c4cunxv00 f4c4cnpvxp00 f4c4c nxbdr f4c4cnsxkvp f4c4c nxarwv NONE