


**MATCH LINE SANITARY FORCE MAIN @ STA 15+50
FOR CONTINUATION SEE SHEET CU104J**

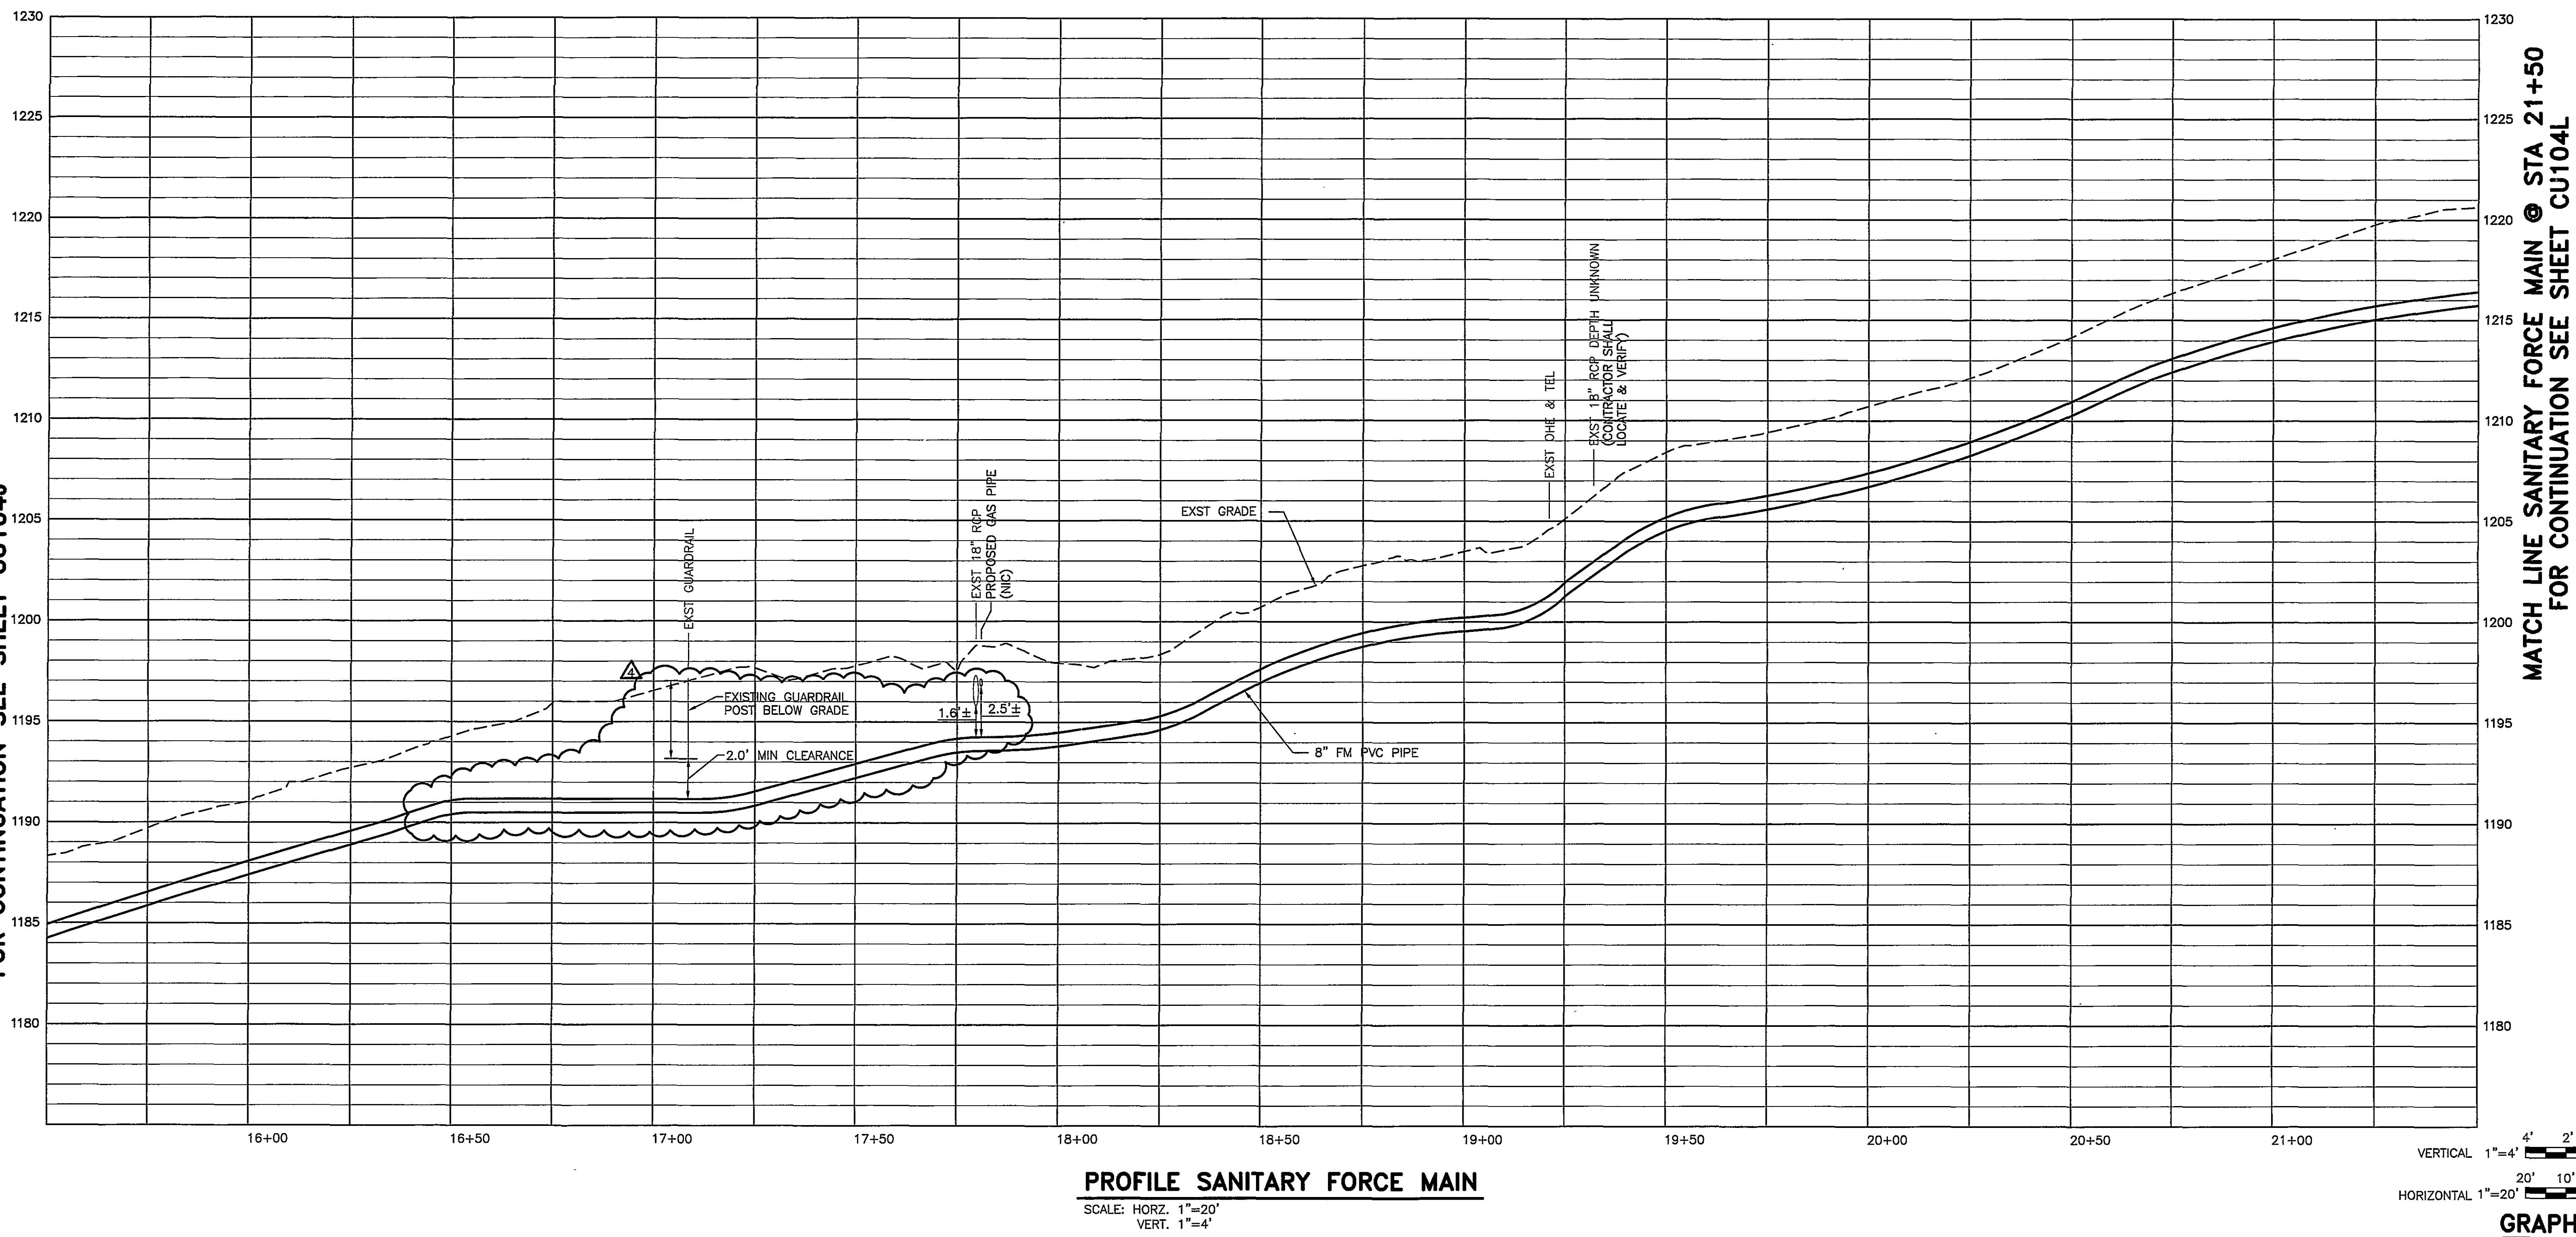

1. SEE SHEET C001 FOR SITE/UTILITIES NOTES.
SEE SHEET C002 FOR LEGEND.
2. SEE SHEET CU104 FOR SHEET KEY PLAN, OFF SITE UTILITIES.
3. SEE SHEET C501, C503 FOR UTILITY DETAILS.
4. SEE SHEET CU1040 FOR HORIZONTAL AND VERTICAL POINT CONTROL REFERENCE DIAGRAMS.

ARCHITECTS ENGINEERS PLANNERS

SEALS



Faassen & Associates, Inc.
Food Service & Laundry Consultant
8526 Sunflower Road
Charlotte, NC 28227

**WESTERN VIRGINIA
REGIONAL JAIL**

WESTERN VIRGINIA
REGIONAL JAIL AUTHORITY
ROANOKE COUNTY, VIRGINIA

REV	DATE	DESCRIPTION	APP
3	10/24/06	ADDENDUM 3	JMC
4	11/14/06	REVIEW COMMENTS	JMC

COMM NO: 10075	
ISSUE DATE: FEBRUARY 1, 2007	
DESIGNED BY: SPH	DRAWN BY: REH
CHECKED BY: MLC	SUBMITTED BY: JMC
© HAYES, SEAY, MATTERN & MATTERN, INC., 2005. ALL RIGHTS RESERVED.	

CIVIL

PLAN AND PROFILE
SANITARY FORCE MAIN &
E&S CONTROL

CU104K