





WESTERN VIRGINIA WATER AUTHORITY JAMESTOWN ROAD WATER MAIN EXTENSION FRANKLIN COUNTY, VIRGINIA

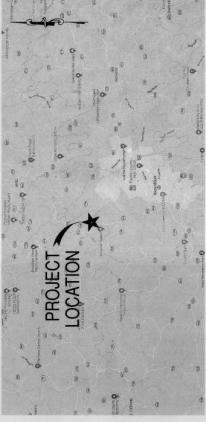

LOCATION MAP
NO SCALE

DRAWING TITLE	SHEET NUMBER
COVER	1
GENERAL NOTES & PROPOSED LEGEND	2
SHEET LAYOUT & THE HYDRAULIC COVERAGE MAP	3
UTILITY SCHEDULES, NOTES, & EXISTING LEGEND	4
12" WATER MAIN PLAN - PROFILE, STA. 10+00 TO STA. 15+00	5
12" WATER MAIN PLAN - PROFILE, STA. 15+00 TO STA. 20+00	6
12" WATER MAIN PLAN - PROFILE, STA. 20+00 TO STA. 25+54	7
EROSION & SEDIMENT CONTROL NOTES	8
EROSION & SEDIMENT CONTROL DETAILS	9
STANDARD DETAILS	10
TEMPORARY TRAFFIC CONTROL PLAN NOTES	11
TEMPORARY TRAFFIC CONTROL PLAN NOTES	12
TEMPORARY TRAFFIC CONTROL PLAN FIGURE 1	13
TEMPORARY TRAFFIC CONTROL PLAN FIGURE 2	14
	15

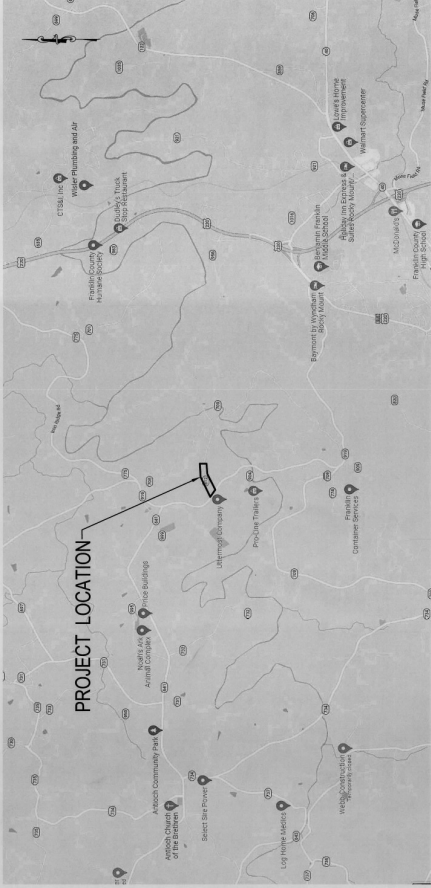

VICINITY MAP
NO SCALE

MARCH 2023

OWNER: WVA
CONSTRUCTION MANAGER: JAMES H. HARRIS
1000 North Dr., Suite 1000, Blacksburg, VA 24060
(540) 232-1114
ENGINEER: JAMES H. HARRIS & ASSOCIATES, L.P.
1000 North Dr., Suite 1000, Blacksburg, VA 24060
(540) 232-1114

VESCP Approval
Professional Engineer
James H. Harris, P.E.
Virginia License No. 10000
Expiration Date: 12/31/2023

Project: J. Harris
Date: 03/23/23 11:30:07 AM



WVA
Western Virginia Water Authority
1000 North Dr., Suite 1000, Blacksburg, VA 24060

REV	DATE	DESCRIPTION	SHEET
			1

WESTERN VIRGINIA WATER AUTHORITY 601 South Jefferson Street, Suite 300 Blacksburg, Virginia 24011	JAMESTOWN ROAD WATER MAIN EXTENSION	COVER	7.11.23
---	--	-------	---------

Inspector: As-Built	K. Winslow	Contractor: Wells Construction
---------------------	------------	--------------------------------