
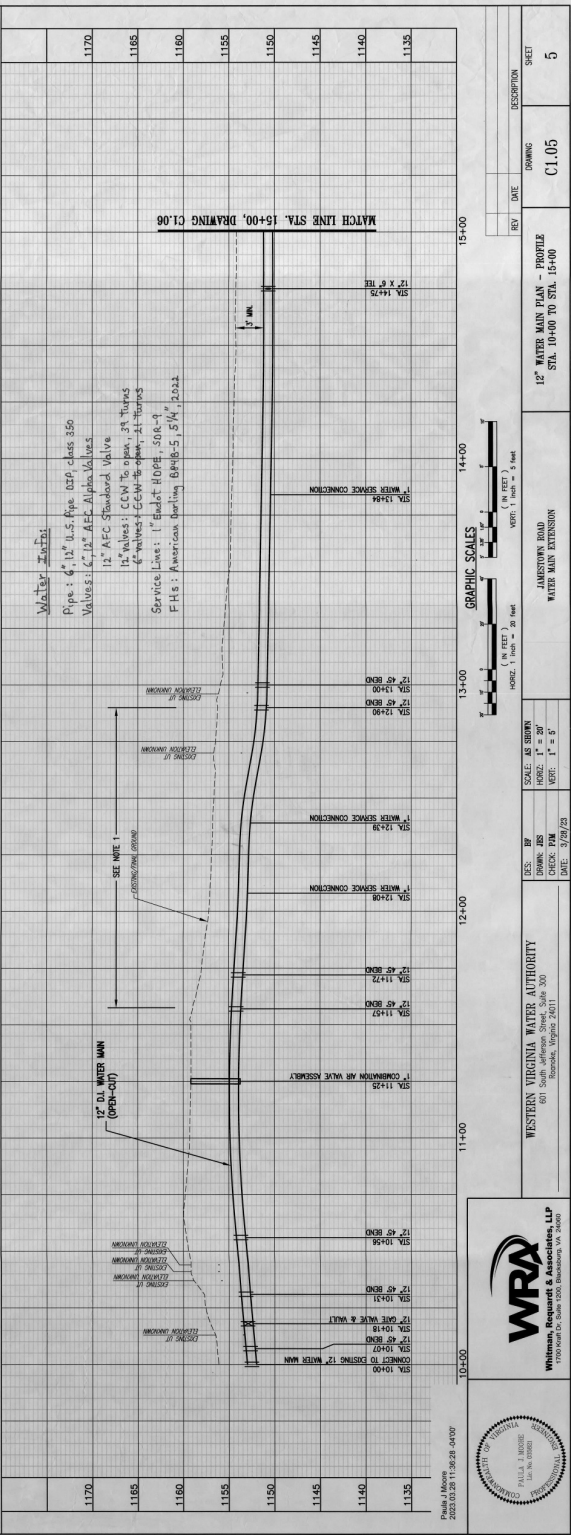


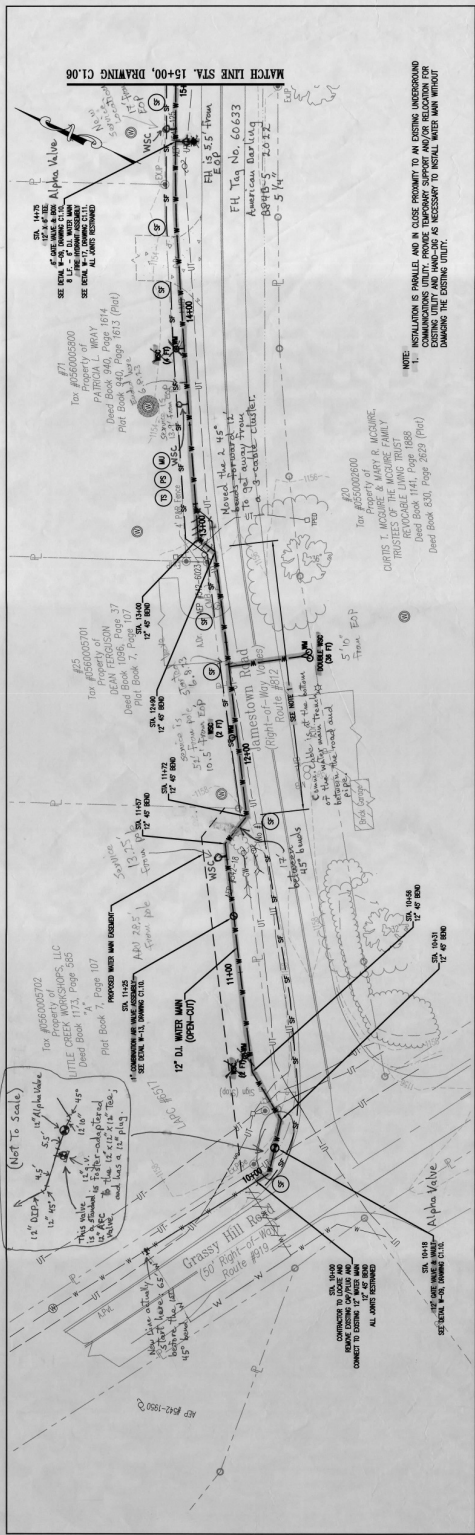

WESTERN VIRGINIA WATER AUTHORITY  
 801 South Jefferson Street, Suite 300  
 Roanoke, Virginia 24011

Inspectors As-Built K. Winslow 7.11.23

12" WATER MAIN PLAN - PROFILE  
 STA. 10+00 TO STA. 15+00

DRAWING C1.05

SHEET 5