



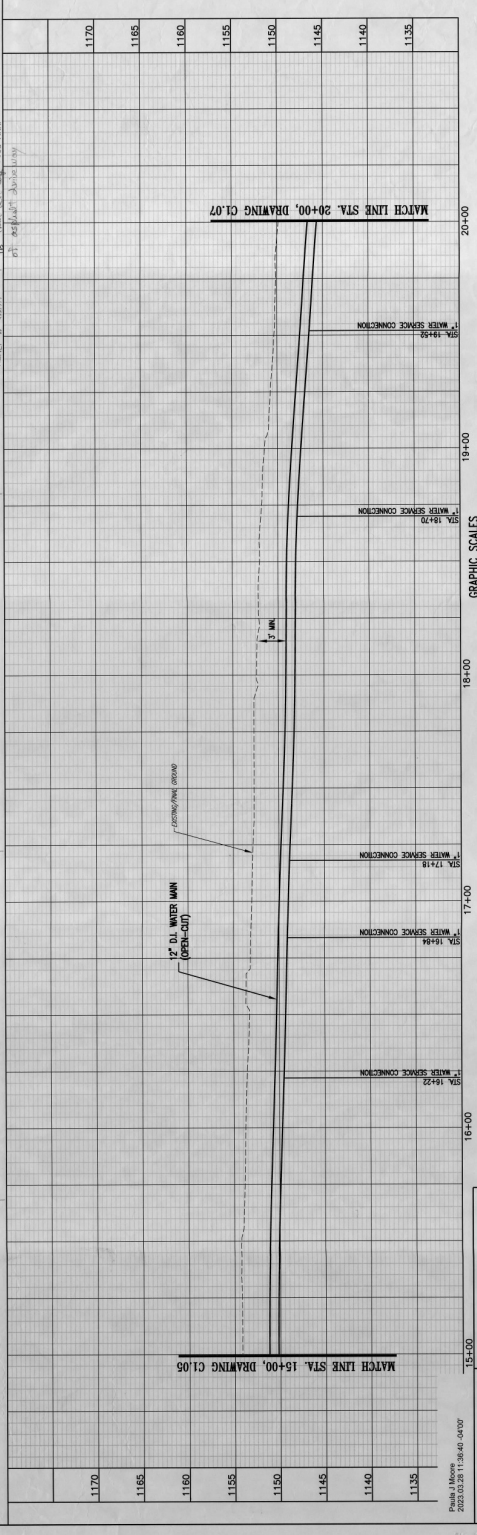

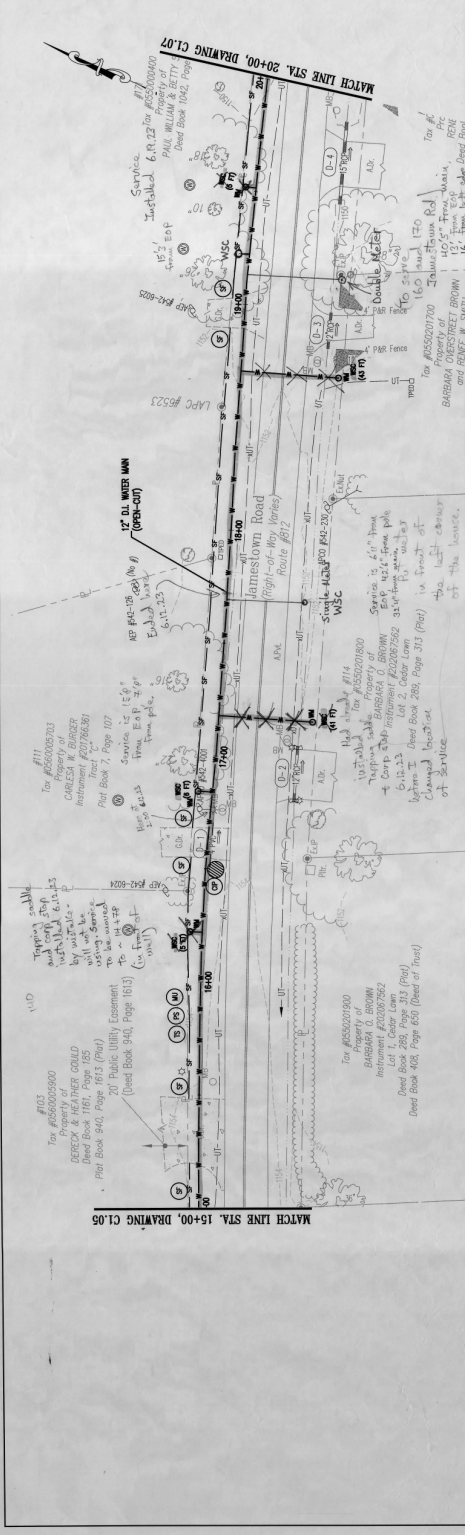

WRM
Whitman, Requaert & Associates, LLP
1100 South 2nd Street, Suite 200, Richmond, VA 23261

WESTERN VIRGINIA WATER AUTHORITY
601 S. Main Street, Suite 200
Roanoke, Virginia 24001

12" WATER MAIN PLAN - PROFILE
STA. 15+00 TO STA. 20+00

INSPECTOR'S AS-BUILT
K. Winslow

DATE: 2/28/23
CHECKED: JMS
DATE: 2/28/23

SCALE: AS SHOWN
HORIZ: 1" = 50'
VERT: 1" = 5'

GRAPHIC SCALES
HORIZ: 1 inch = 50 feet
VERT: 1 inch = 5 feet

REV. DATE DESCRIPTION
1 C1.06 6