


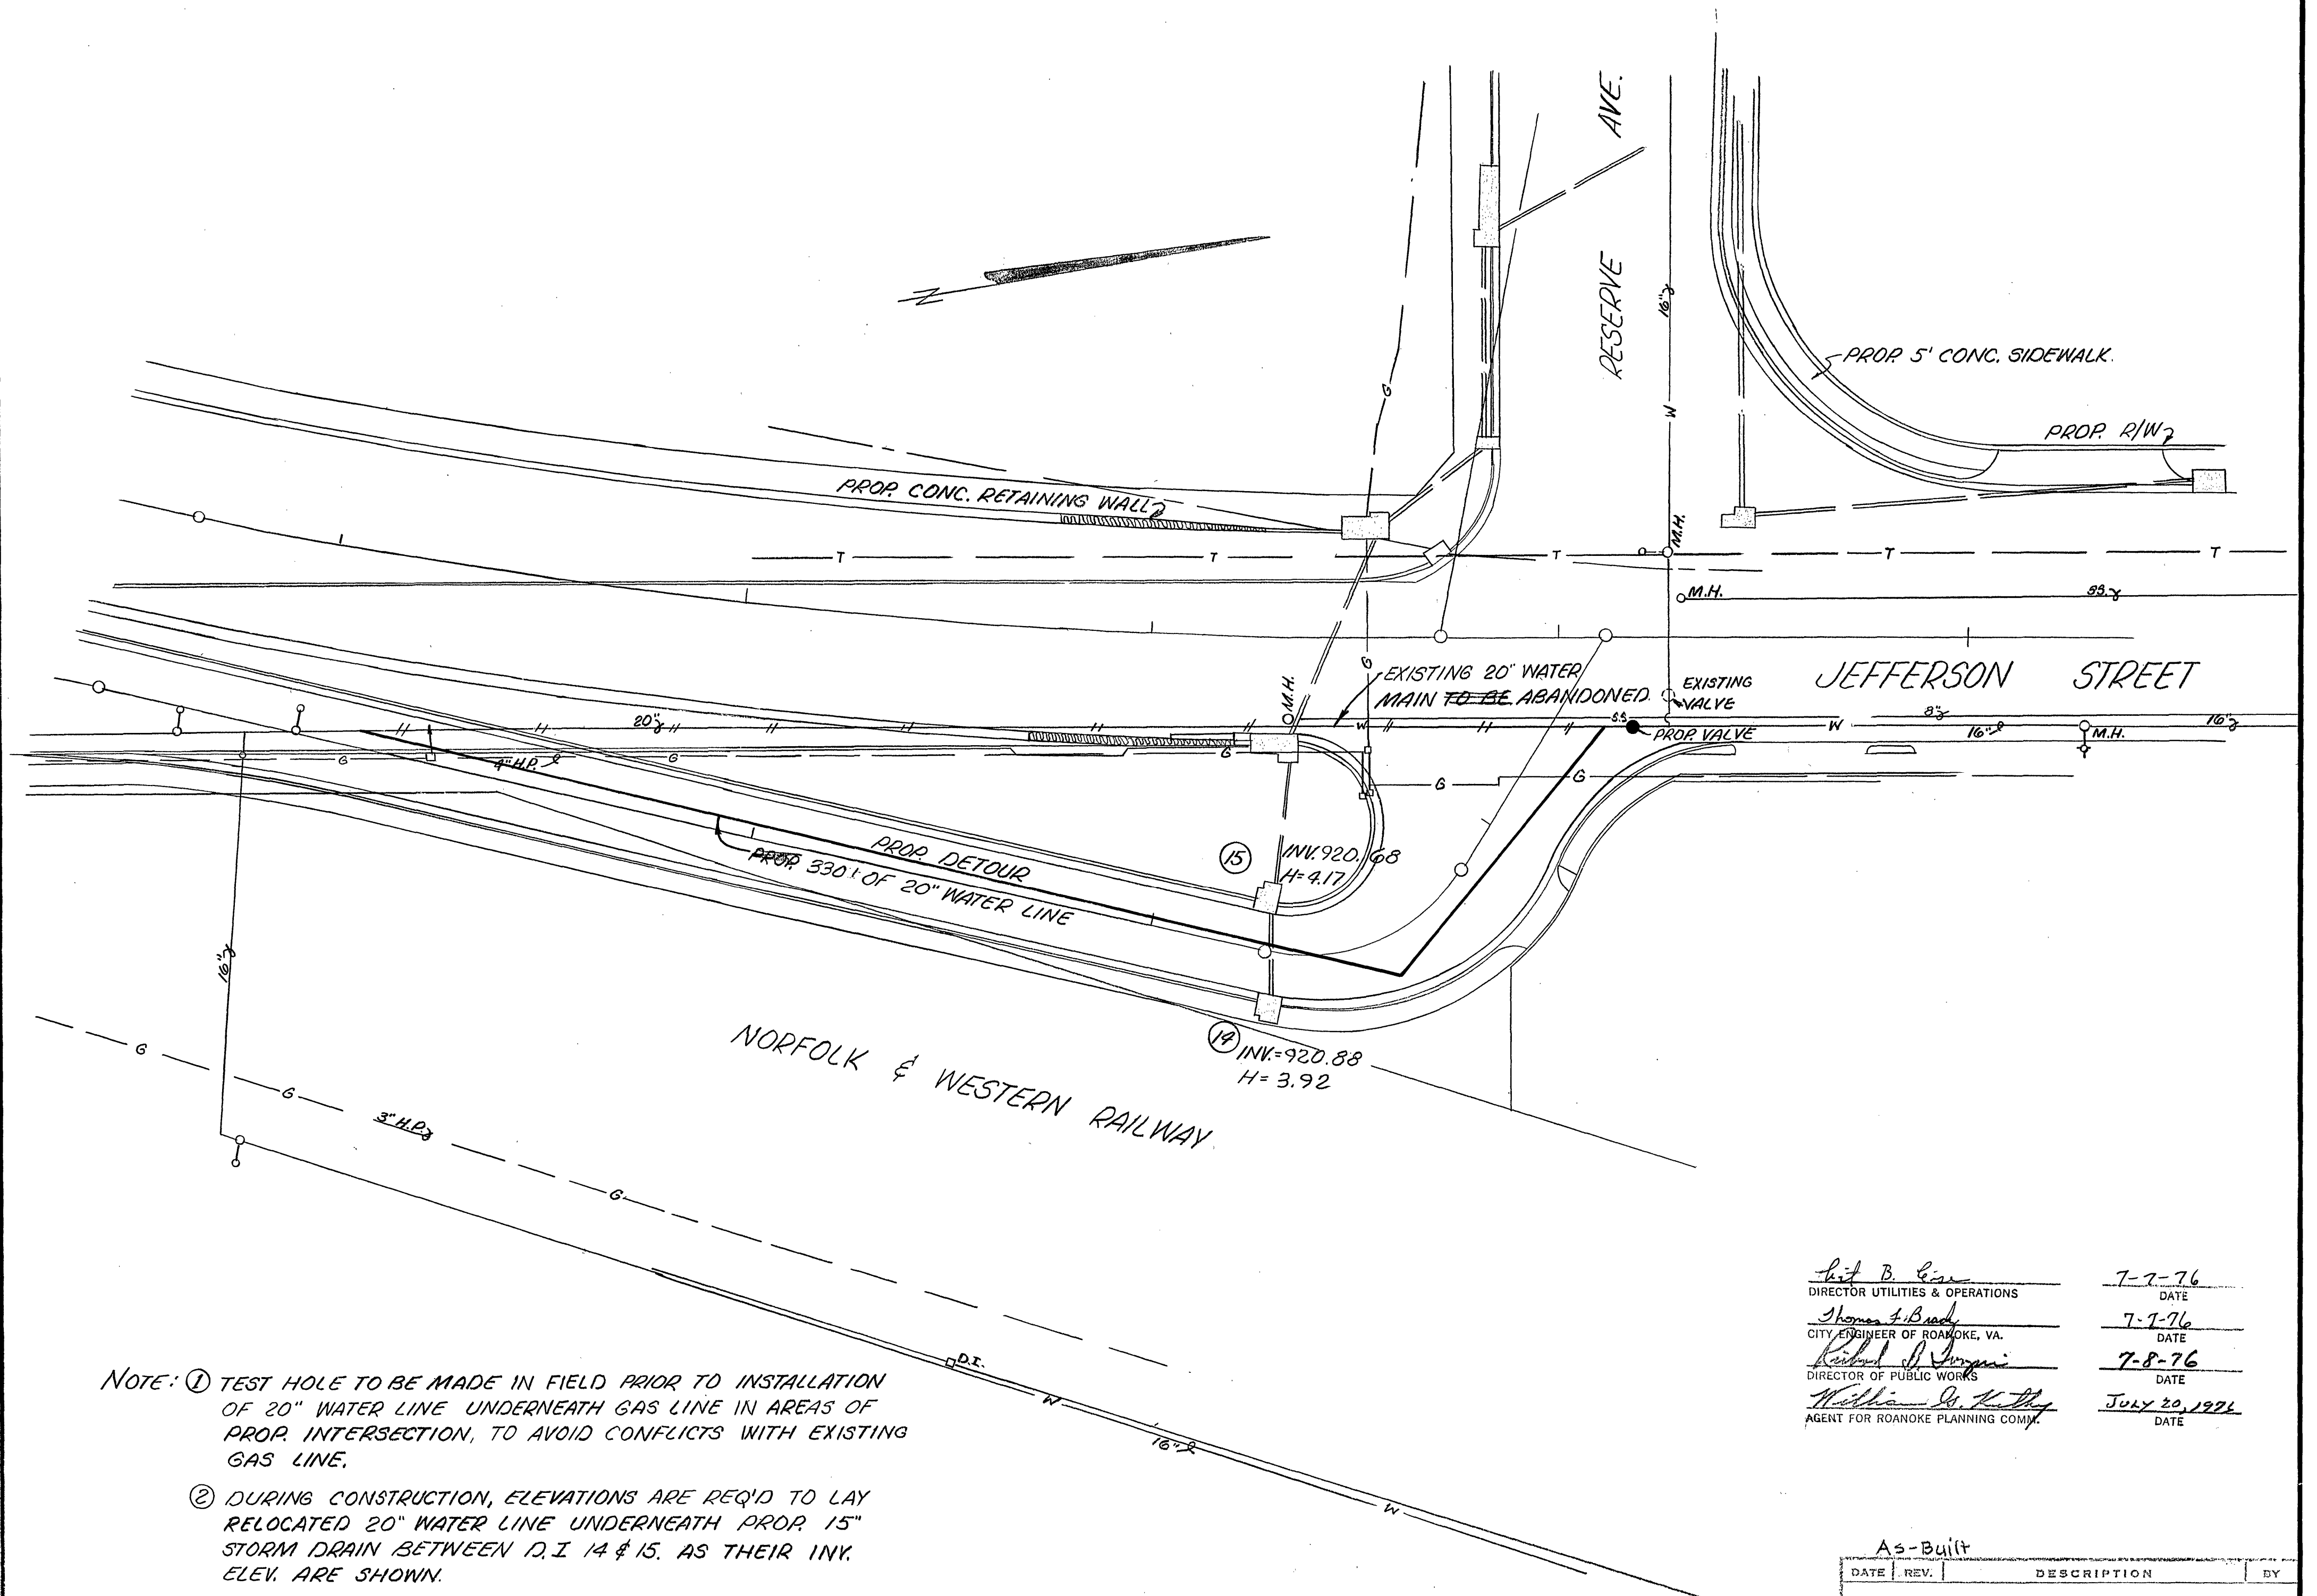

- NOTE: ① TEST HOLE TO BE MADE IN FIELD PRIOR TO INSTALLATION OF 20" WATER LINE UNDERNEATH GAS LINE IN AREAS OF PROP. INTERSECTION, TO AVOID CONFLICTS WITH EXISTING GAS LINE.
- ② DURING CONSTRUCTION, ELEVATIONS ARE REQ'D TO LAY RELOCATED 20" WATER LINE UNDERNEATH PROP. 15" STORM DRAIN BETWEEN D.I. 14 & 15. AS THEIR INV. ELEV. ARE SHOWN.

<i>Pat B. Ginn</i>	7-7-76
DIRECTOR UTILITIES & OPERATIONS	DATE
<i>Thomas L. Brady</i>	7-7-76
CITY ENGINEER OF ROANOKE, VA.	DATE
<i>Richard J. Sargent</i>	7-8-76
DIRECTOR OF PUBLIC WORKS	DATE
<i>William D. Kelly</i>	JULY 20, 1976
AGENT FOR ROANOKE PLANNING COMM.	DATE

U.W.M. ABANDON 300' OF 20" MAIN 11-5-76

As-Built			
DATE	REV.	DESCRIPTION	BY
CITY ENGINEER			
DRAWN			CITY ENGINEER
CHECKED			
APPROD			
DATE			
JOB NO.			76-14
SHEET			1
CITY OF ROANOKE OFFICE OF CITY ENGINEER ROANOKE, VIRGINIA			
CONTRACTOR MUST VERIFY ALL DIMENSIONS AT PROJECT BEFORE PROCEEDING WITH WORK			