



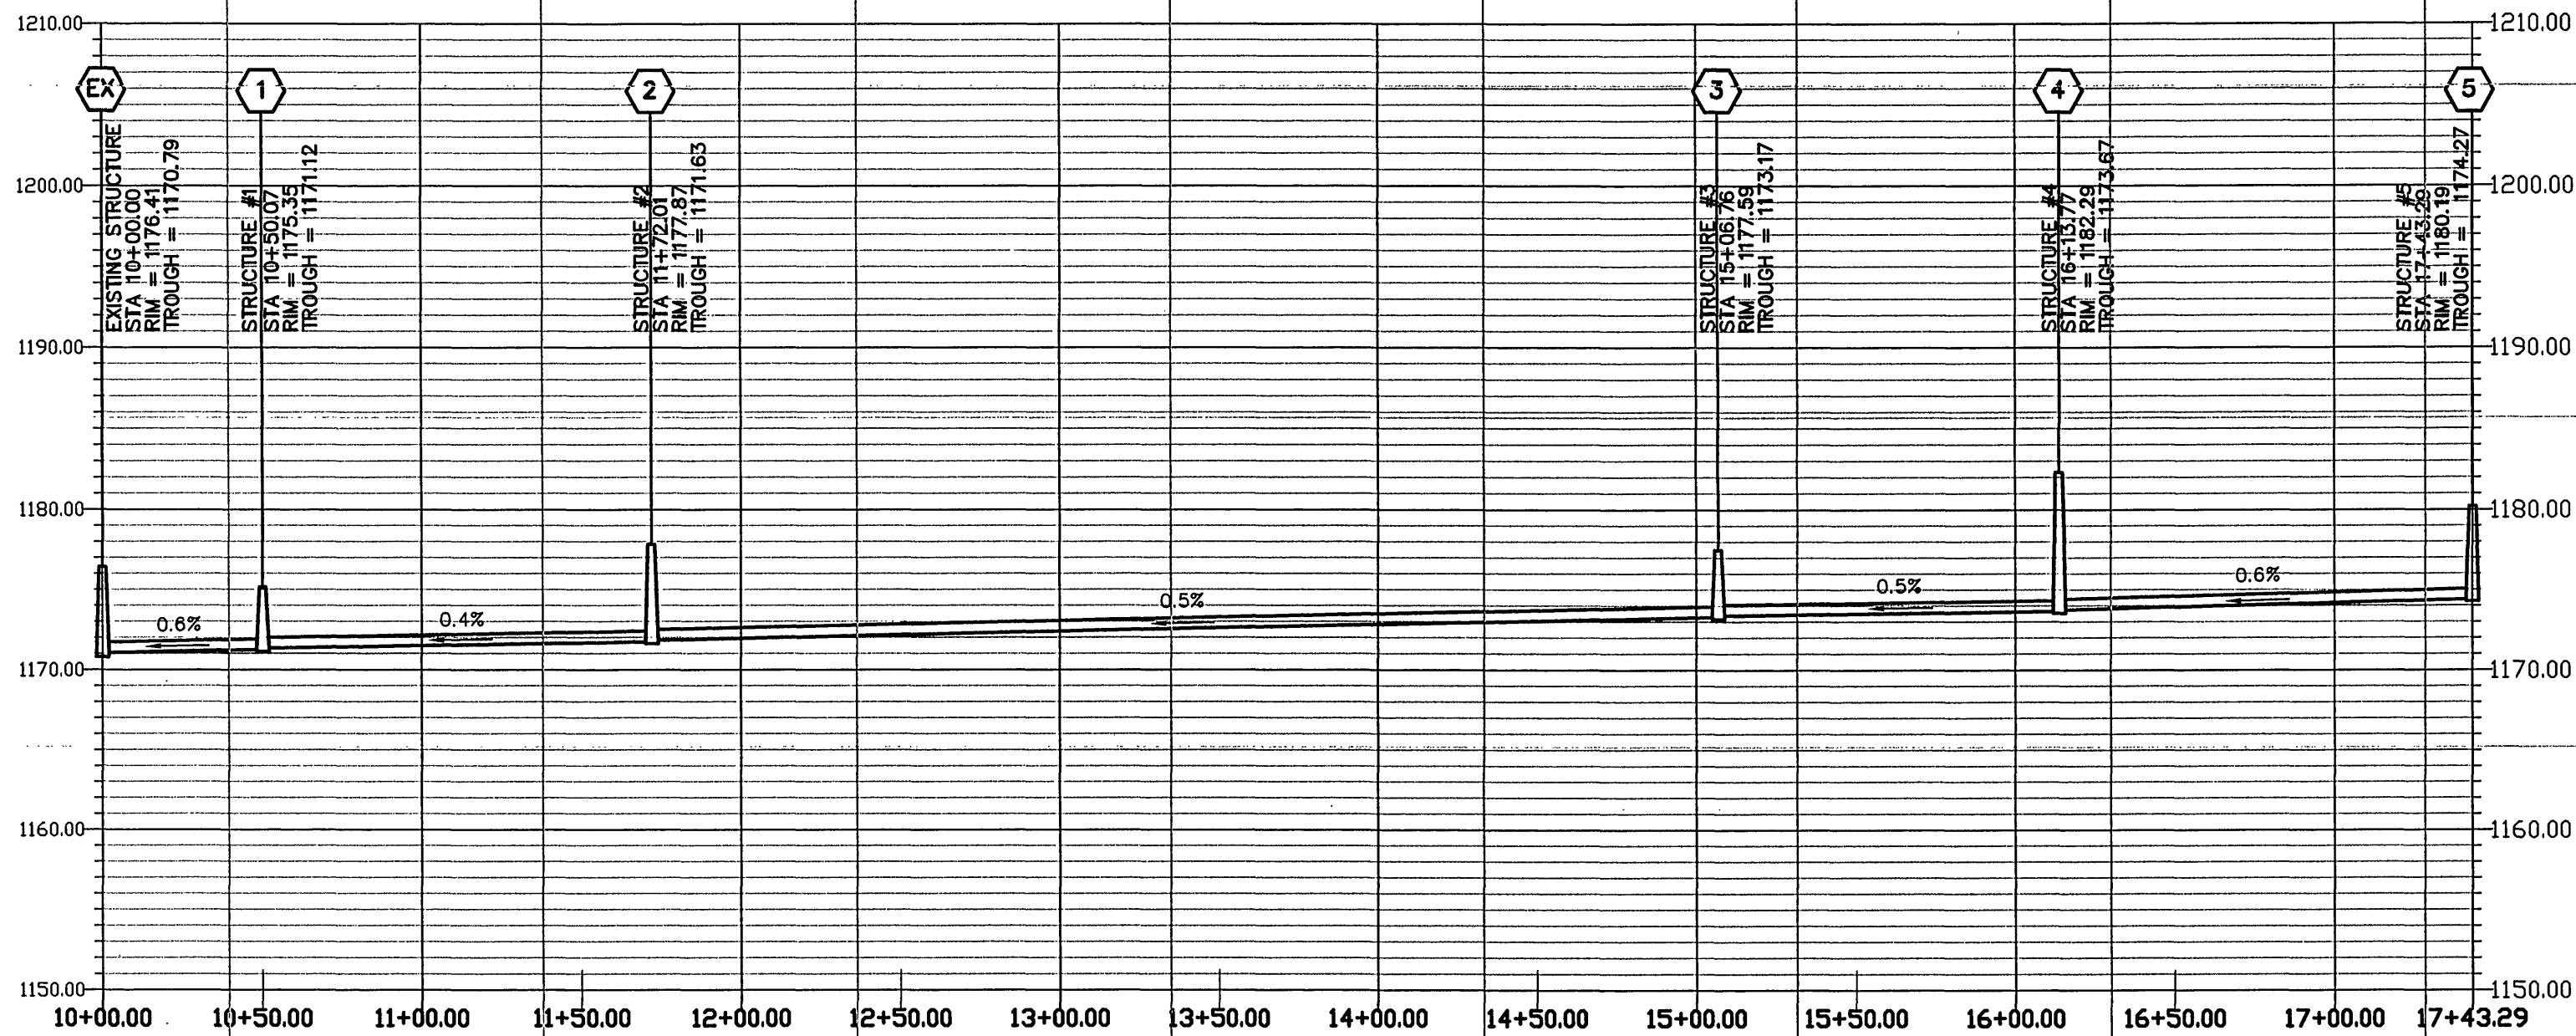

ASBUILT SANITARY SEWER PROFILE
SCALE: 1"=50' HORIZONTAL, 1"=10' VERTICAL


NOTE:
MANHOLES HAD OFFSET INVERTS AND THE ELEVATIONS WERE UNATTAINABLE.
ELEVATIONS SHOWN ARE FOR BOTTOM OF TROUGH AT THE CENTER OF THE MANHOLE.

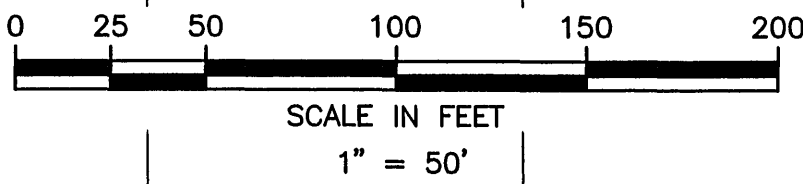

GAY AND NEEL, INC.
CIVIL ENGINEERING
LANDSCAPE ARCHITECTURE
SURVEYING
328 Mountain Avenue S.W.
Roanoke, Virginia 24016
Phone: (540) 345-1110 Fax: (540) 345-5560
Email: info@gayandneel.com

Asbuilt
Public Sanitary Sewer
Profile

Drawing Showing
Asbuilt - Public Water
and
Public Sanitary Sewer Structures
For the Western Virginia Water Authority
Keagy Village
Roanoke County, Virginia

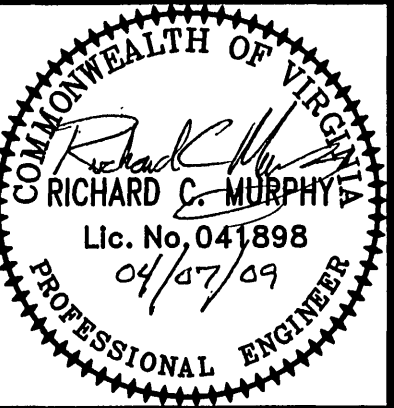

REVISED:

DESIGNED/CALC.: RCM
CHECKED: PLJ
DRAWN: PLJ
SCALE: 1" = 50'
DATE: 04/07/09

JOB NO. 1560.0

SHEET 2 OF 2