


PRE-CONSTRUCTION MEETING AND CONSTRUCTION COMMENCEMENT:

- VIRGINIA DEPARTMENT OF TRANSPORTATION

NAME OF DEVELOPMENT	Kessler Mill Road Sewer Extension		I, <u>Carroll J. Miles, Sr.</u> OWNER/DEVELOPER, AM AWARE OF THE SITE DESIGN REQUIREMENTS IMPOSED BY THIS SITE DEVELOPMENT PLAN AND OTHER APPLICABLE ROANOKE COUNTY CODES. I HEREBY CERTIFY THAT I AGREE TO COMPLY WITH THESE REQUIREMENTS AND THE THIRTY (30) POINTS SHOWN ON THIS COVER SHEET UNLESS MODIFIED IN ACCORDANCE WITH LOCAL LAW.
MAGISTERIAL DISTRICT(S)	Catawba Magisterial District		
OWNER (name, address, telephone)	Everett J Miles, Sr. C/o Hanging Rock Properties, Inc, 1812 Thompson Memorial Drive, Roanoke, VA 24019		
DEVELOPER (name, address, telephone)	E.J. Miles, Sr., Green Planet, Inc, WVVA, & Roanoke County		
ENGINEER, ARCHITECT OR SURVEYOR (name, address, telephone)	ACS DESIGN 2203 Peters Creek Road Roanoke, Virginia 24017	Ph: 540-562-2345 Fax: 540-562-2344 Email: dearly@acsdesignllc.com	
TAX MAP NO(S)	36.01-02-03.00, 36.03-1-62, 36.03-1-1.2, & 36.03-1-1.1		

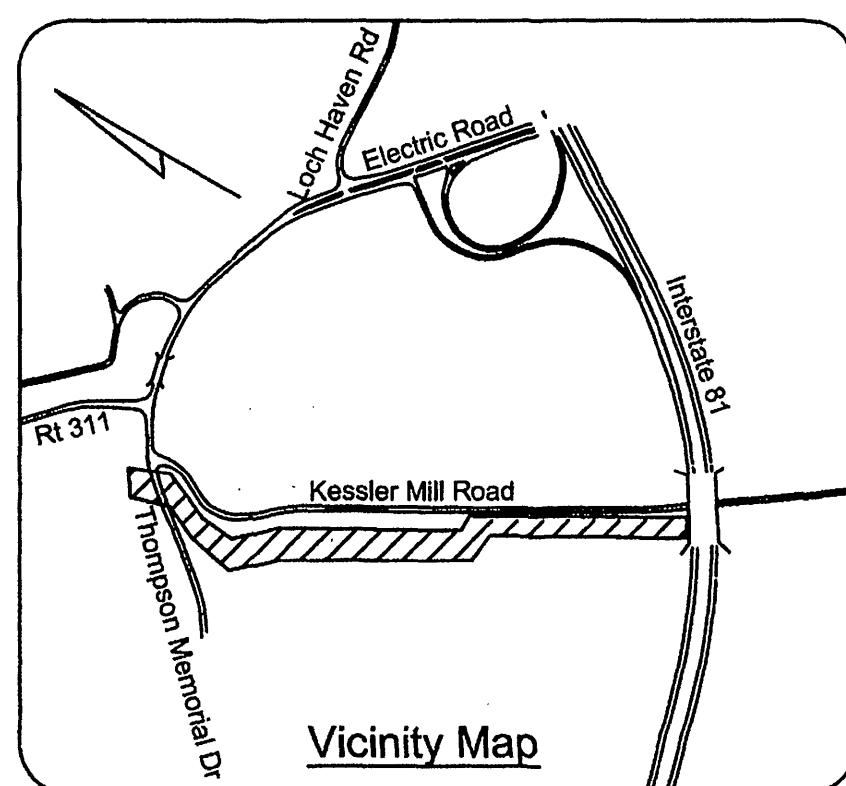

C1.0	Cover Sheet
C1.2	Plan Sheet Layout & Notes
C2.1	Erosion Control Notes & Details
C3.1	Gravity Sewer Plan & Profile
C3.2	Gravity Sewer Plan & Profile
C3.3	Gravity Sewer Plan & Profile
C3.4	Sanitary Sewer Details
C3.5	Sanitary Sewer Details

N/A	
Executive Director of Water	Date
Michael J. McEvoy	10/29/09
Executive Director of Wastewater	Date
[Signature]	10.29.09
Director of Engineering Services	Date

QUANTITY & COST ESTIMATE

I HEREBY CERTIFY THAT THE FOREGOING ESTIMATE REFLECTS THE CURRENT IMPROVEMENT COSTS OF THIS PROJECT.

SIGNED: 1/21/2011 DATE: 1/21/2011


As-Built 3.19.10 K. Winslow

ACS DESIGN

**ENGINEERING - SURVEYING
PLANNING
CONSTRUCTION MANAGEMENT**

2203 PETERS CREEK ROAD
ROANOKE, VIRGINIA 24017
P 540.562.2345 F 562.2344
INFO@ACSDSIGNLLC.COM
WWW.ACSDSIGNLLC.COM

Approved
Kessler Mill Road Sewer Ext.
SP-0902470

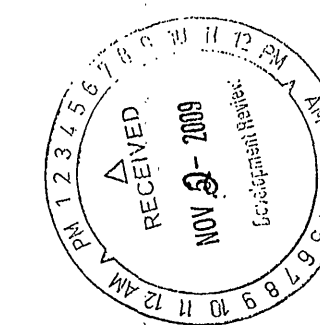

Date	Review	Comments	Action & Zoning
08/11/09		P/LA WZC9	
07/11/09		B-1	
11/2/09			WZC9

APPROVED
CONSTRUCTION
JANOME COUNTY

04-61-558 Siamos blvd

Kessler Mill Road Sewer Extension

AS - BUILT

SHEET

C1.0