


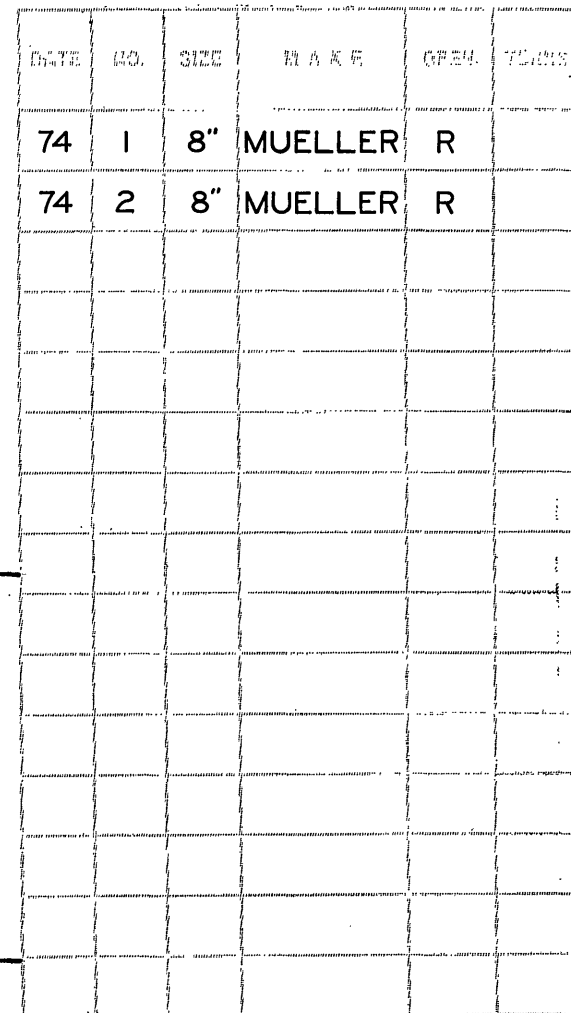

11/2000 JH