


AS BUILT

FORCE MAIN SANITARY SEWER EXTENSION

ALONG VA SEC. RT. 653, ROANOKE, VIRGINIA

King Street

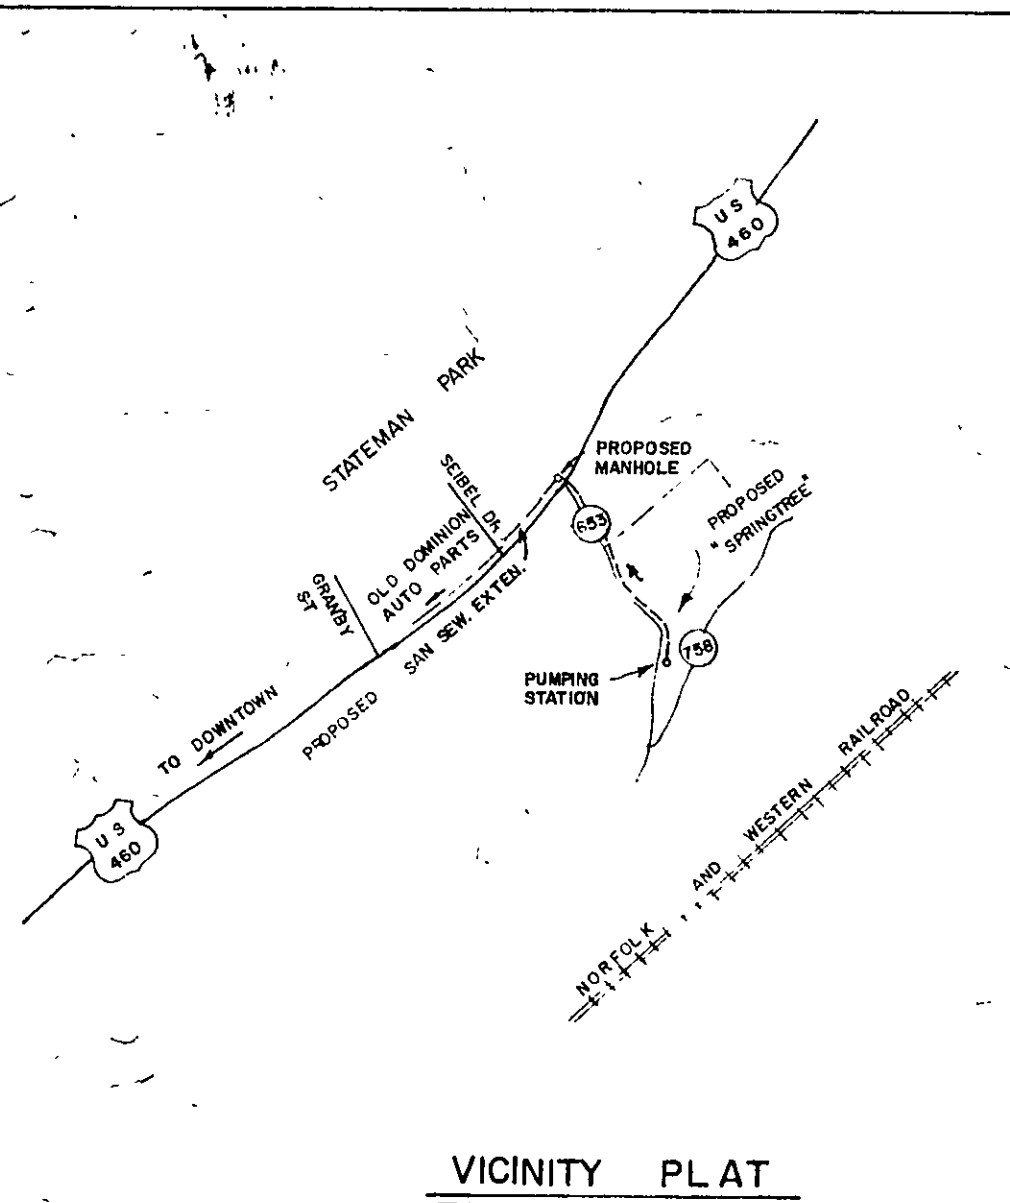

VICINITY PLAT

NOTE:
SEWER LINE CONSTRUCTION TO MEET THE RULES
AND REGULATIONS AND CONSTRUCTION SPECIFICATIONS
AND STANDARDS OF ROANOKE COUNTY PUBLIC SERVICE
AUTHORITY AS AMENDED TO DATE

APPROVED:


ROANOKE COUNTY PUBLIC
SERVICE AUTHORITY

DATE

CITY ENGINEER, ROANOKE, VA.

DATE

OCTOBER 20, 1976

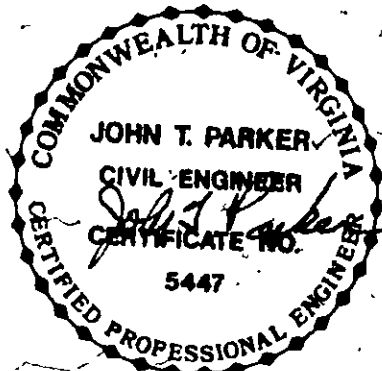

DRAWN BY: RJB	REVISIONS			BY
	DATE	REMARKS		
C.K.D. BY: JTP	11-5-76	GENERAL REVISIONS		RJB
	11/12/76	OMIT SHEET 7 OF 7		RJB
APPROVED:	2/10/77	GENERAL REVISIONS		RJB
	7/14/78	DELETE HATCHING BASIN, ADD EMERGENCY GENERATOR		RJB
DATE:				

T. P. PARKER & SON
engineers & surveyors

TELEPHONE (703) 387-1153
P.O. BOX 367, SALEM, VIRGINIA, 24153

AS BUILT

SHEET

OF

6