


DEVELOPMENT PLAN
FOR
SECTION No. 3
"KINGS CREST"

SITUATED IN
CATAWBA MAGISTERIAL DISTRICT
ROANOKE COUNTY, VIRGINIA

DATE: 29 MARCH 2004

PREPARED FOR
FRALIN & WALDRON, INC.

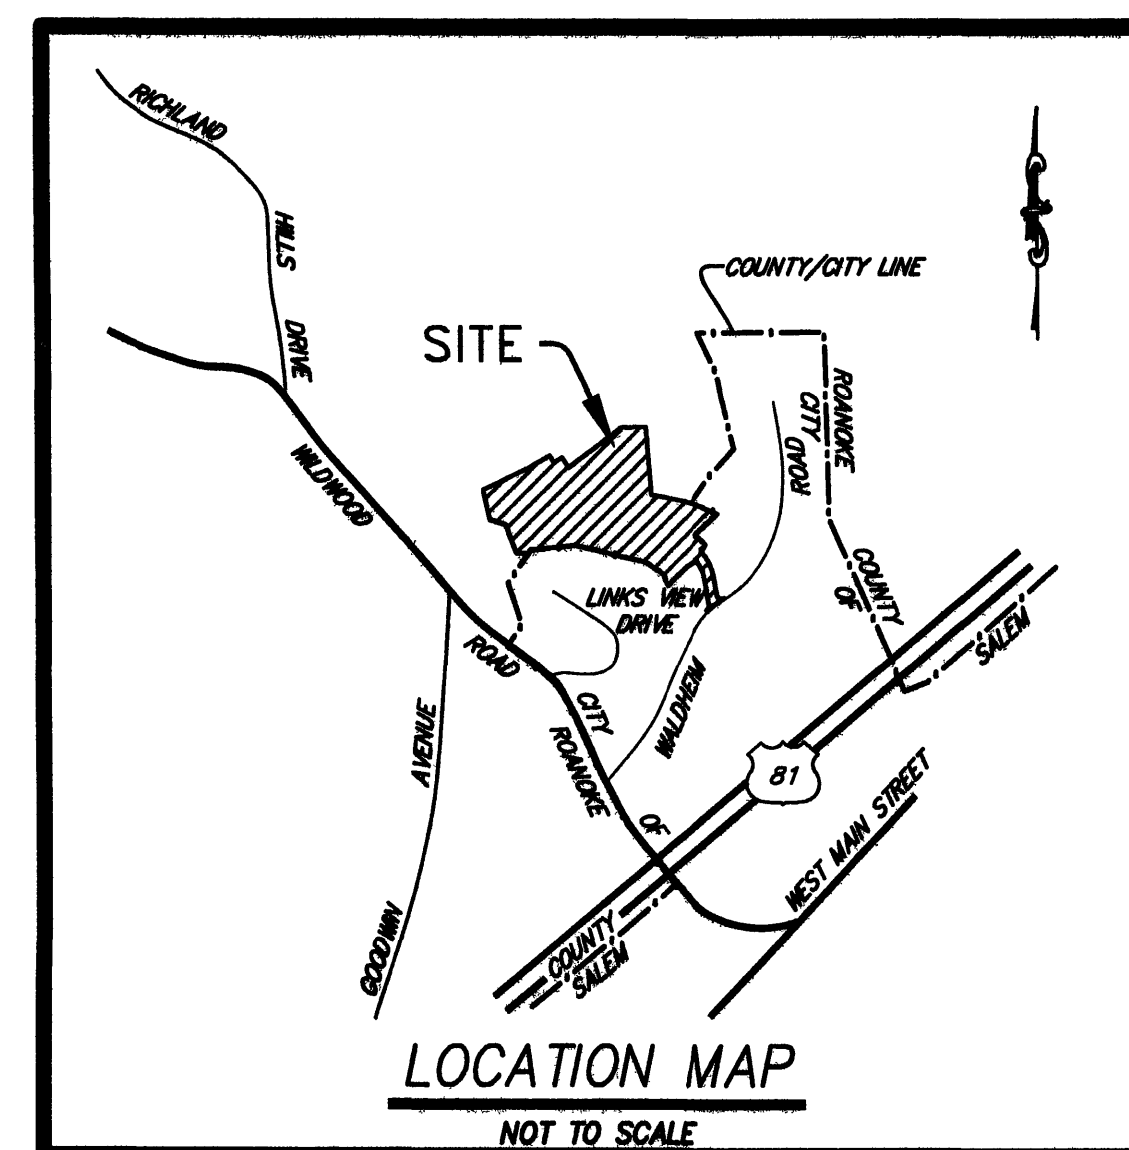

--INDEX OF DRAWINGS--
SHEET No. DESCRIPTION

1. LUMSDEN ASSOCIATES COVER SHEET
2. ROANOKE COUNTY STANDARD COVER SHEET
3. RECORD PLAT
4. SCOPE OF CONSTRUCTION
5. ROANOKE COUNTY STANDARD EROSION
CONTROL DETAIL SHEET

I AM CERTIFIED BY THE STATE OF VIRGINIA AS A "RESPONSIBLE LAND
DISTURBER". I SHALL BE RESPONSIBLE FOR THE IMPLEMENTATION OF
THE EROSION AND SEDIMENT CONTROL PLAN AS SHOWN.

SIGNATURE:
PRINTED NAME:
CERTIFICATE No.:
EXPIRATION DATE:
TELEPHONE No.:
ADDRESS:
. . . .
. . . .



LUMSDEN ASSOCIATES, P.C.
ENGINEERS-SURVEYORS-PLANNERS

4664 BRAMBLETON AVENUE, SW
P.O. BOX 20669
ROANOKE, VIRGINIA 24018

PHONE: (540) 774-4411
FAX: (540) 772-9445
E-MAIL: MAIL@LUMSDENPC.COM

"As-Built"

1. Water and sewer "As-Built" information taken from
plans furnished by J. P. Turner and Sons, Inc.,
contractor.
2. "As- Built dimensions are shown in brackets.

REVISIONS	
DATE	SHEETS
3/1/04	4 As-Built
10/2005	Project Completed
COMMISSION NO.	04 073
SHEET 1 OF 5	