



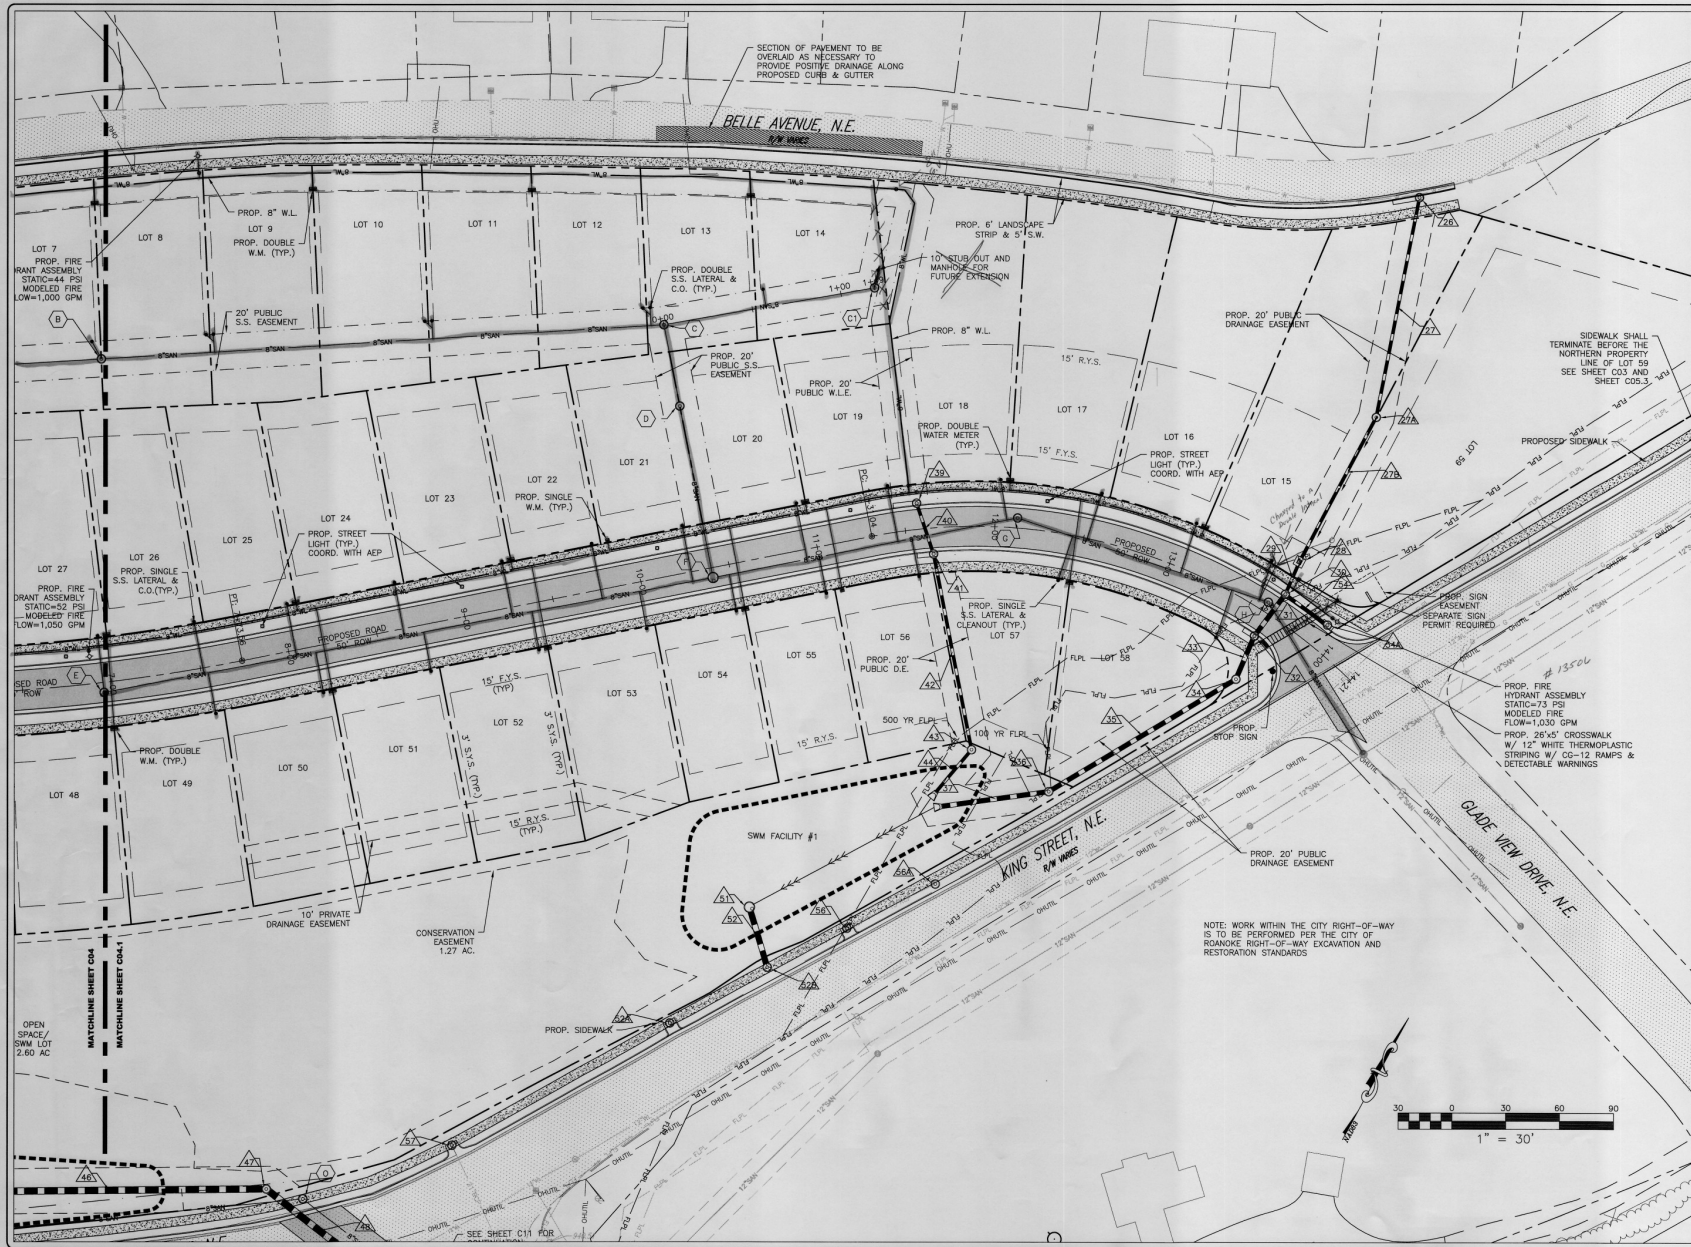

BALZER & ASSOCIATES
PLANNERS / ARCHITECTS
ENGINEERS / SURVEYORS
Roanoke / Richmond
New River Valley / Staunton
Harrisonburg / Lynchburg
www.balzer.cc

1208 Corporate Circle
Roanoke, VA 24018
540.772.9980

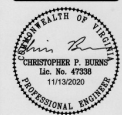

City of Roanoke
Planning, Building, & Development
COMPREHENSIVE DEVELOPMENT PLAN
APPROVED
by Aaron Cypher 03/02/2021

KING'S WALK

LAYOUT & UTILITY PLAN

DRAWN BY SMD
DESIGNED BY CPB
CHECKED BY BTC
DATE 1/28/2020
SCALE 1" = 30'
REVISIONS
7/19/2020
8/6/2020
11/13/2020

C04.1
PROJECT NO. 0418018.01