


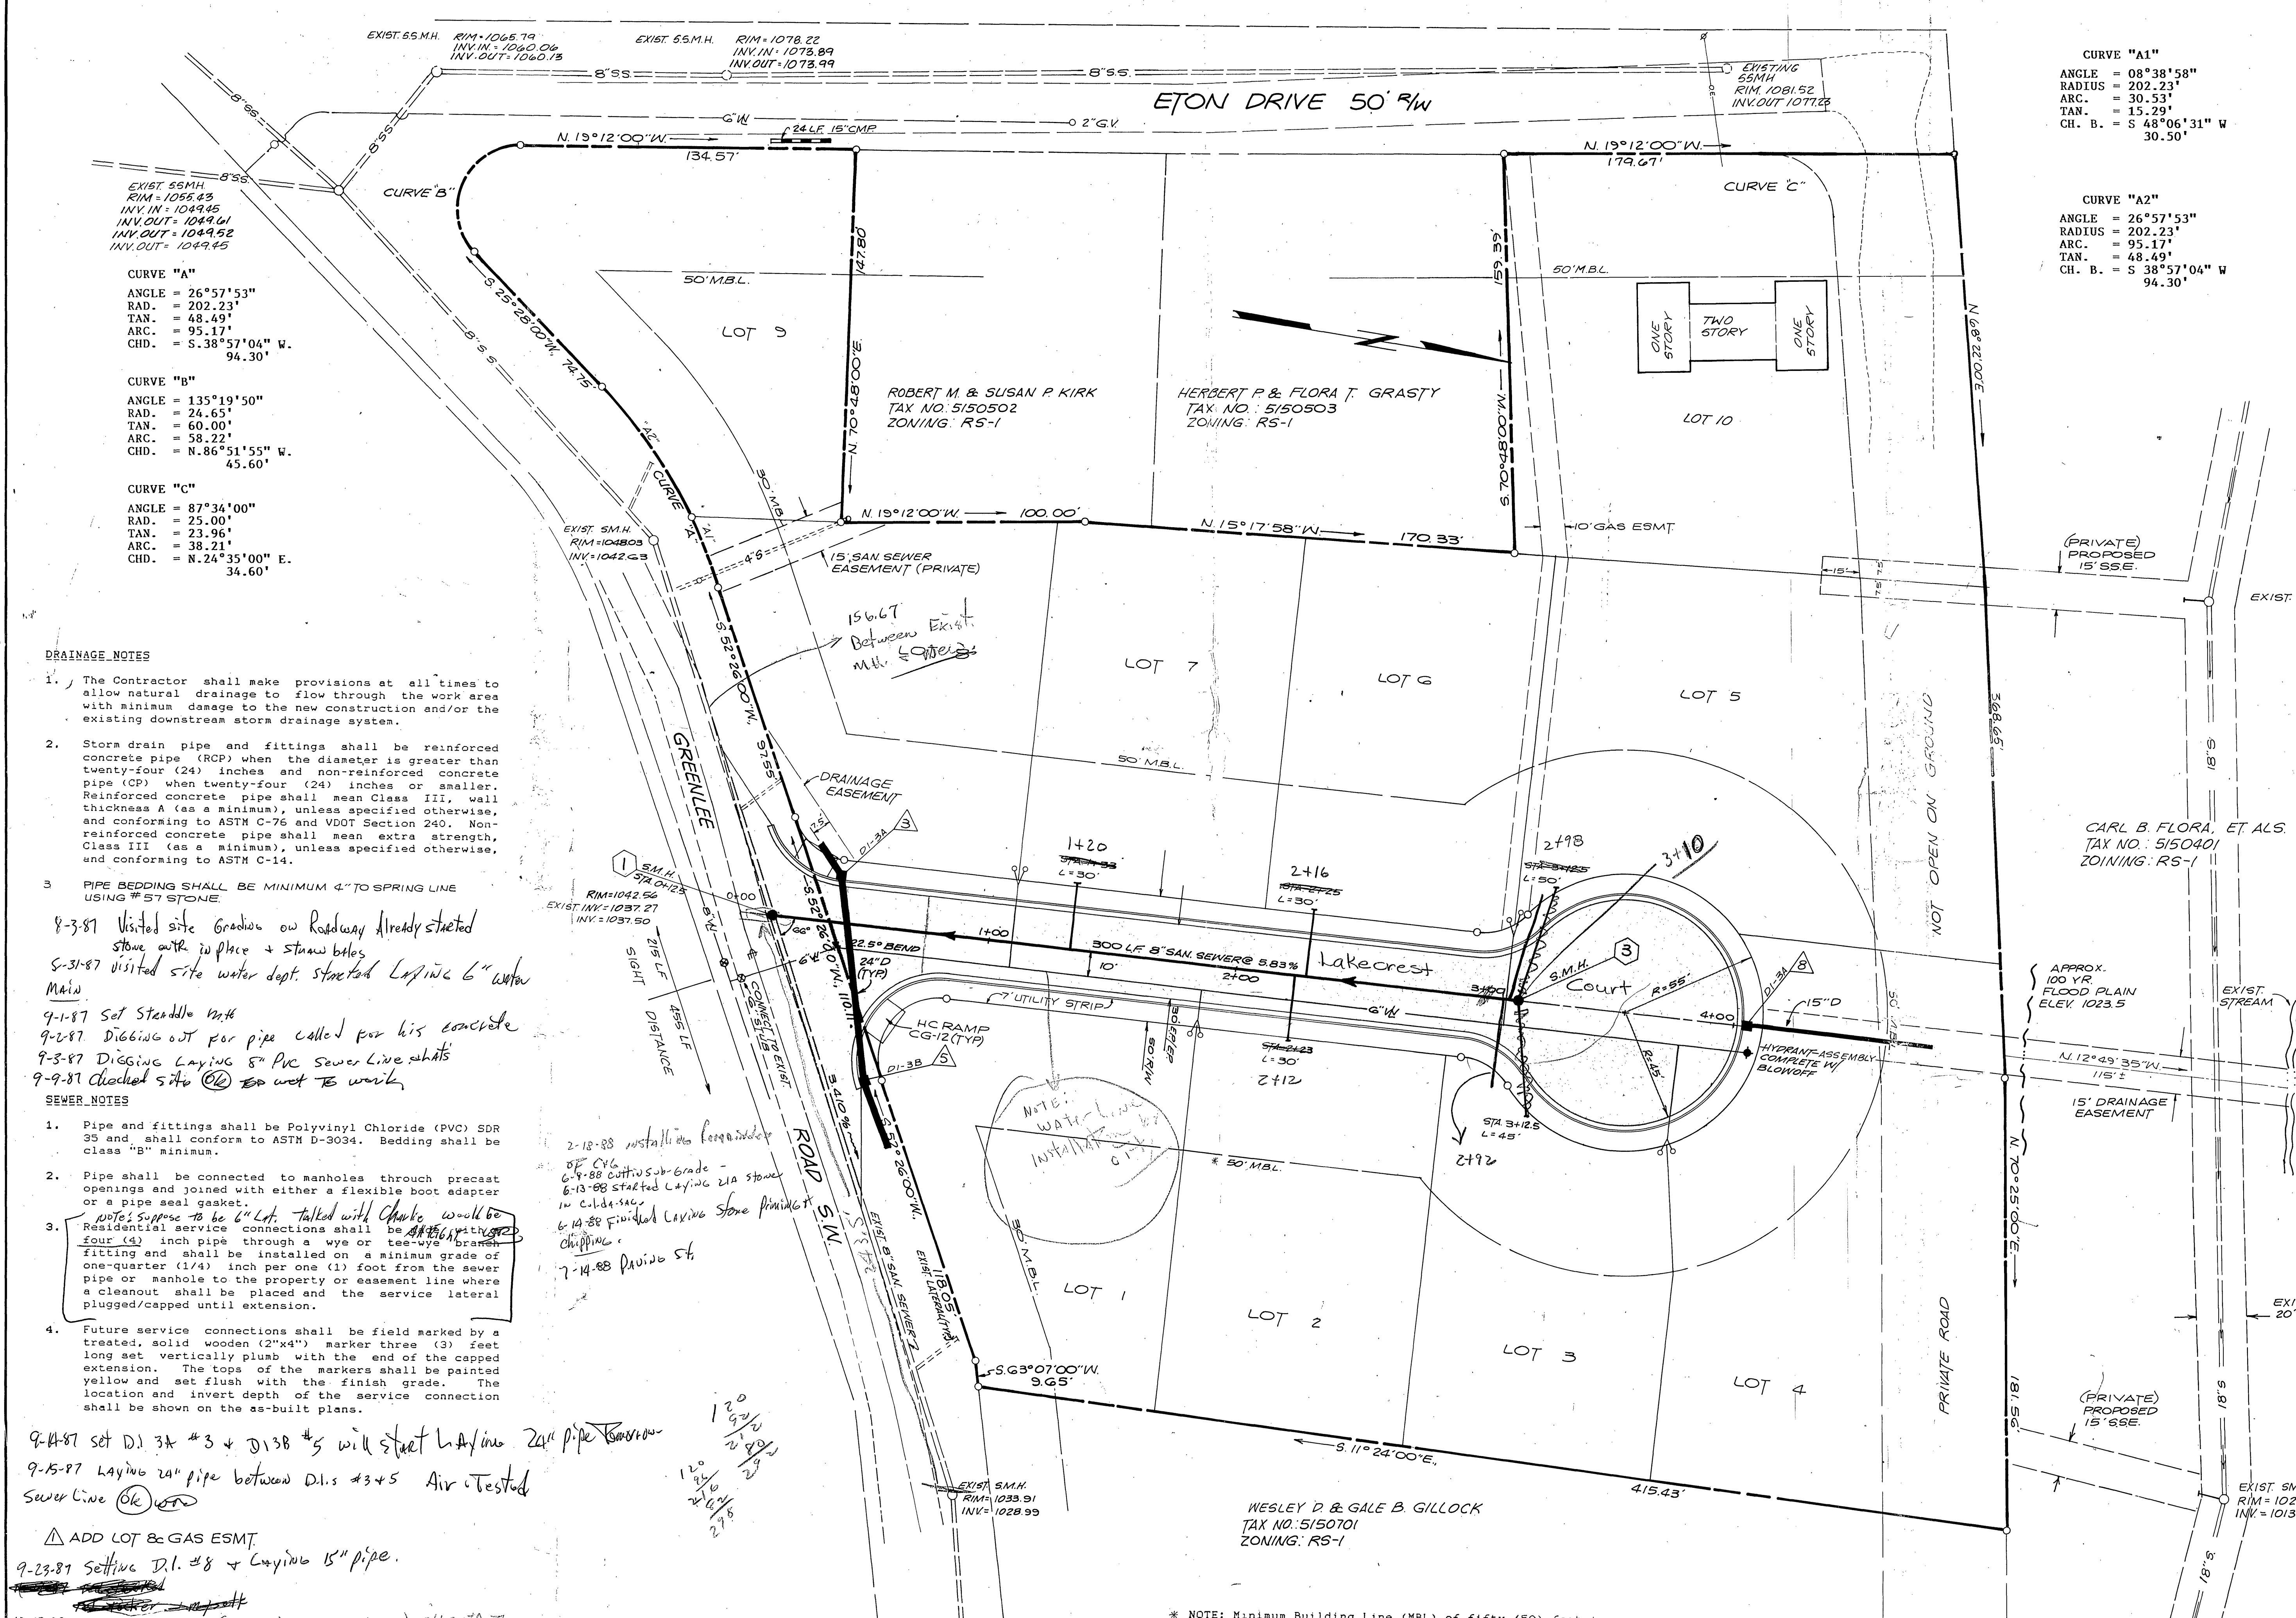

SITE & UTILITY PLAN

* NOTE: Minimum Building Line (MBL) of fifty (50) feet is a deed restriction. Ref. DB 906 PG 17 dated Jan. 31, 1972.