


LANDMARK BUILDING
129 SALEM AVE SW
T# 1010419 - LOT BA

As Built

[Signature]

11-14-08

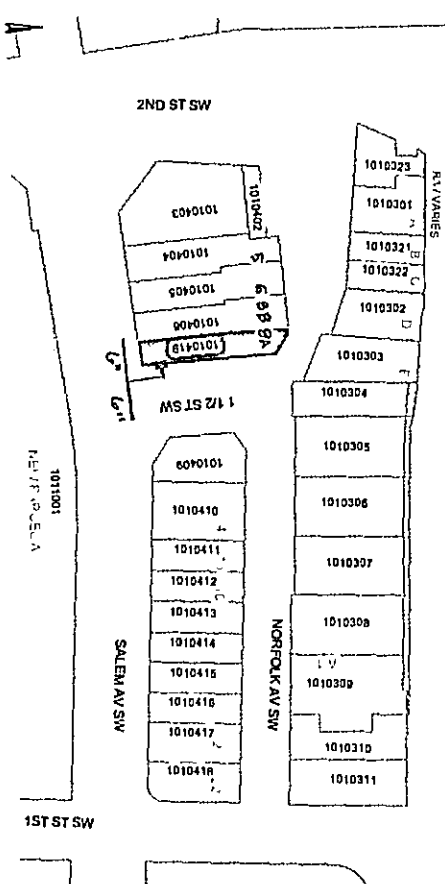

Salem Ave., S.W.
6" CAST IRON WATER MAIN

6"

6"

