


MATCH LINE SHEET #6

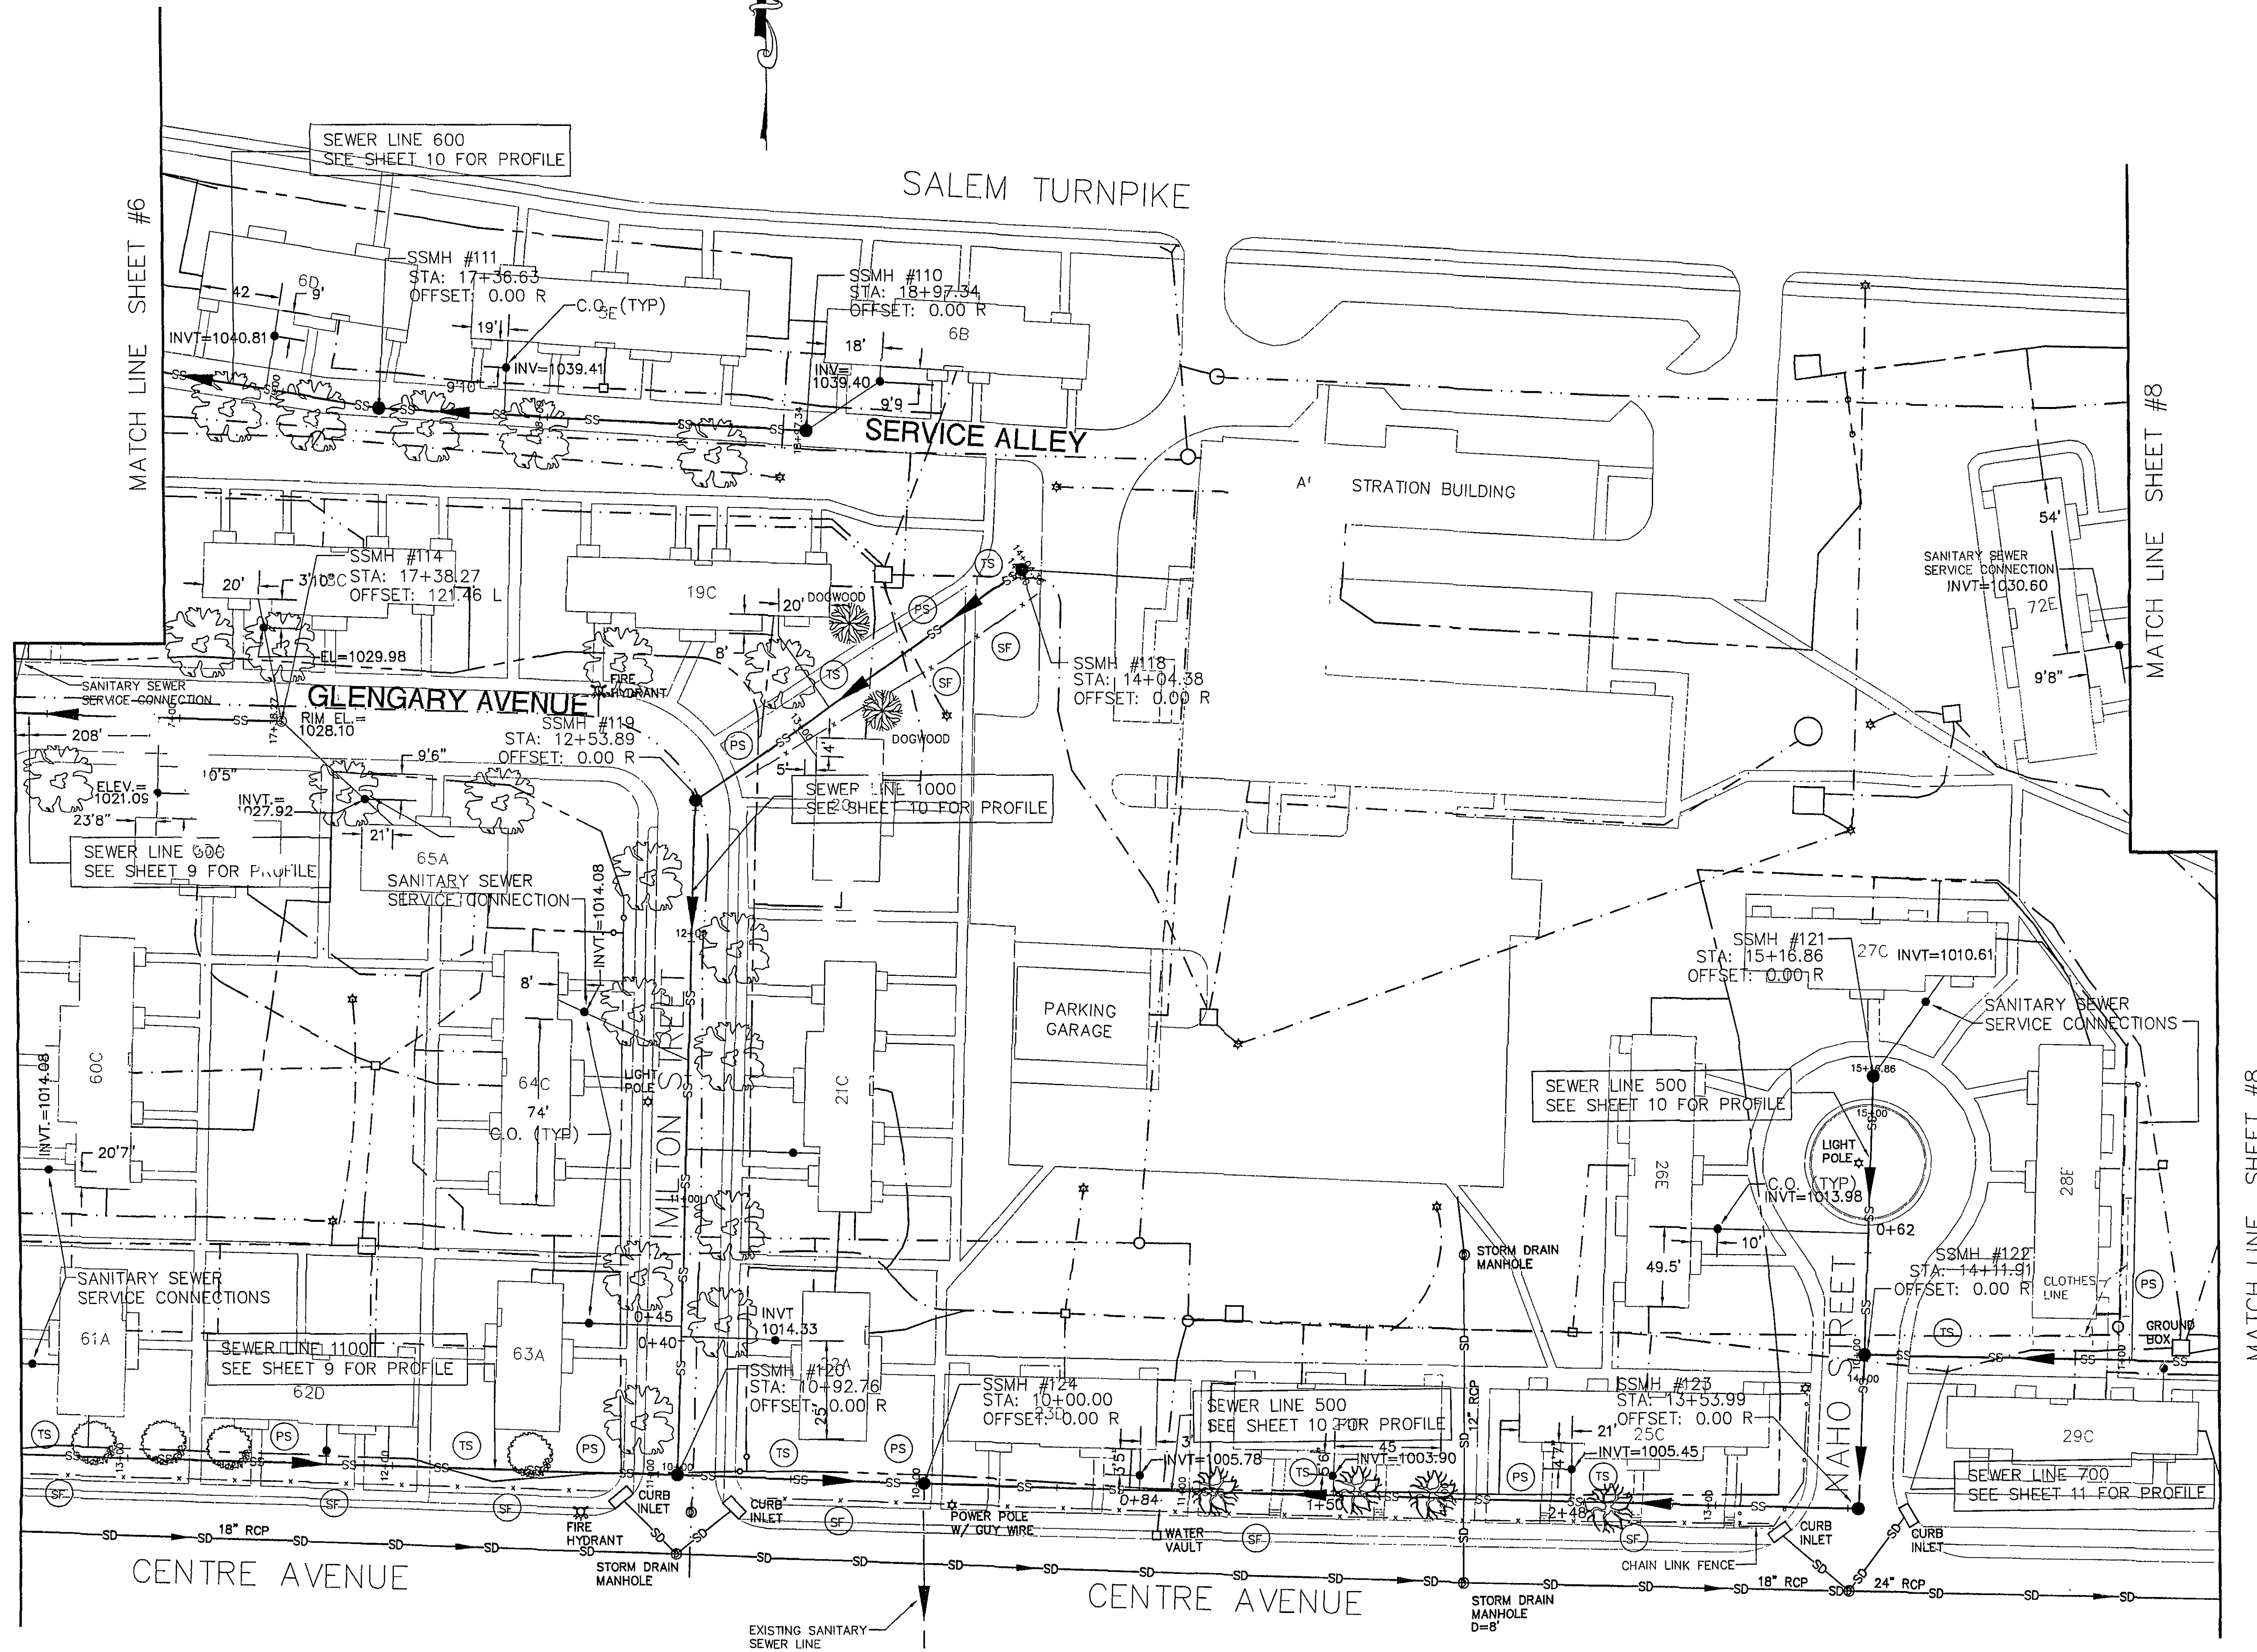


MATCH LINE SHEET #8

RECORD DRAWING

CITY OF ROANOKE
REDEVELOPMENT & HOUSING AUTHORITY
LANDSDOWNE PARK
SANITARY SEWER REPLACEMENT
CITY OF ROANOKE, VIRGINIA

NO.	DATE	DESCRIPTION	BY
1	11/25/98	RECORD DRAWING	DRM

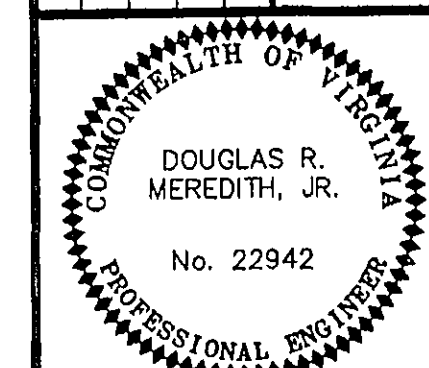

Designed By	DME/MJG
Drawn By	DME
Checked By	RCW
Approved By	RCW
Submitted By	DRM
Drawing	1136PL-2.DWG
Date	5/2/97
Scale	H: 1" = 30'
Commission No.	1136
Sheet	7 of 13

LMW P.C.

ENGINEERING-ARCHITECTURE-SURVEYING
1401 2nd STREET, S.W.
ROANOKE, VIRGINIA 24011
(540) 345-0675
FAX (540) 342-4456

1401 2nd STREET, S.W.
ROANOKE, VIRGINIA 24011
(540) 345-0675
FAX (540) 342-4456