



C:\DWGSET\1136\1136PL-3.DWG DATE: 5/1/97

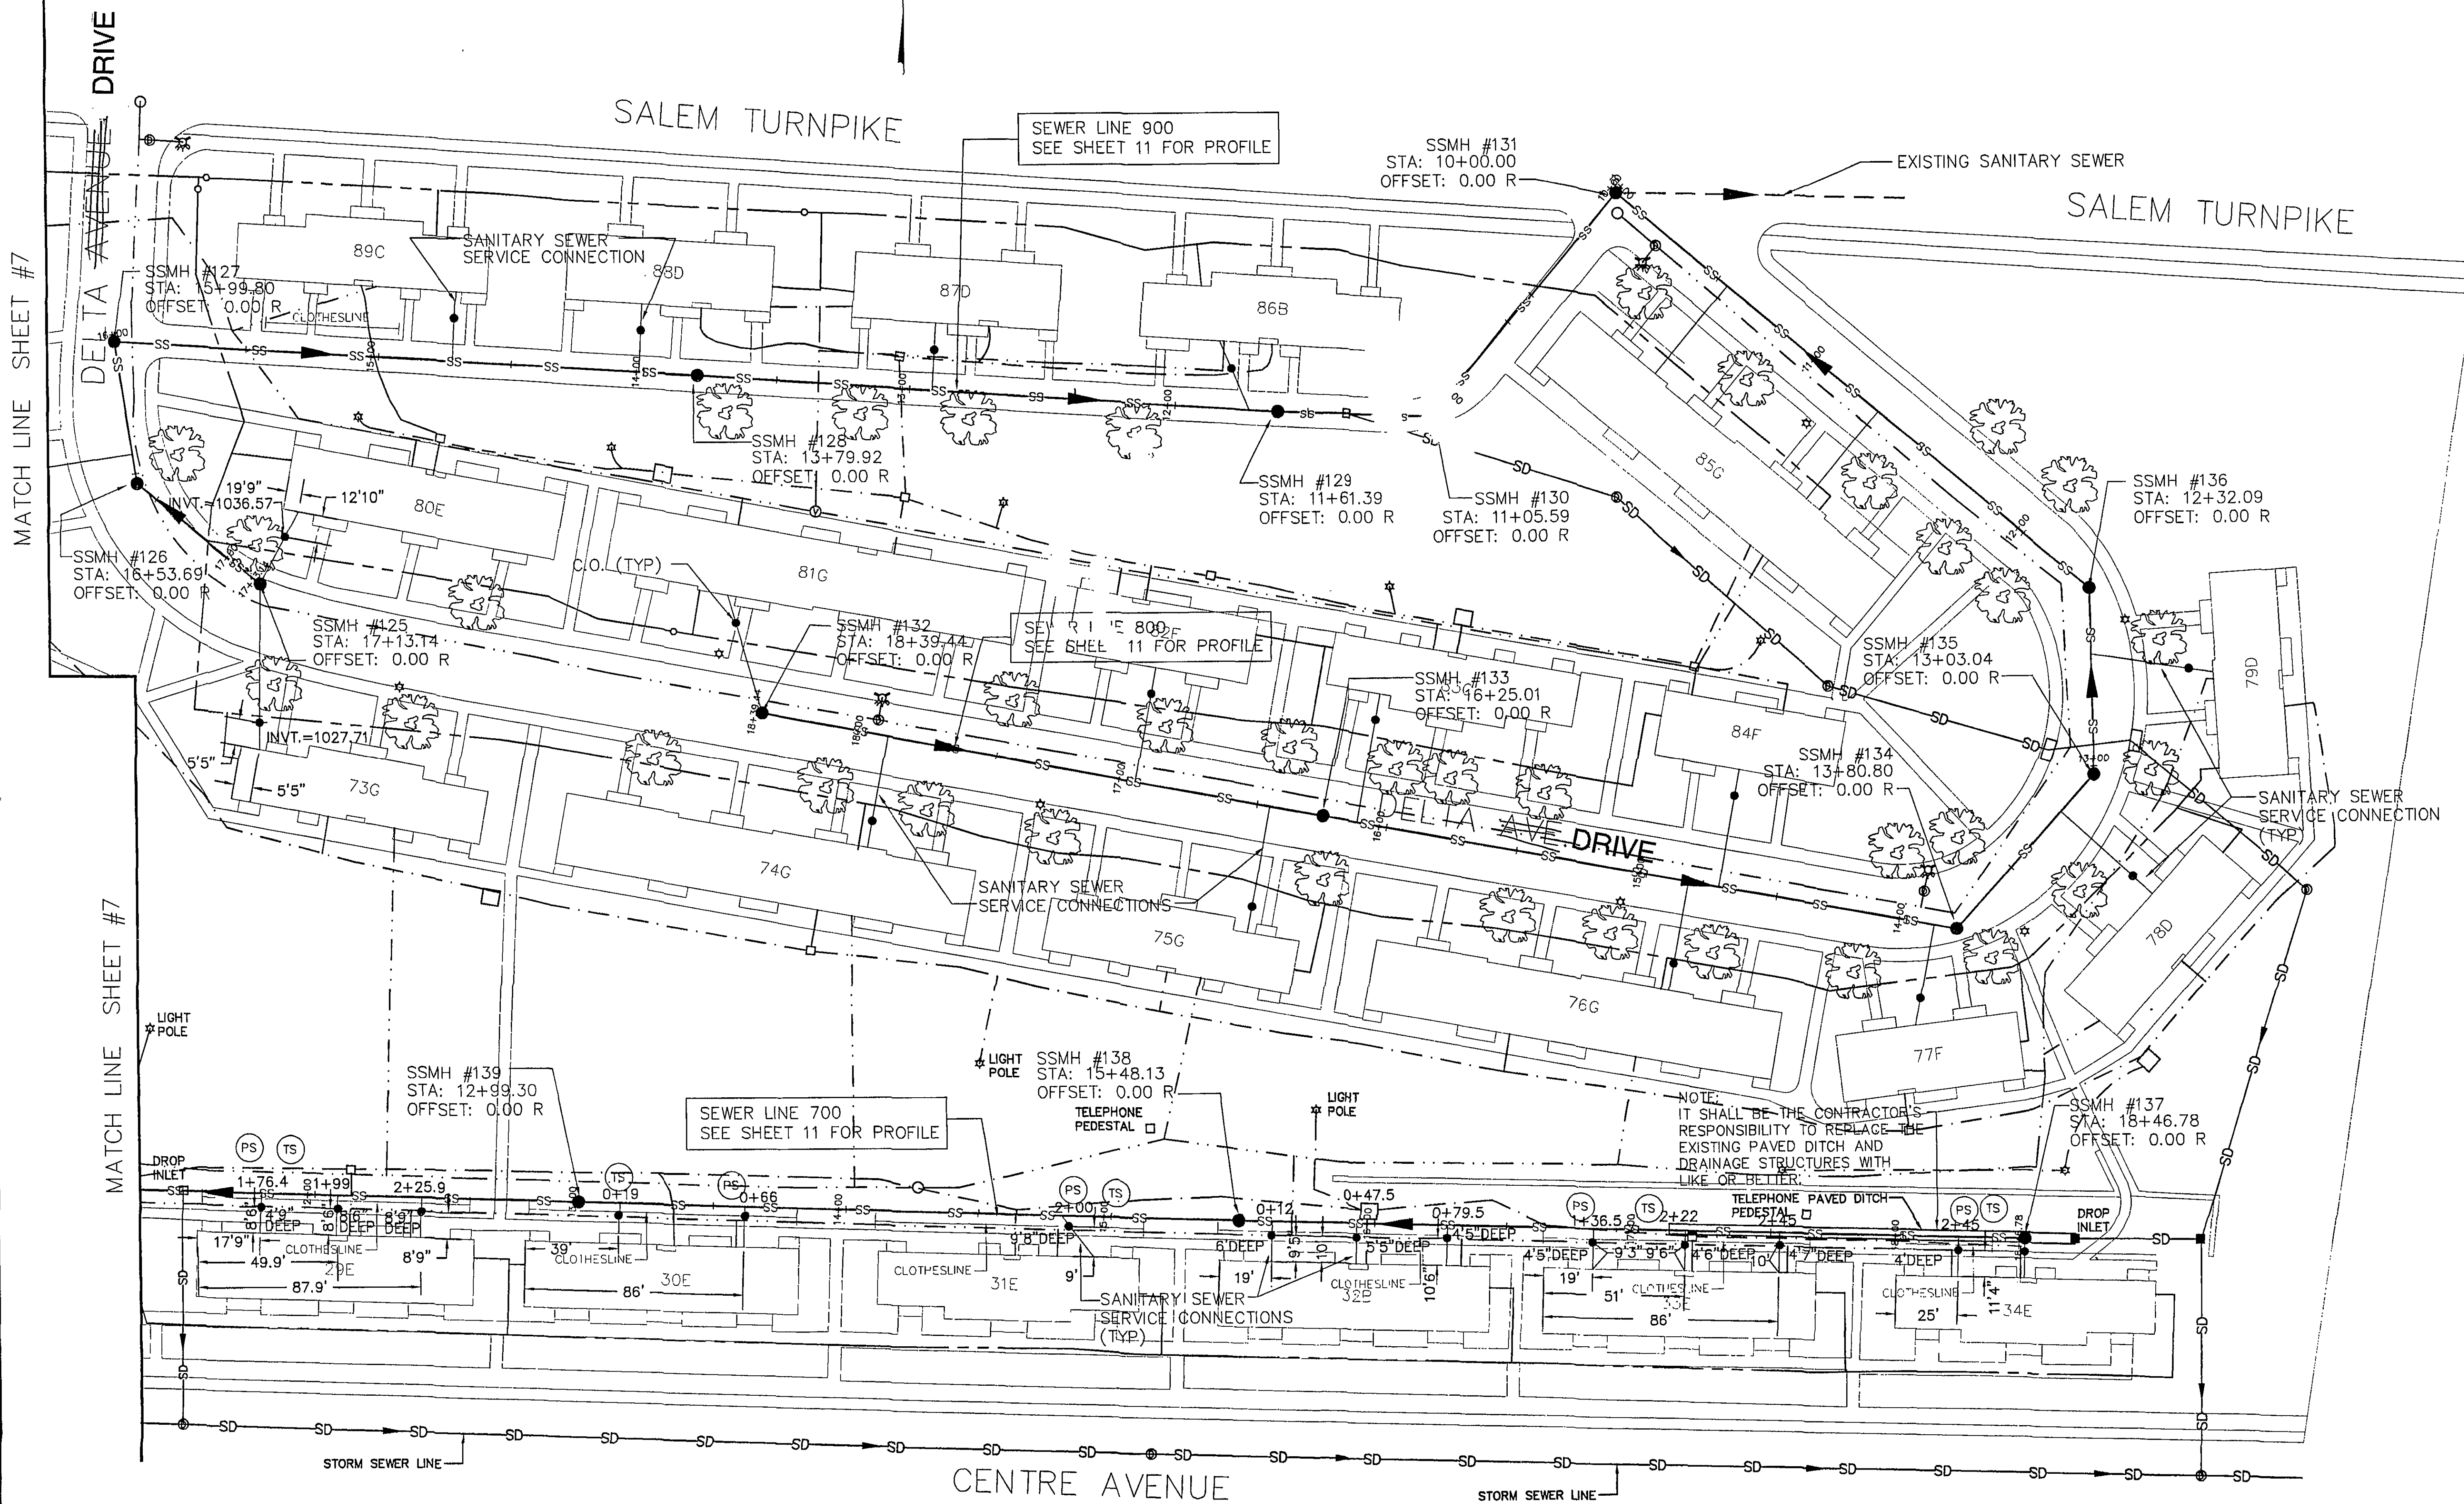

RECORD DRAWING

WVWA ID# 6Q8LD3

SANITARY SEWER PLAN			
NO.	DATE	RECORD DRAWING DESCRIPTION	DRM BY
1	11/25/98		

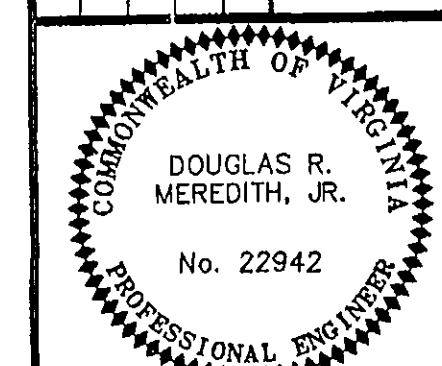

Designed By	DME/MUG
Drawn By	DME
Checked By	RCW
Approved By	RCW
Submitted By	DRM
Drawing	1136PL-3.DWG
Date	5/2/97
Scale	H: 1" = 30'
Commission No.	1136
Sheet	8 of 13

CITY OF ROANOKE
REDEVELOPMENT & HOUSING AUTHORITY
LANSDOWNE PARK
SANITARY SEWER REPLACEMENT
CITY OF ROANOKE, VIRGINIA

LMW P.C.
ENGINEERING - ARCHITECTURE - SURVEYING
102 ALBEMARLE AVE.
ROANOKE, VIRGINIA 24060
(540) 345-0875
FAX (540) 342-4456