
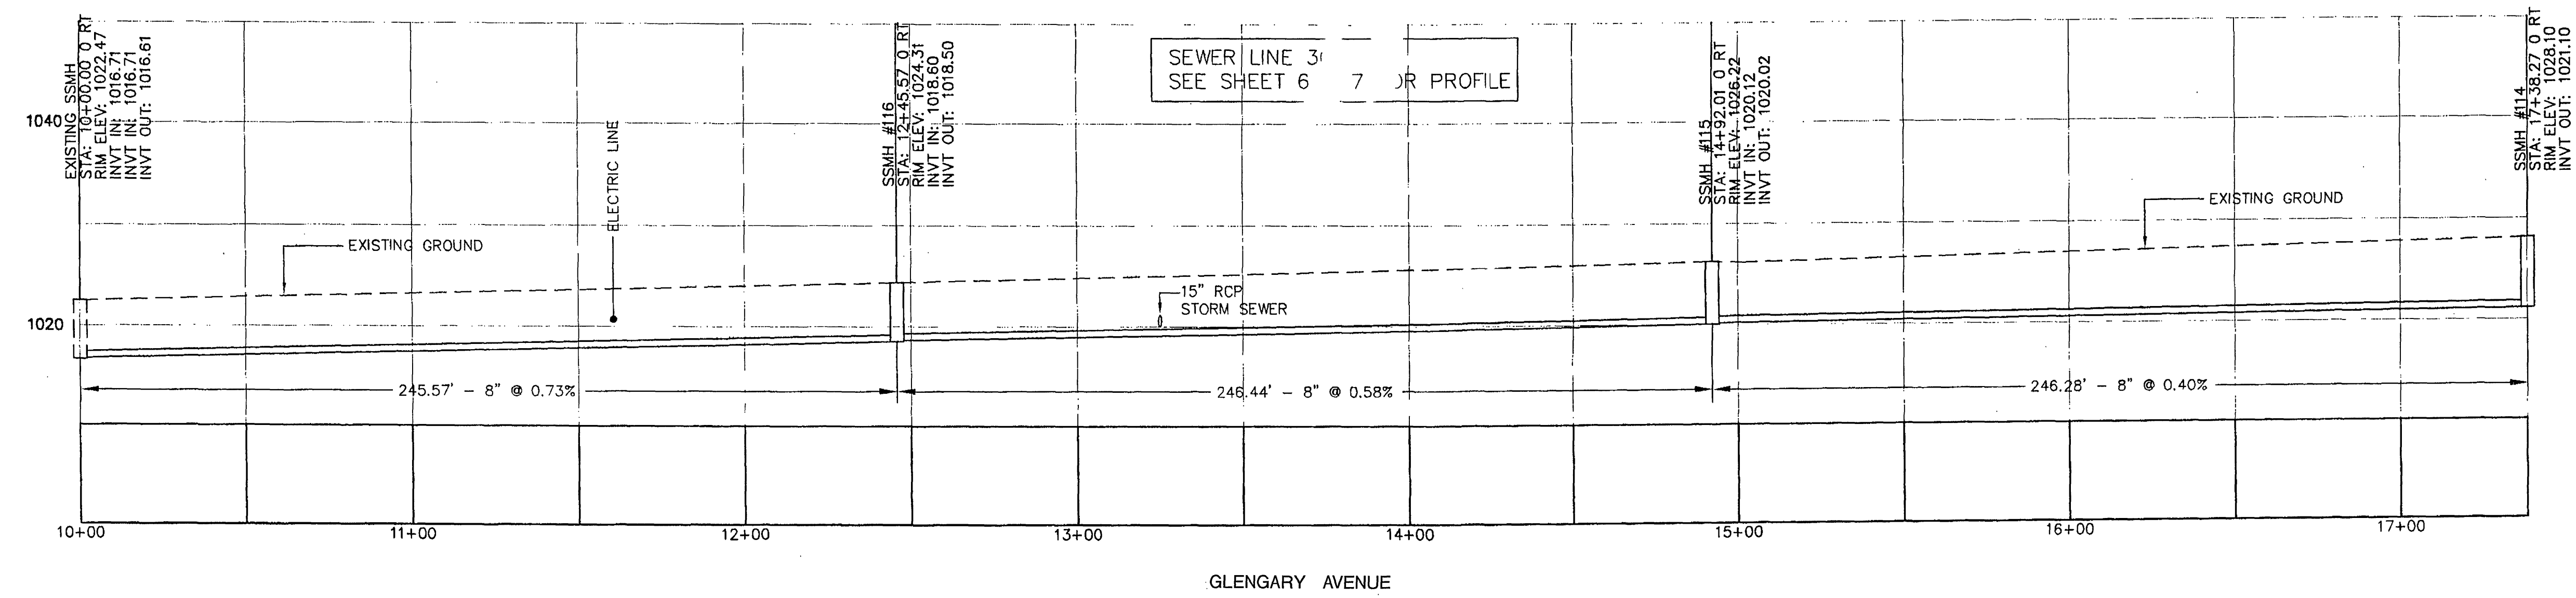


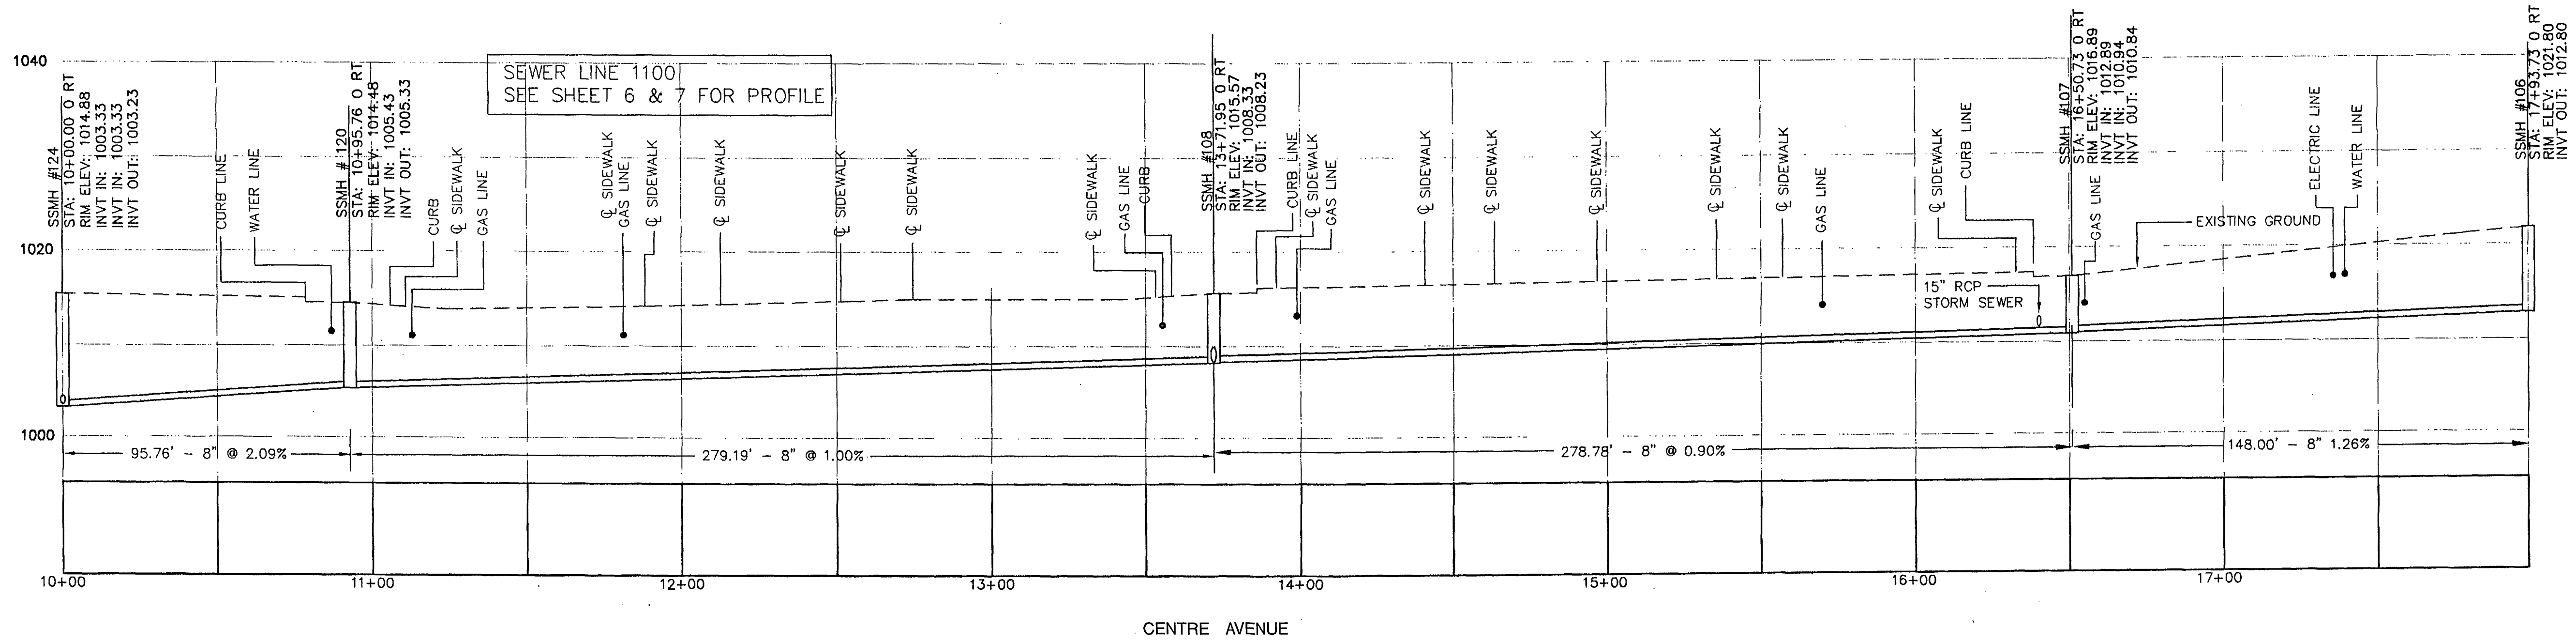


RECORD DRAWING

WVWA ID# 6Q8LD3

LMW P.C.
ENGINEERING-SURVEYING-ARCHITECTURE
102 ALBEMARLE AVENUE
ROANOKE, VIRGINIA 24013
TEL (540) 345-0675
FAX (540) 342-4456

CITY OF ROANOKE
REDEVELOPMENT & HOUSING AUTHORITY
LANSLOWNE PARK
SANITARY SEWER REPLACEMENT
CITY OF ROANOKE, VIRGINIA

NO.	DATE	DESCRIPTION	BY
1	11/25/98	RECORD DRAWING	DRM

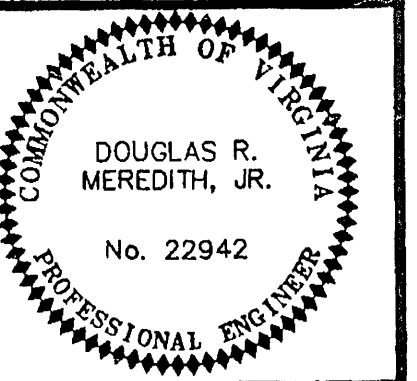

Designed By	DME/MJG
Drawn By	DME
Checked By	RCW
Approved By	DRM
Submitted By	DRM
Drawing	1136PR01.DWG
Date:	5/2/97
Scale	V: 1" = 10' H: 1" = 30'
Commission No.	1136
Sheet	9 of 13