
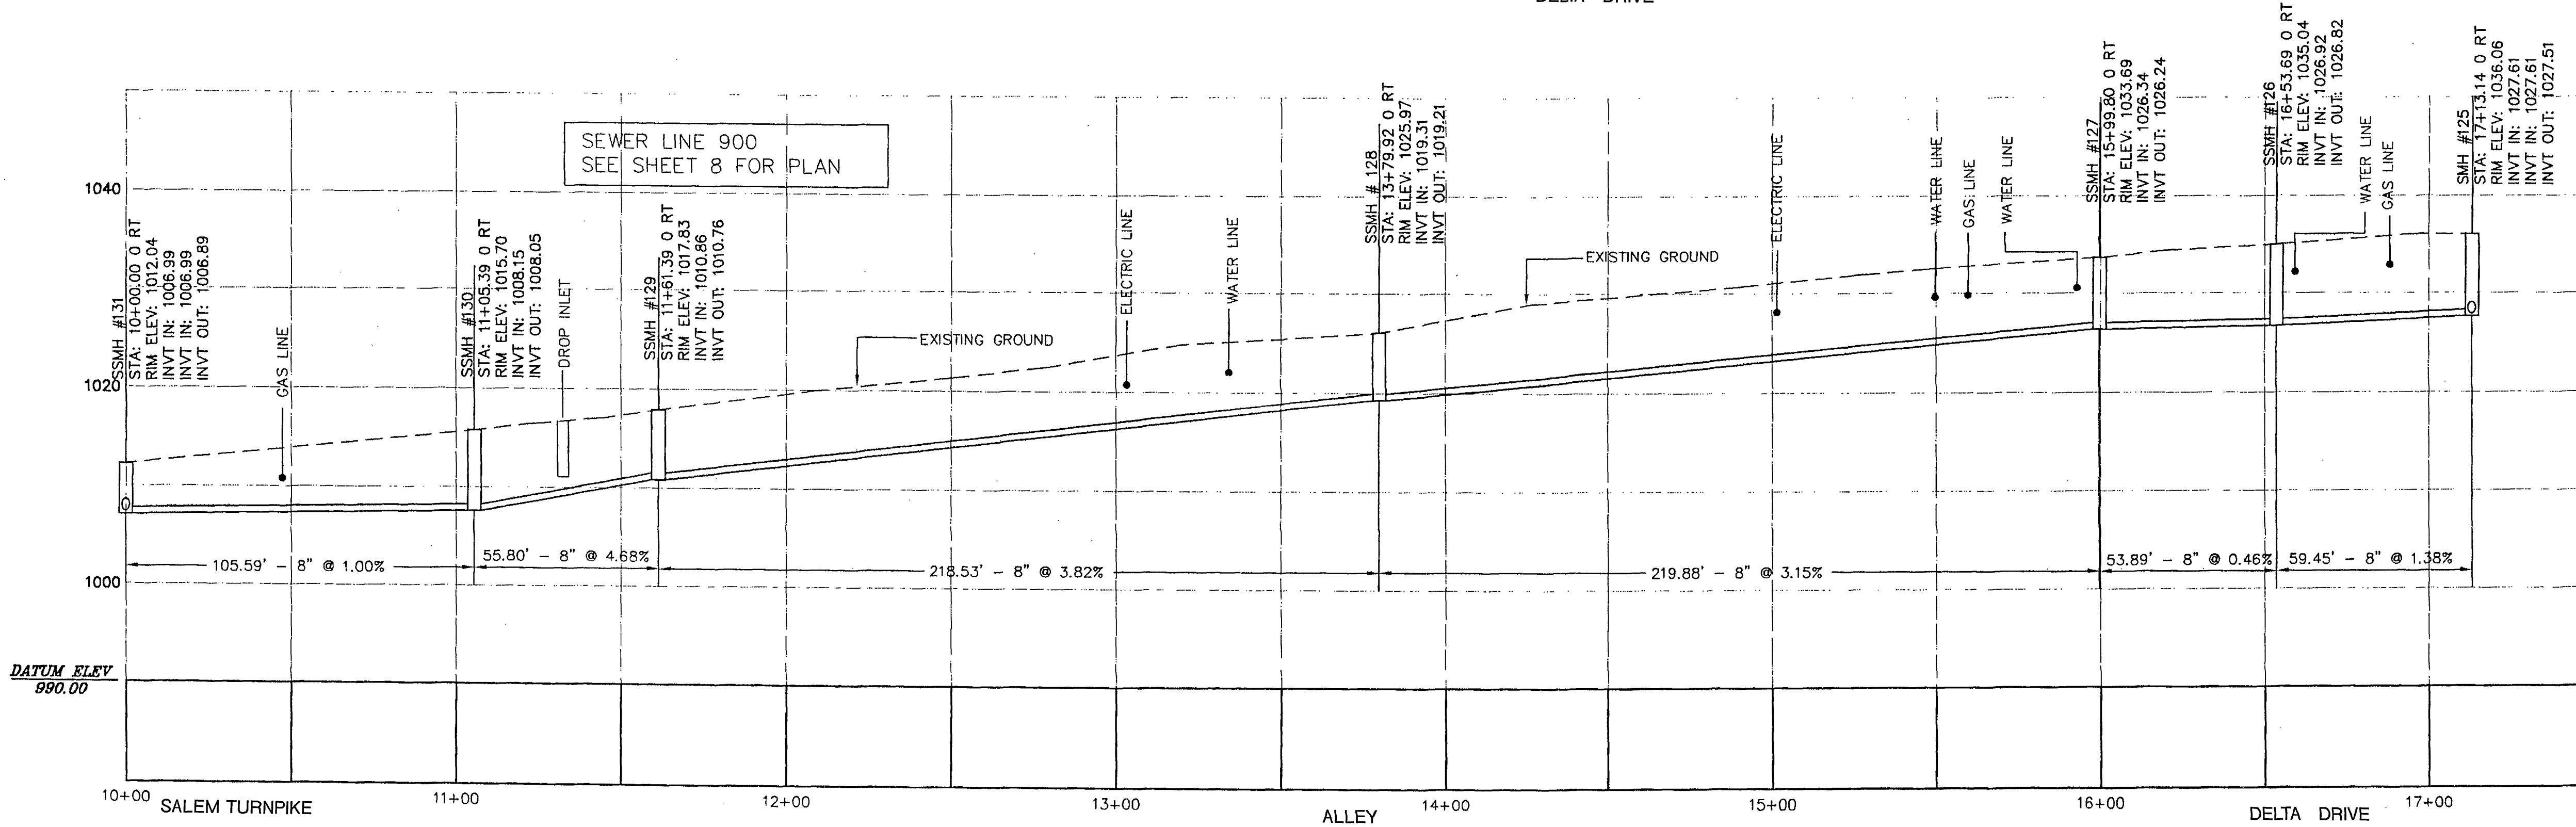
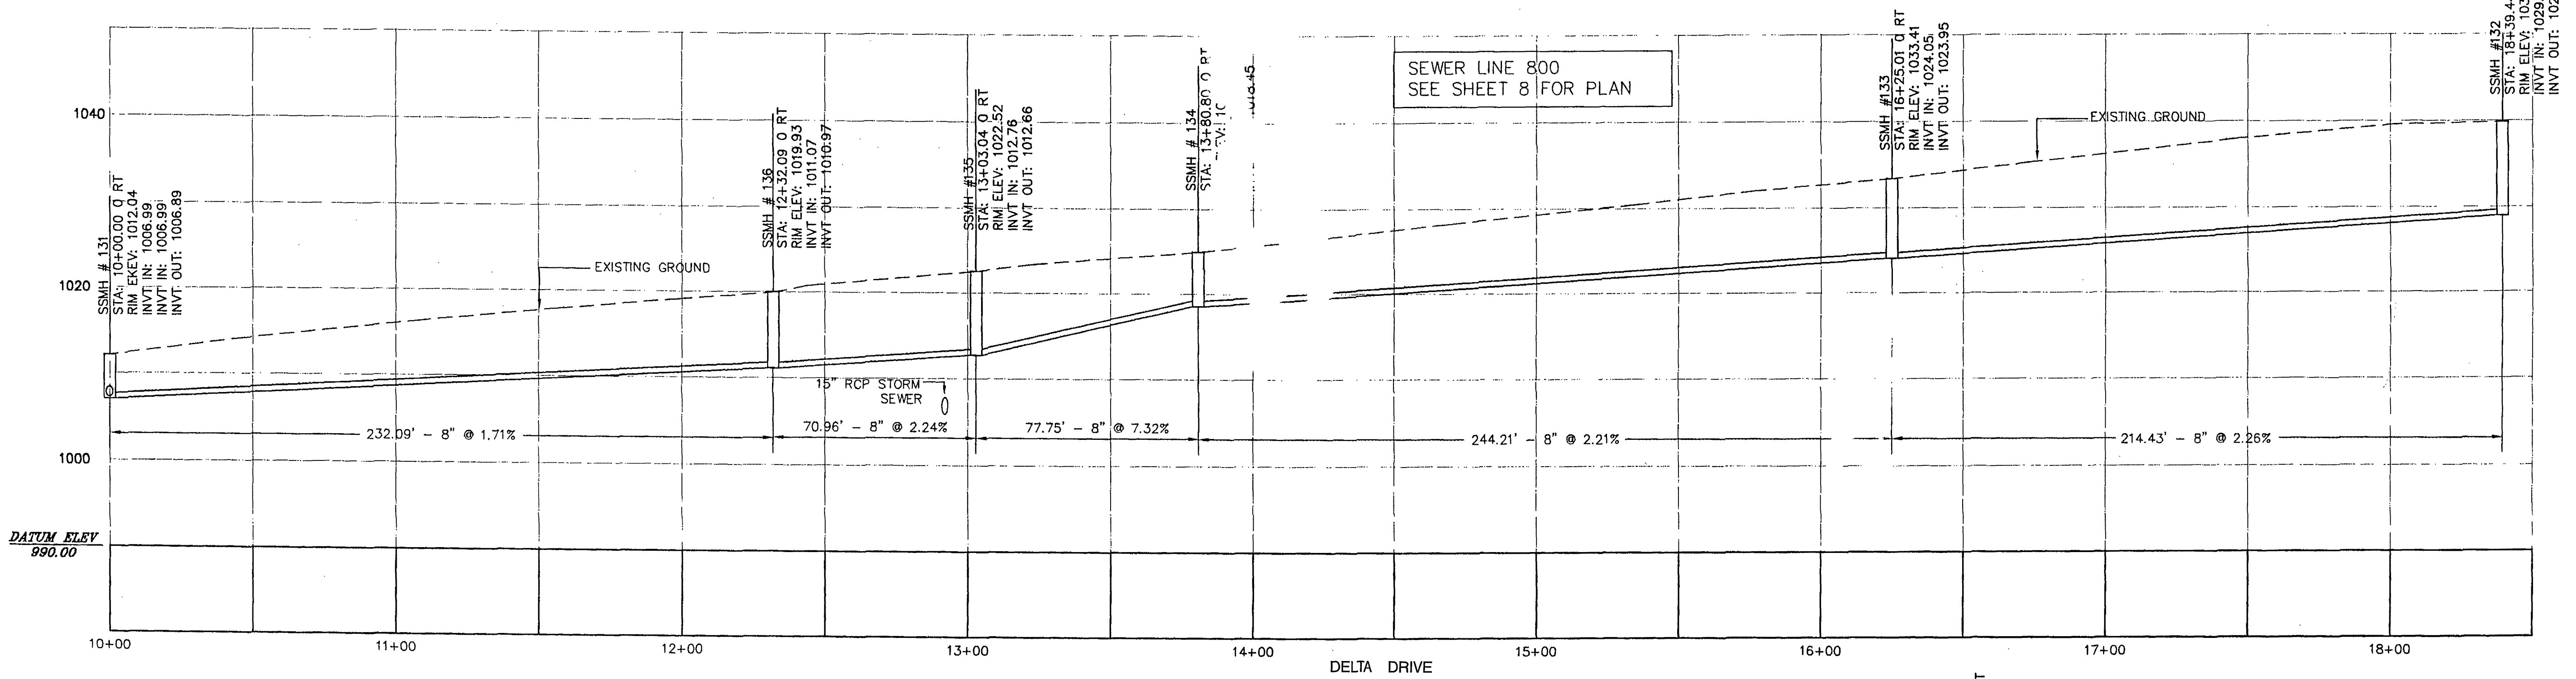


C:\DWG\1136\1136PRO2.DWG DATE: 5/2/97

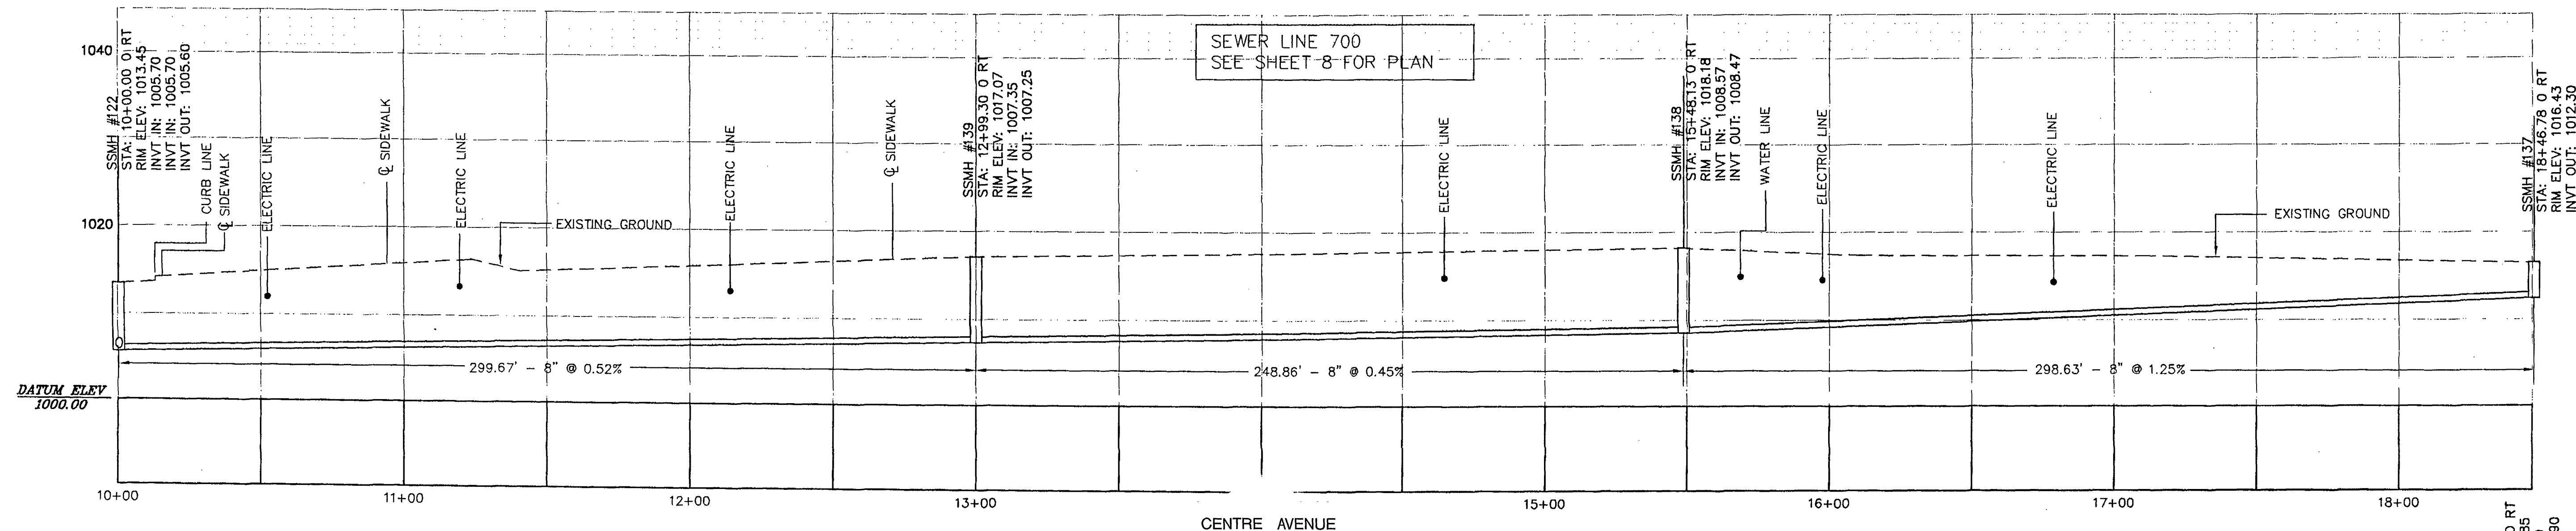


RECORD DRAWING

LMW P.C.
ENGINEERING SURVEYING ARCHITECTURE
102 ALBEMARLE AVENUE
ROANOKE, VIRGINIA 24060
(540) 345-0675
FAX (540) 342-4456

CITY OF ROANOKE
REDEVELOPMENT & HOUSING AUTHORITY
LANDSDOWNE PARK
SANITARY SEWER REPLACEMENT
CITY OF ROANOKE, VIRGINIA

NO.	DATE	RECORD DRAWING	DRM	BY
1	11/25/98			

SANITARY SEWER PROFILES

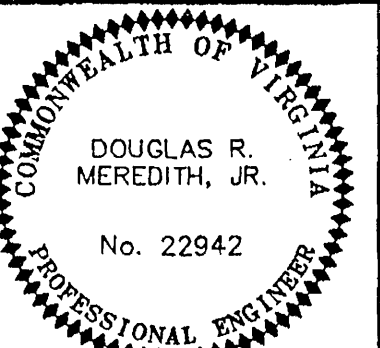

Designed By	DME/MUG
Drawn By	DME
Checked By	RCW
Approved By	DRM
Submitted By	DRM
Drawing	1136PRO2.DWG
Date:	5/2/97
Scale:	V: 1" = 10' H: 1" = 30'
Commission No.	1136
Sheet	11 of 13

WWW.ID# 6Q6LD3