


PIPE BURSTING
LAUREL RIDGE / LEWISTON / HILLENDALE

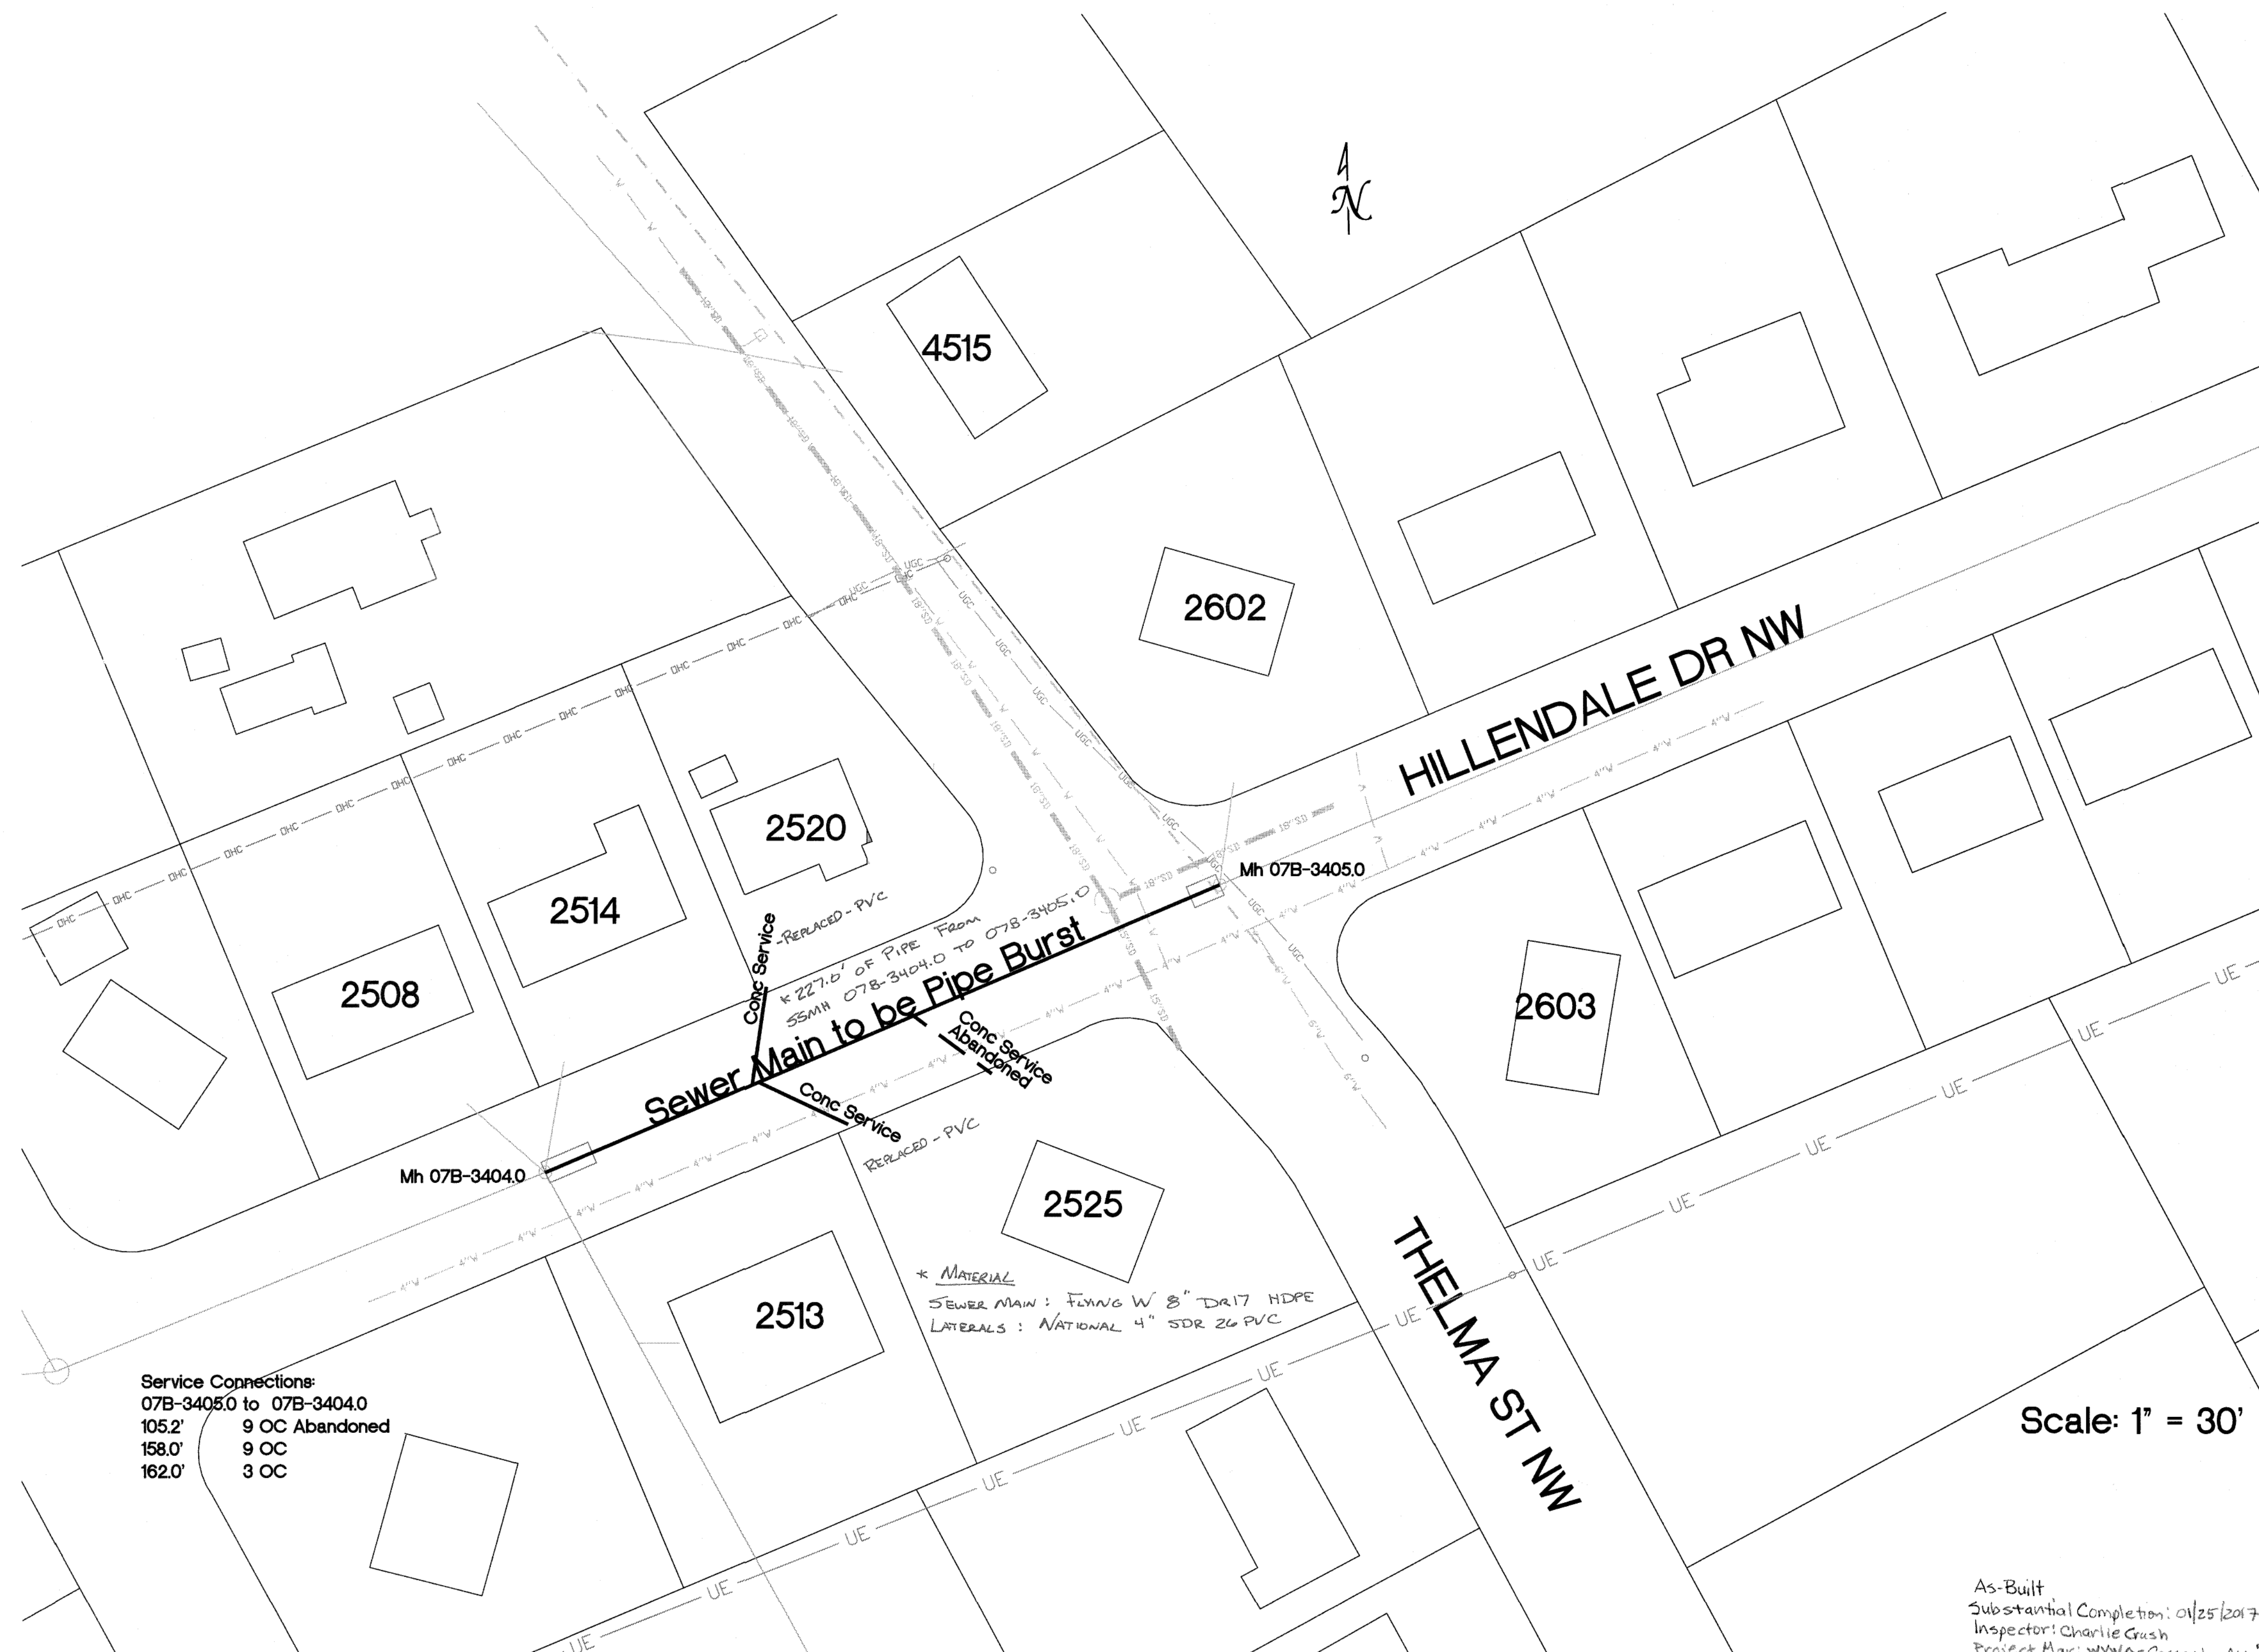

As-Built
Substantial Completion: 01/25/2017
Inspector: Charlie Crush
Project Mgr: WYVA-Cassandra Altice

Sheet 1 of 1