
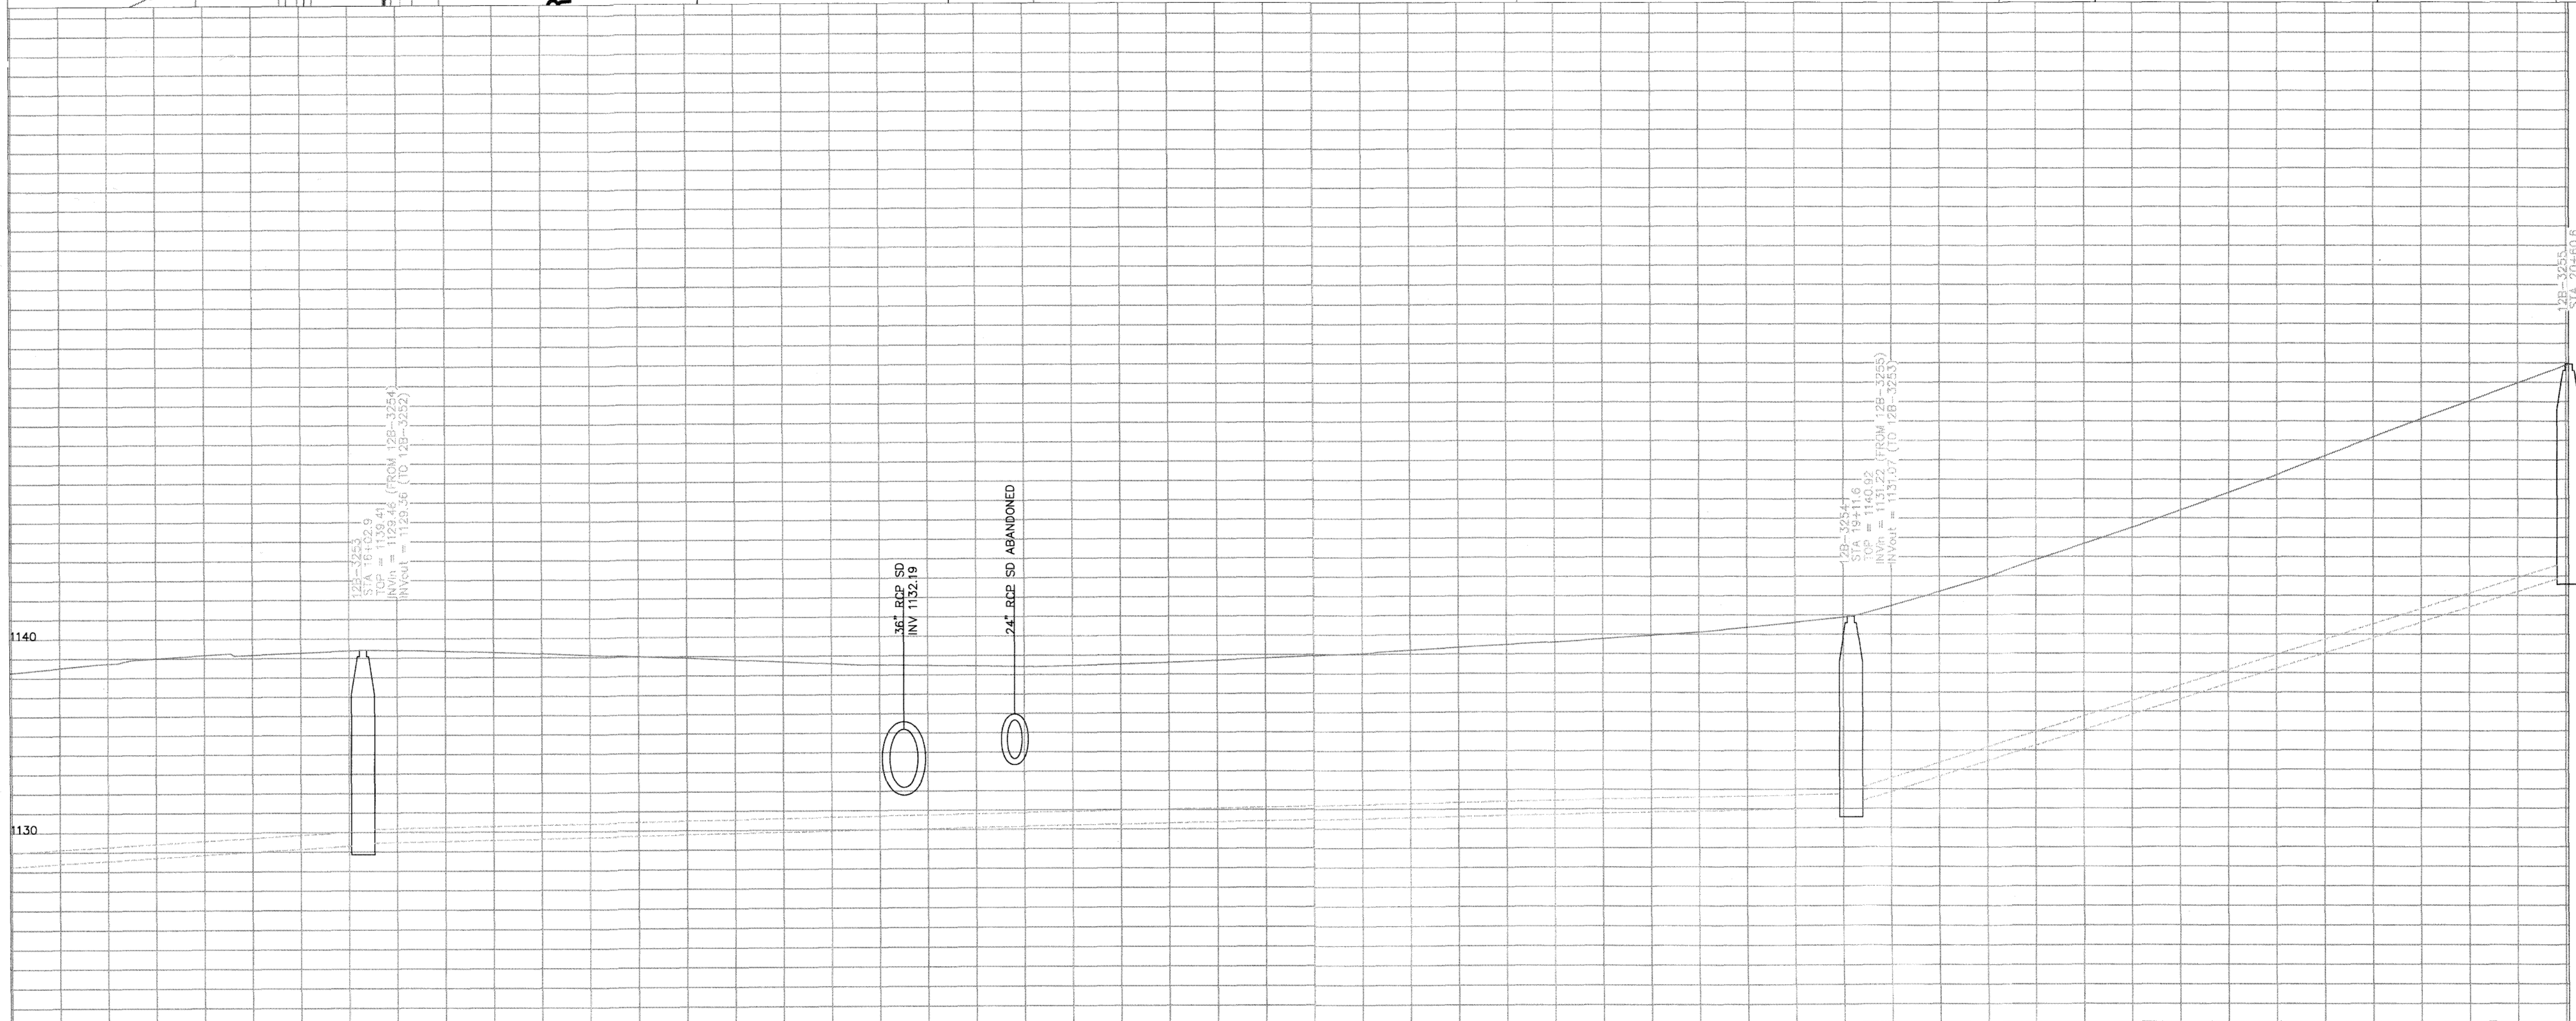


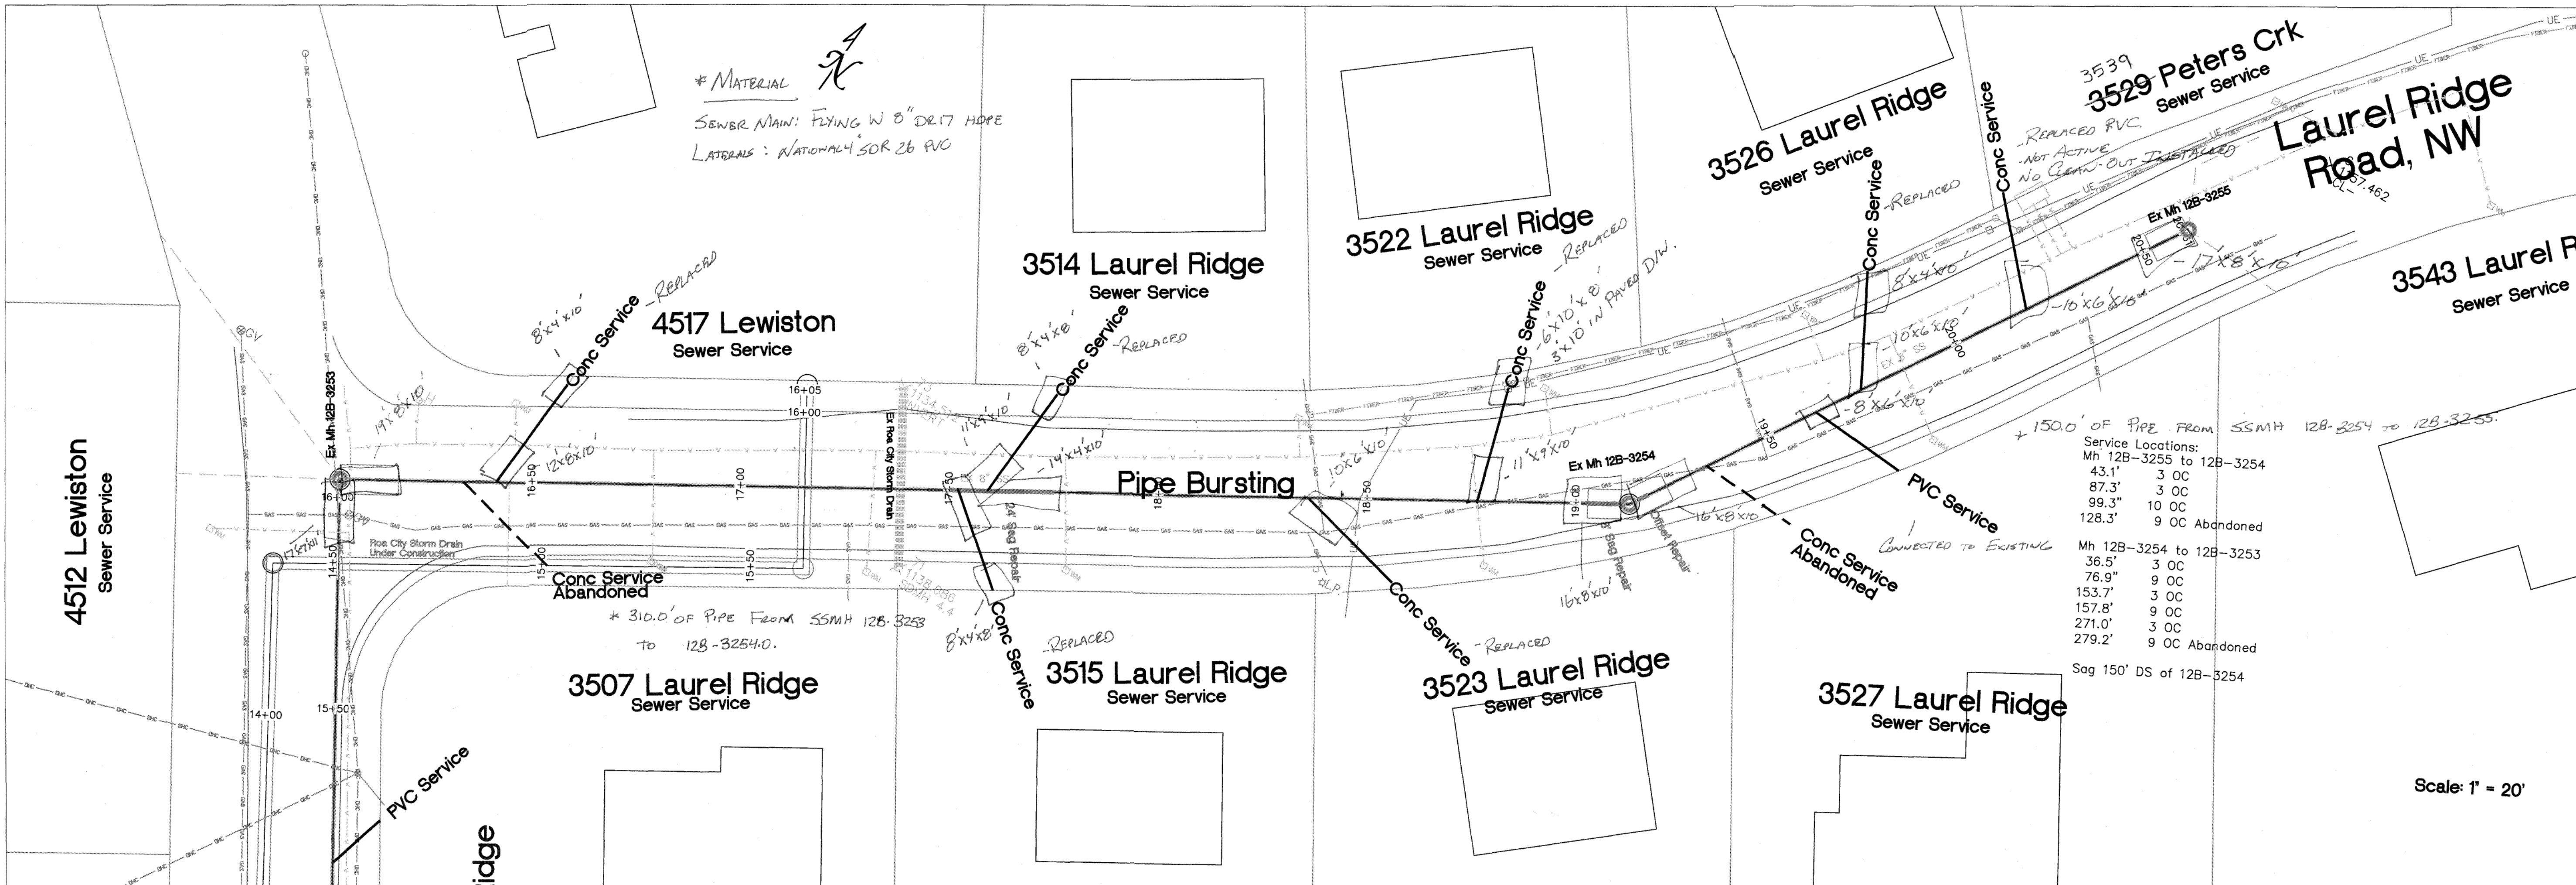

As-Built
Substantial Completion 01/25/2017

WESTERN VIRGINIA
WATER AUTHORITY
ENGINEERING SERVICES
601 S JEFFERSON ST, SUITE 300
ROANOKE, VA 24011
540-853-5641 or 540-853-5770

Laurel Ridge/Lewiston

PLAN & PROFILE

Rev	Description	Date	By

Designed:

Drawn: Cassandra Altice

Checked:

Approved:

Date:

Project:

4
Sheet 4 of 4