


PROJECT LOCATION MAP

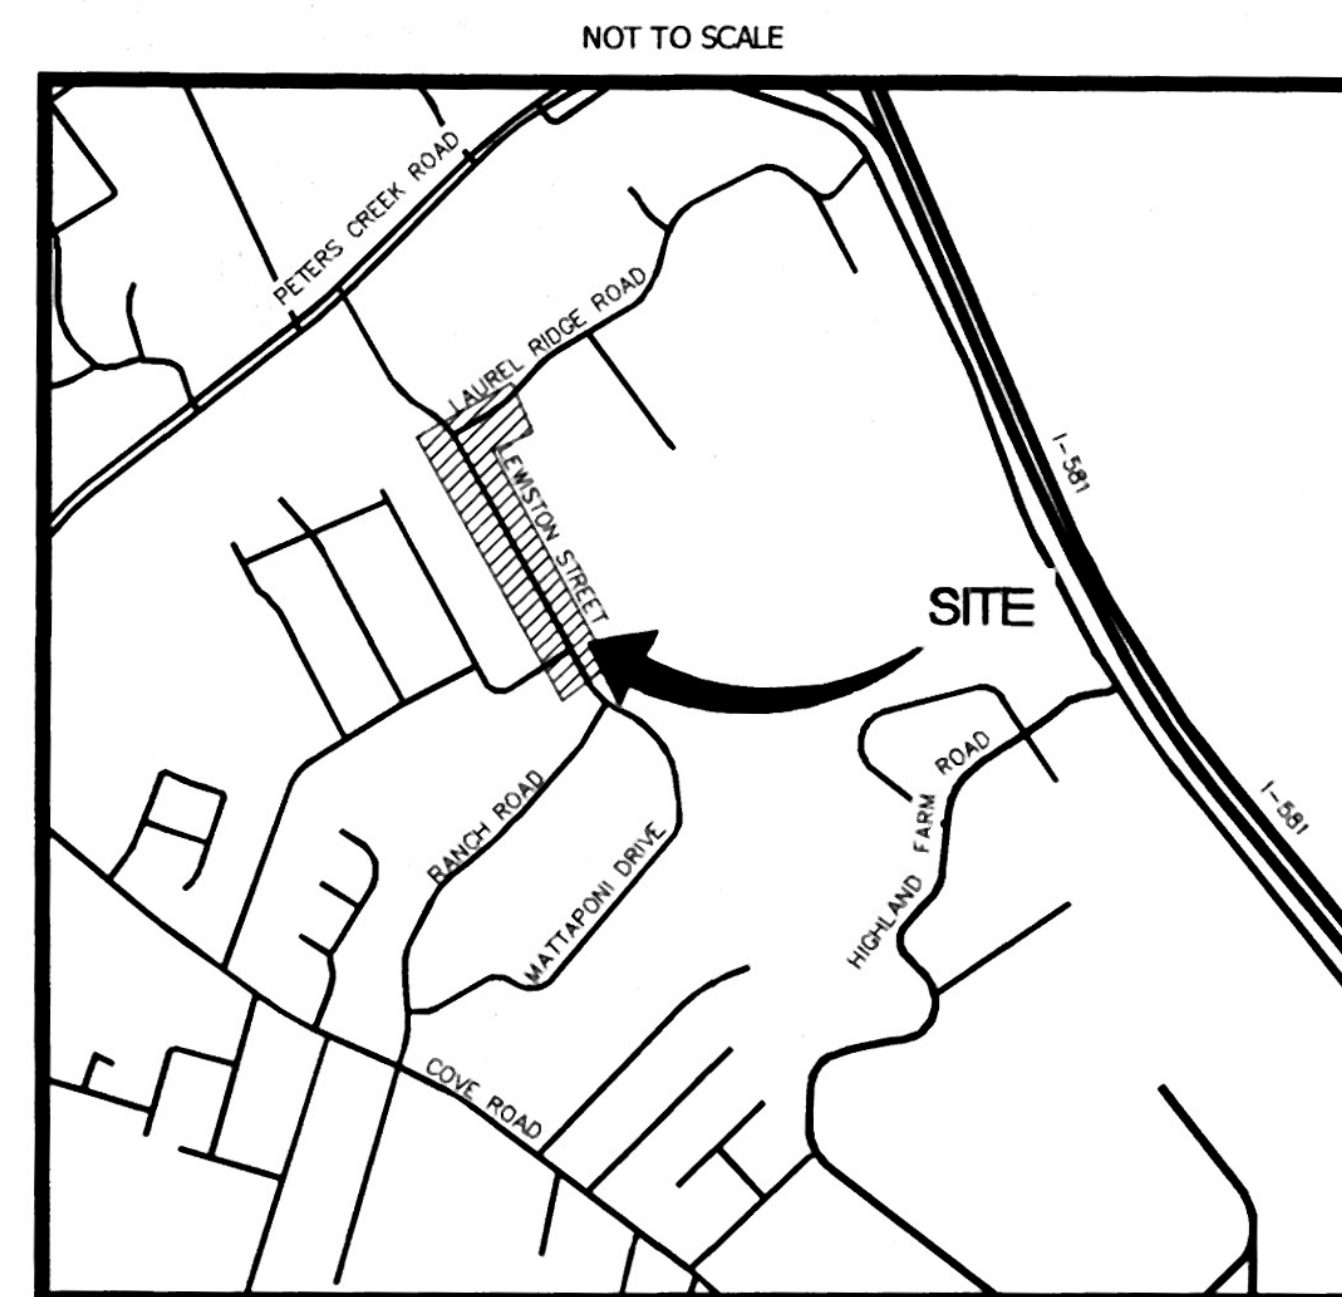

DEPARTMENT OF PUBLIC WORKS  
STORMWATER DIVISION  
1802 COURTLAND ROAD, NE  
ROANOKE, VIRGINIA 24012  
PHONE: (540) 853-5900  
FAX: (540) 853-1270

INDEX OF SHEETS

C001	COVER SHEET
C002	GENERAL NOTES & LEGEND
C003	EROSION & SEDIMENT CONTROL NOTES AND NARRATIVE
C101	EXISTING CONDITIONS
C102	EXISTING CONDITIONS
C103	EXISTING CONDITIONS
C104	EXISTING CONDITIONS
C200	KEY SHEET
C201	SITE & GRADING PLAN
C202	SITE & GRADING PLAN
C203	SITE & GRADING PLAN
C204	STORM SEWER PROFILES
C301	UTILITY & SITE DETAILS
C302	UTILITY & SITE DETAILS
C303	UTILITY & SITE DETAILS
C304	EROSION & SEDIMENT CONTROL DETAILS

SITE SUMMARY

TAX MAP NUMBER: #9999998 (RIGHT-OF-WAY)  
LOCATION: LAUREL RIDGE ROAD/LEWISTON STREET  
ROANOKE, VIRGINIA  
PRESENT ZONING: R-7, ROS  
PRESENT USE: RESIDENTIAL/RIGHT-OF-WAY  
DISTURBED AREA: WITHIN PAVED ROADWAY: 0.33 AC  
OUTSIDE PAVED ROADWAY: 0.37 AC

City of Roanoke  
Planning Building and Development

APPROVED

*[Signature]* 6-1-2016  
Development Reviewer Date

APPROVED FOR CONSTRUCTION

*[Signature]*  
STORMWATER MANAGER 11/13/2015  
DATE

*[Signature]*  
DIRECTOR OF PUBLIC WORKS 11/16/15  
DATE

*[Signature]*  
ASSISTANT CITY MANAGER - OPERATIONS 11/16/15  
DATE

ADVERTISED DATE: \_\_\_\_\_

SET NUMBER: \_\_\_\_\_

SHEET NUMBER: 1 OF 16

CONSULTING ENGINEERS

 **Draper Aden Associates**  
Engineering • Surveying • Environmental Services  
Blacksburg, VA  
2206 South Main Street  
Blacksburg, VA 24060  
540-552-0444 Fax: 540-552-0291  
www.daa.com  
Richmond, VA  
Charlottesville, VA  
Hampton Roads, VA  
Coats, NC

DAA PROJECT NO: B141208-01  
SUBMITTAL DATE: AUGUST 21, 2015

COMMISSION NUMBER: \_\_\_\_\_



PROJECT NAME

LAUREL RIDGE RD / LEWISTON ST  
DRAINAGE IMPROVEMENTS

CITY STORMWATER PLAN NUMBER: 5906

CITY PLANNING NUMBER: CP150030

REVISION BY	DESCRIPTION:	DATE
REVISION BY	DESCRIPTION:	DATE
REVISION BY	DESCRIPTION:	DATE
REVISION BY	DESCRIPTION:	DATE

LAUREL RIDGE RD / LEWISTON ST DRAINAGE IMPROVEMENTS

CHARLES CASH  
AS-BUILT  
11-15-16