

SANITARY SEWER SCHEDULE:

SANITARY SEWER MH A
STRADDLE
TOP = 266.24
INV. IN = 259.46
INV. OUT = 259.36

SANITARY SEWER MH B
OUTSIDE DROP
TOP = 282.91
ELEV. @ DROP = 276.43
INV. IN = 272.12
INV. IN = 272.12
INV. OUT = 272.02

SANITARY SEWER MH C
TOP = 290.00
INV. IN = 285.10
INV. OUT = 285.00

SANITARY SEWER AS-BUILT SCHEDULE:

SANITARY SEWER MH A
STRADDLE
TOP = 266.32
INV. IN = 259.68
INV. OUT = 259.26

SANITARY SEWER MH B
OUTSIDE DROP
TOP = 283.11
ELEV. @ DROP = 276.43
INV. IN = 272.11
INV. IN = 272.16
INV. OUT = 272.06




SANITARY SEWER MH C
TOP = 289.89
INV. IN = 284.78
INV. OUT = 284.69

EX. S.S. MH
TOP = 268.87
INV. IN = 262.96
INV. OUT = 262.38
SHELF = 263.27

EX. S.S. MH
TOP = 252.42
INV. IN = 247.4
INV. OUT = 247.37
SHELF = 247.87

- ASPHALT
PAVING
(SEE DETAIL)
- HEAVY DUTY/
PARKING LOT
ASPHALT
PAVING
- ROUTE 11
PAVING
- CONCRETE
SIDEWALK

GRAPHIC SCALE

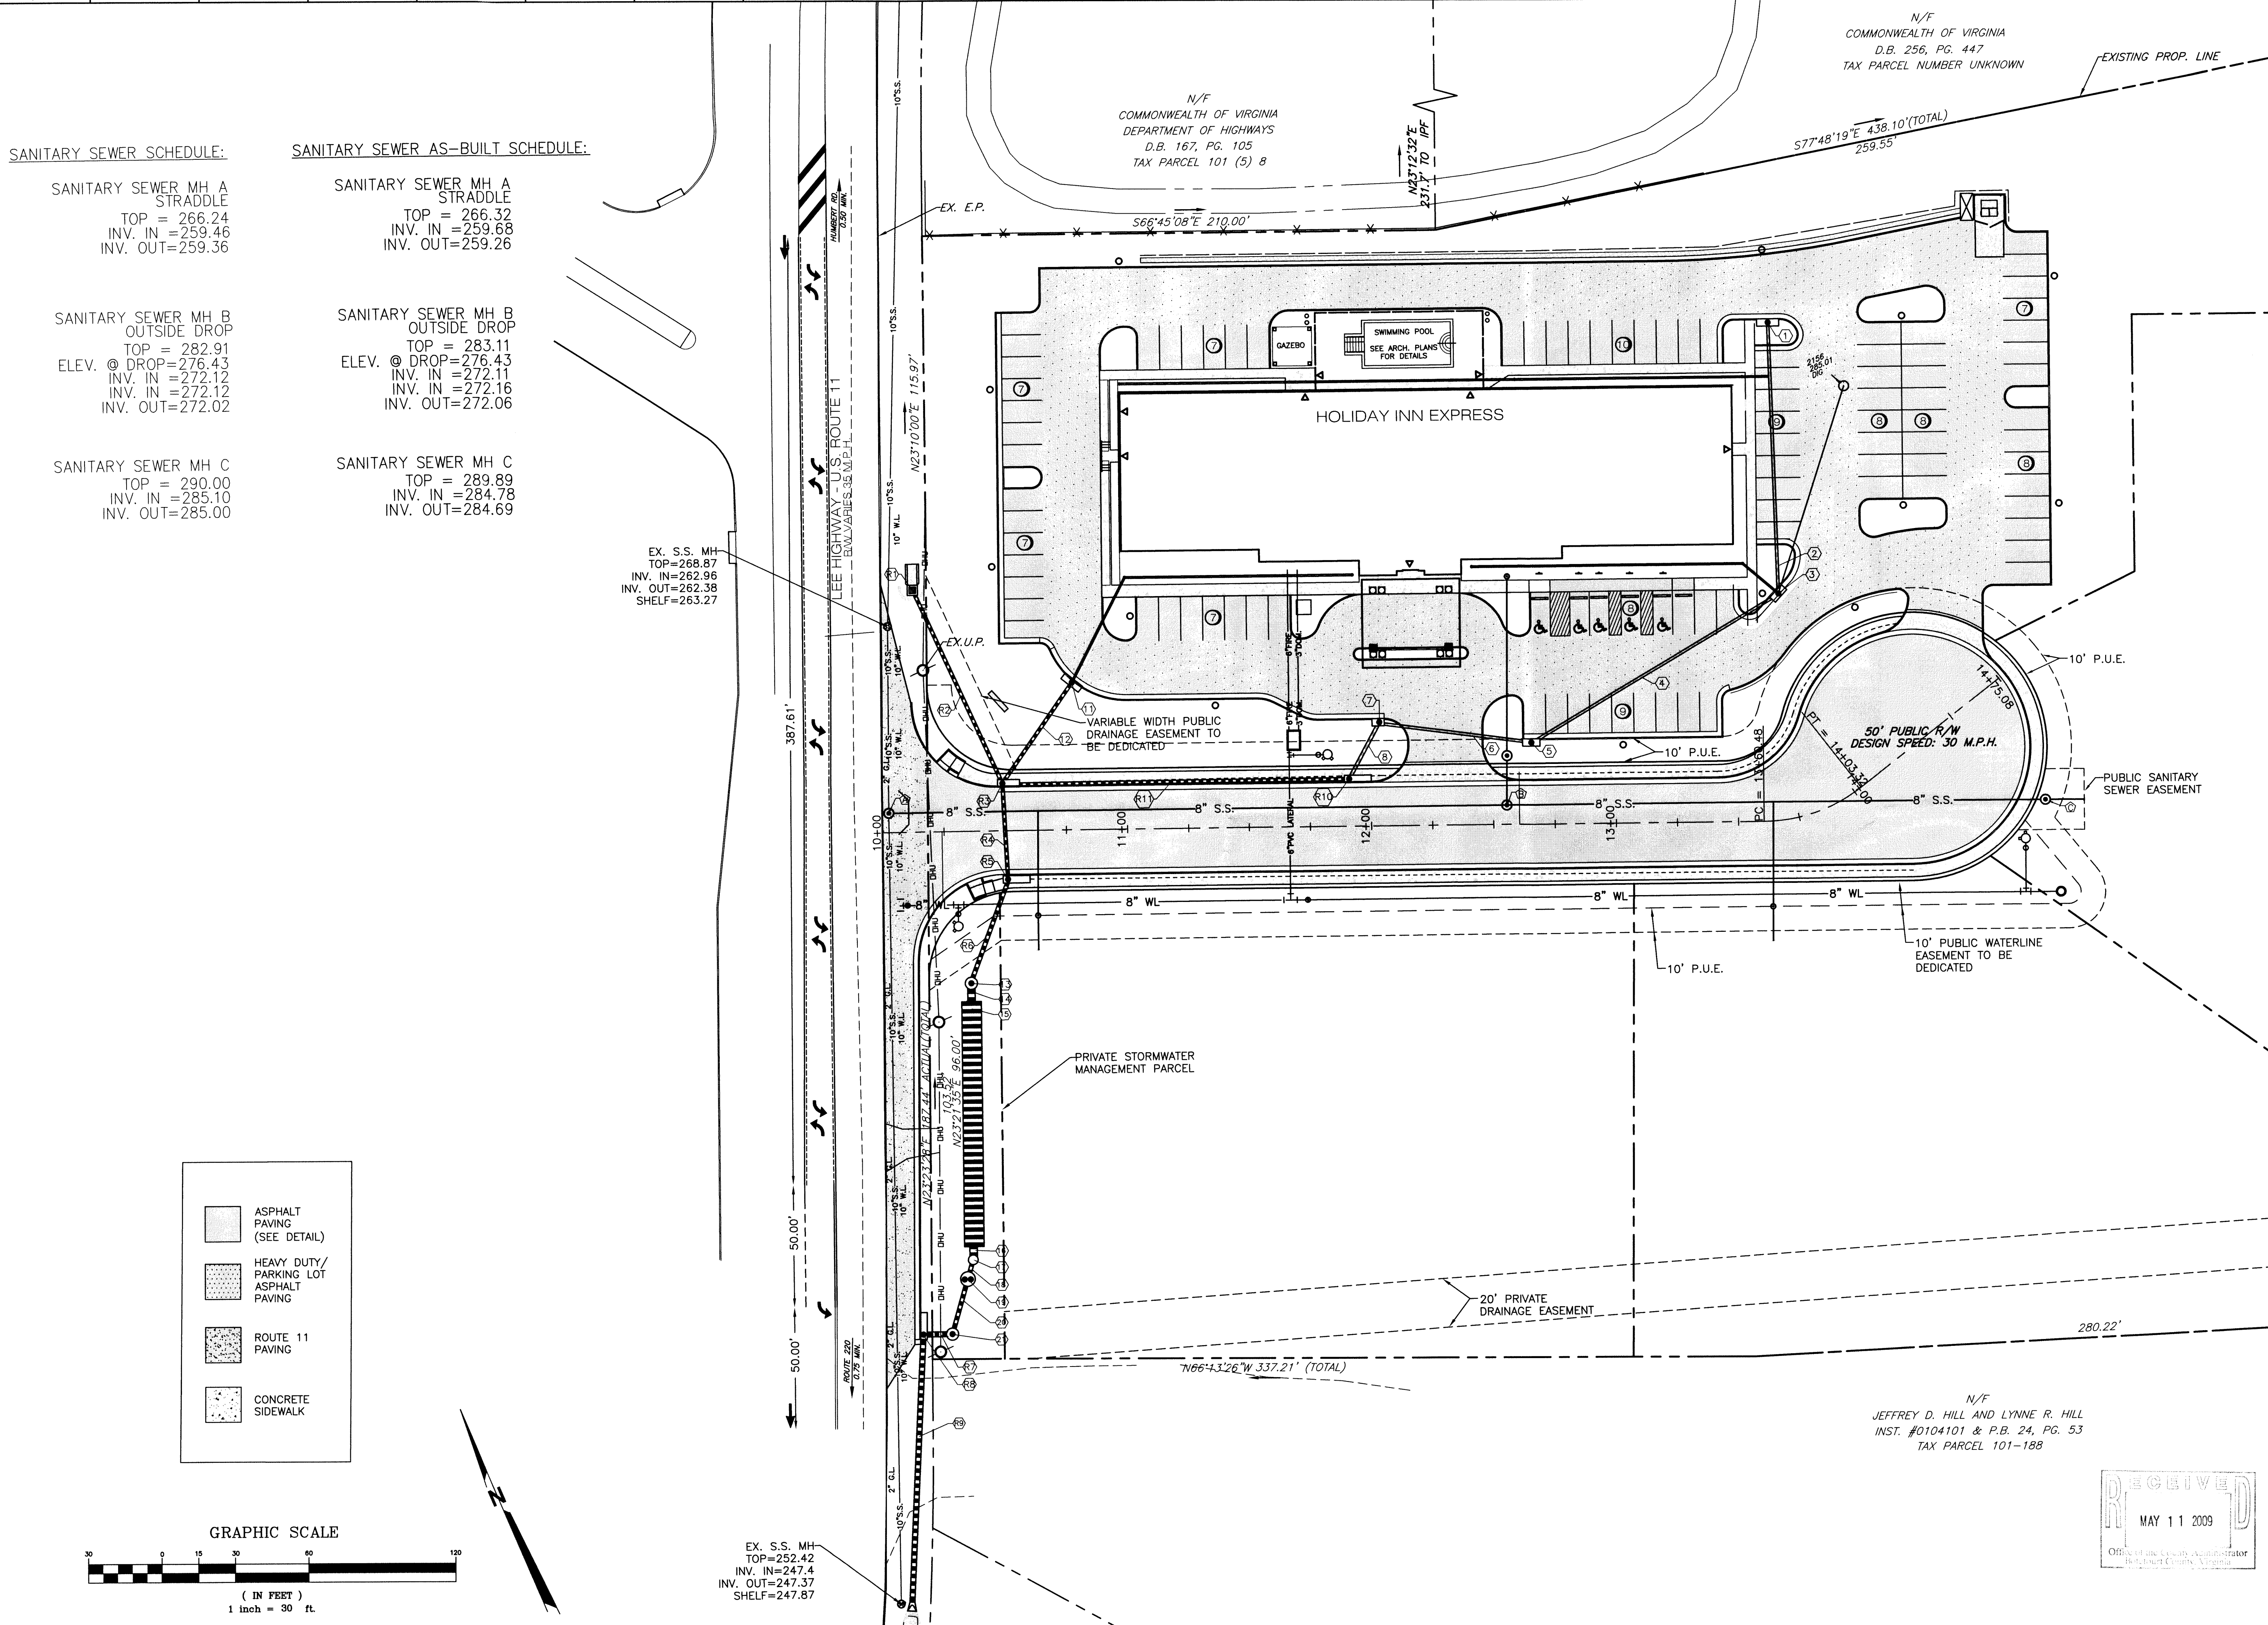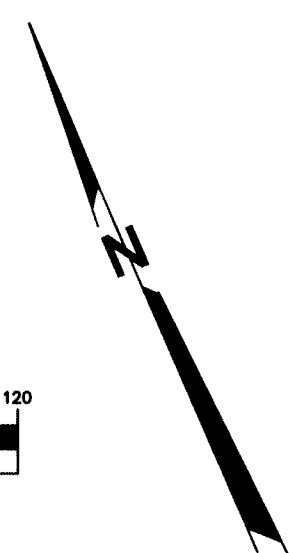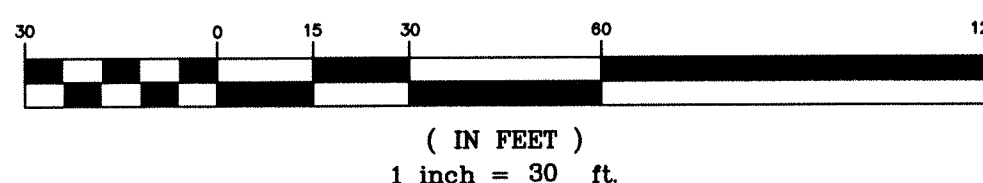

REFLECTING TOMORROW
www.balzer.cc
PLANNERS • ARCHITECTS
ENGINEERS • SURVEYORS

1208 Corporate Circle
Roanoke, Virginia 24018
Phone: 540/772-9580
FAX: 540/772-8050

15871 City View Drive
Suite 200
Madison, Virginia 23113
Phone: 804/794-0571
FAX: 804/794-2635

880 Technology Park Drive
Suite 200
Glen Allen, Virginia 23059
Phone: 804/553-0132
FAX: 804/553-0133

448 Peppers Ferry Road NW
Christiansburg, Virginia 24073
Phone: 540/381-4280
FAX: 540/381-4291

1561 Commerce Road
Suite 401
Verona, Virginia 24462
Phone: 540/248-3220
FAX: 540/248-3221

LEE HIGHWAY COMMERCIAL PARK
SANITARY SEWER AS-BUILT
COUNTY OF BOTETOURT, VIRGINIA

DRAWN BY: BTC
DESIGNED BY: BTC
CHECKED BY: SMH
DATE: 5-11-09

REVISIONS:

SCALE: 1"=30'

SHEET NO.

EX 'A'

JOB NO.
R0600328.00

