
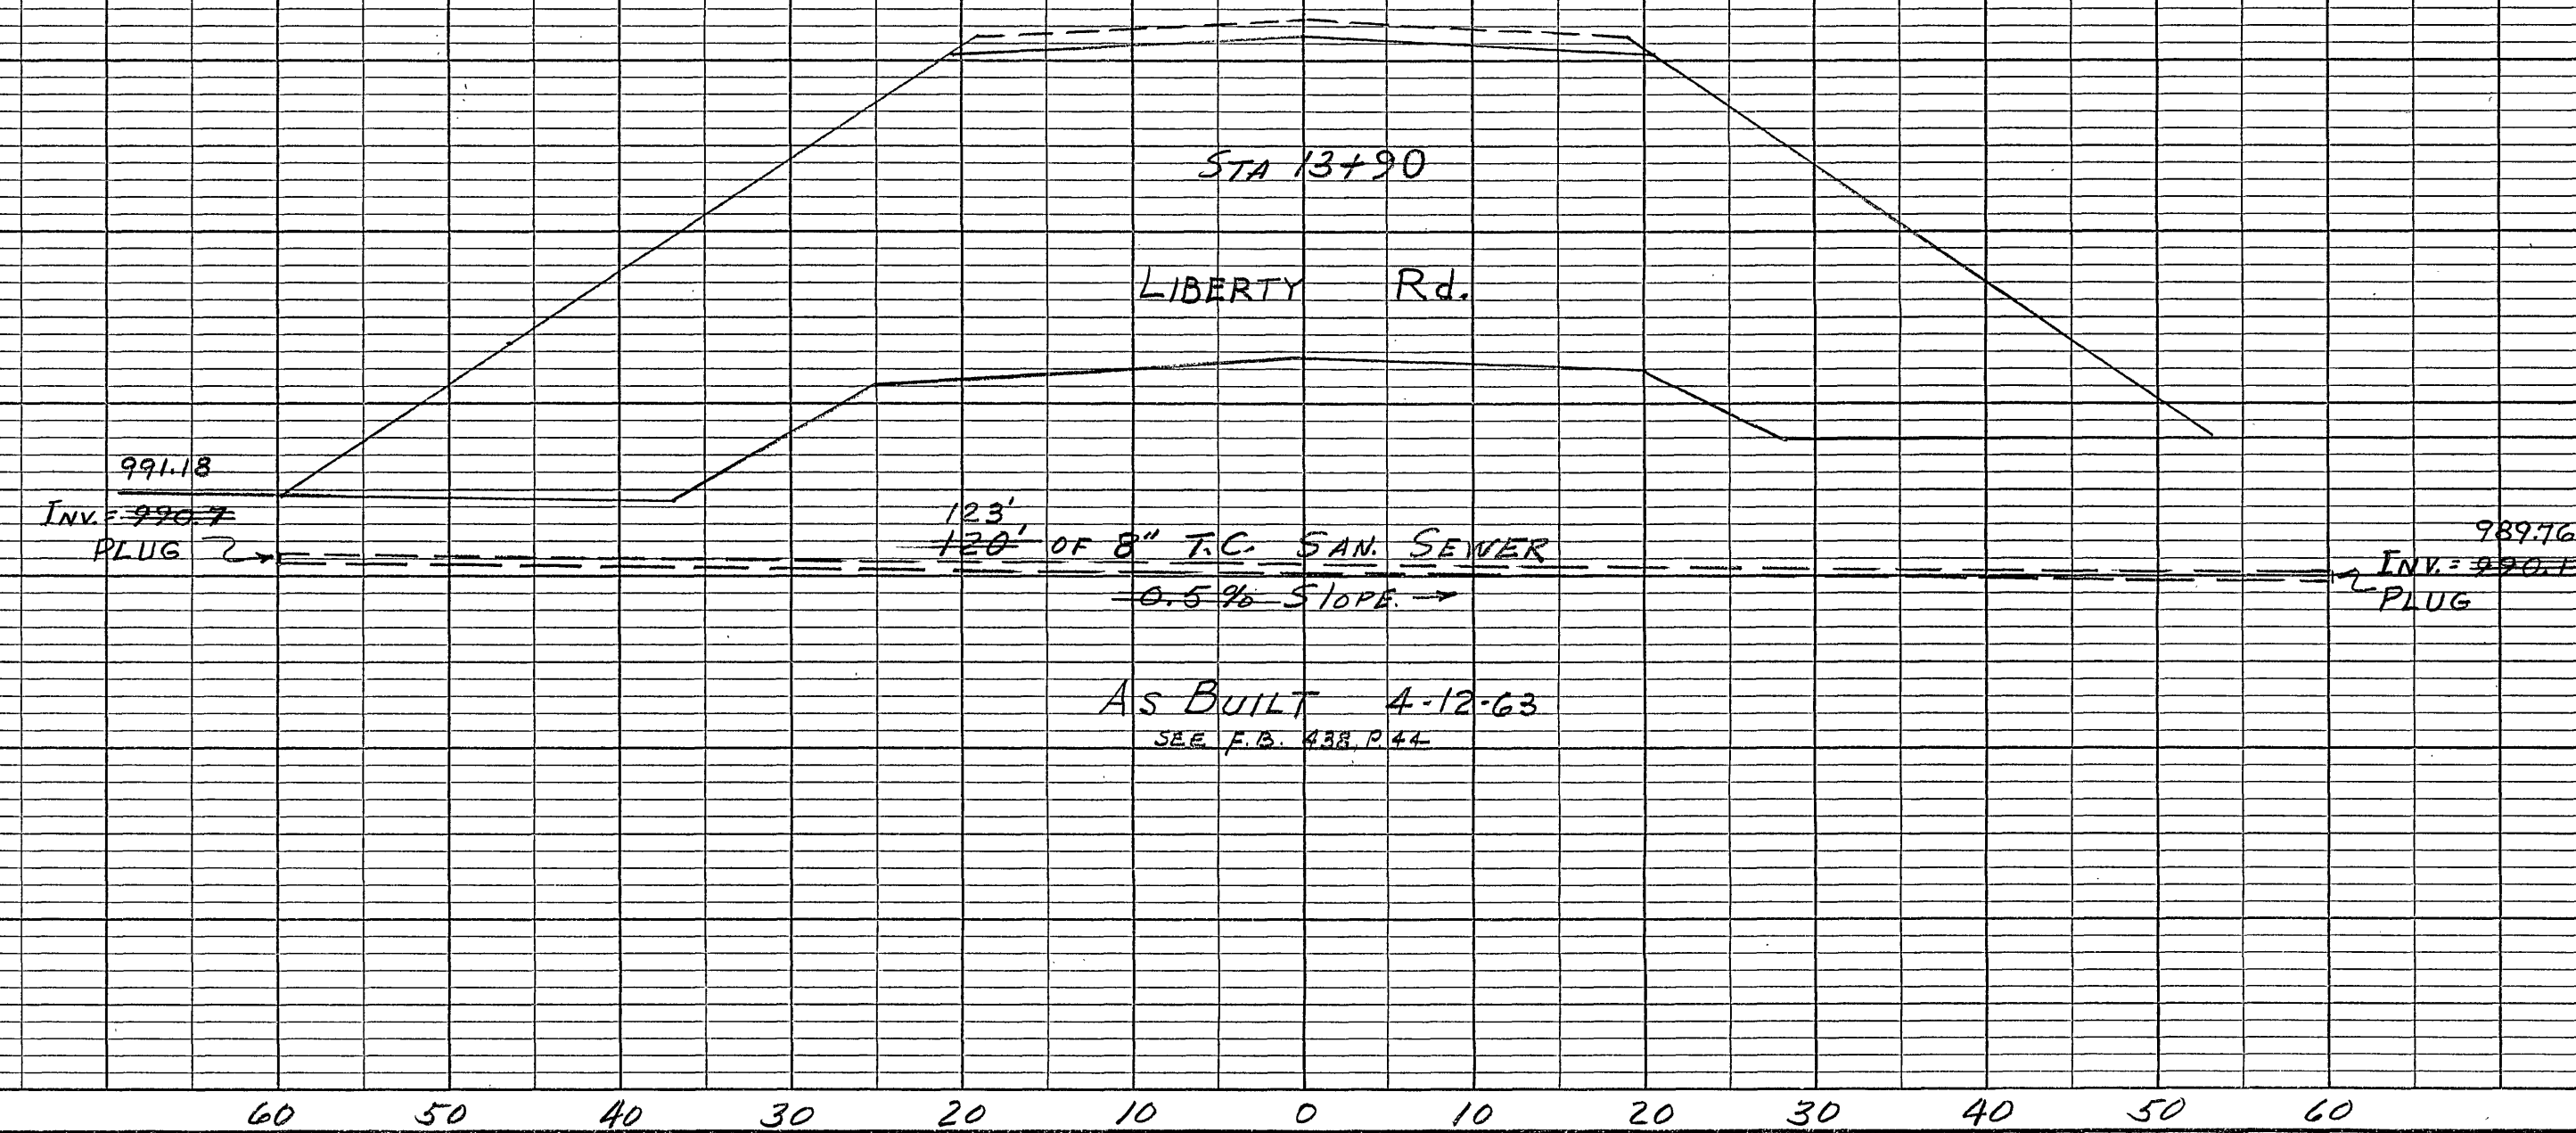


PLAN	SURVEYED	BY	DATE
	NOTE BOOK NO.	ALIGNED CHECKED RT. OF WAY CHECKED	

PROFILE	SURVEYED	BY	DATE
	NOTE BOOK NO.	GRADES CHECKED STRUCTURE NOTATION CHECKED	

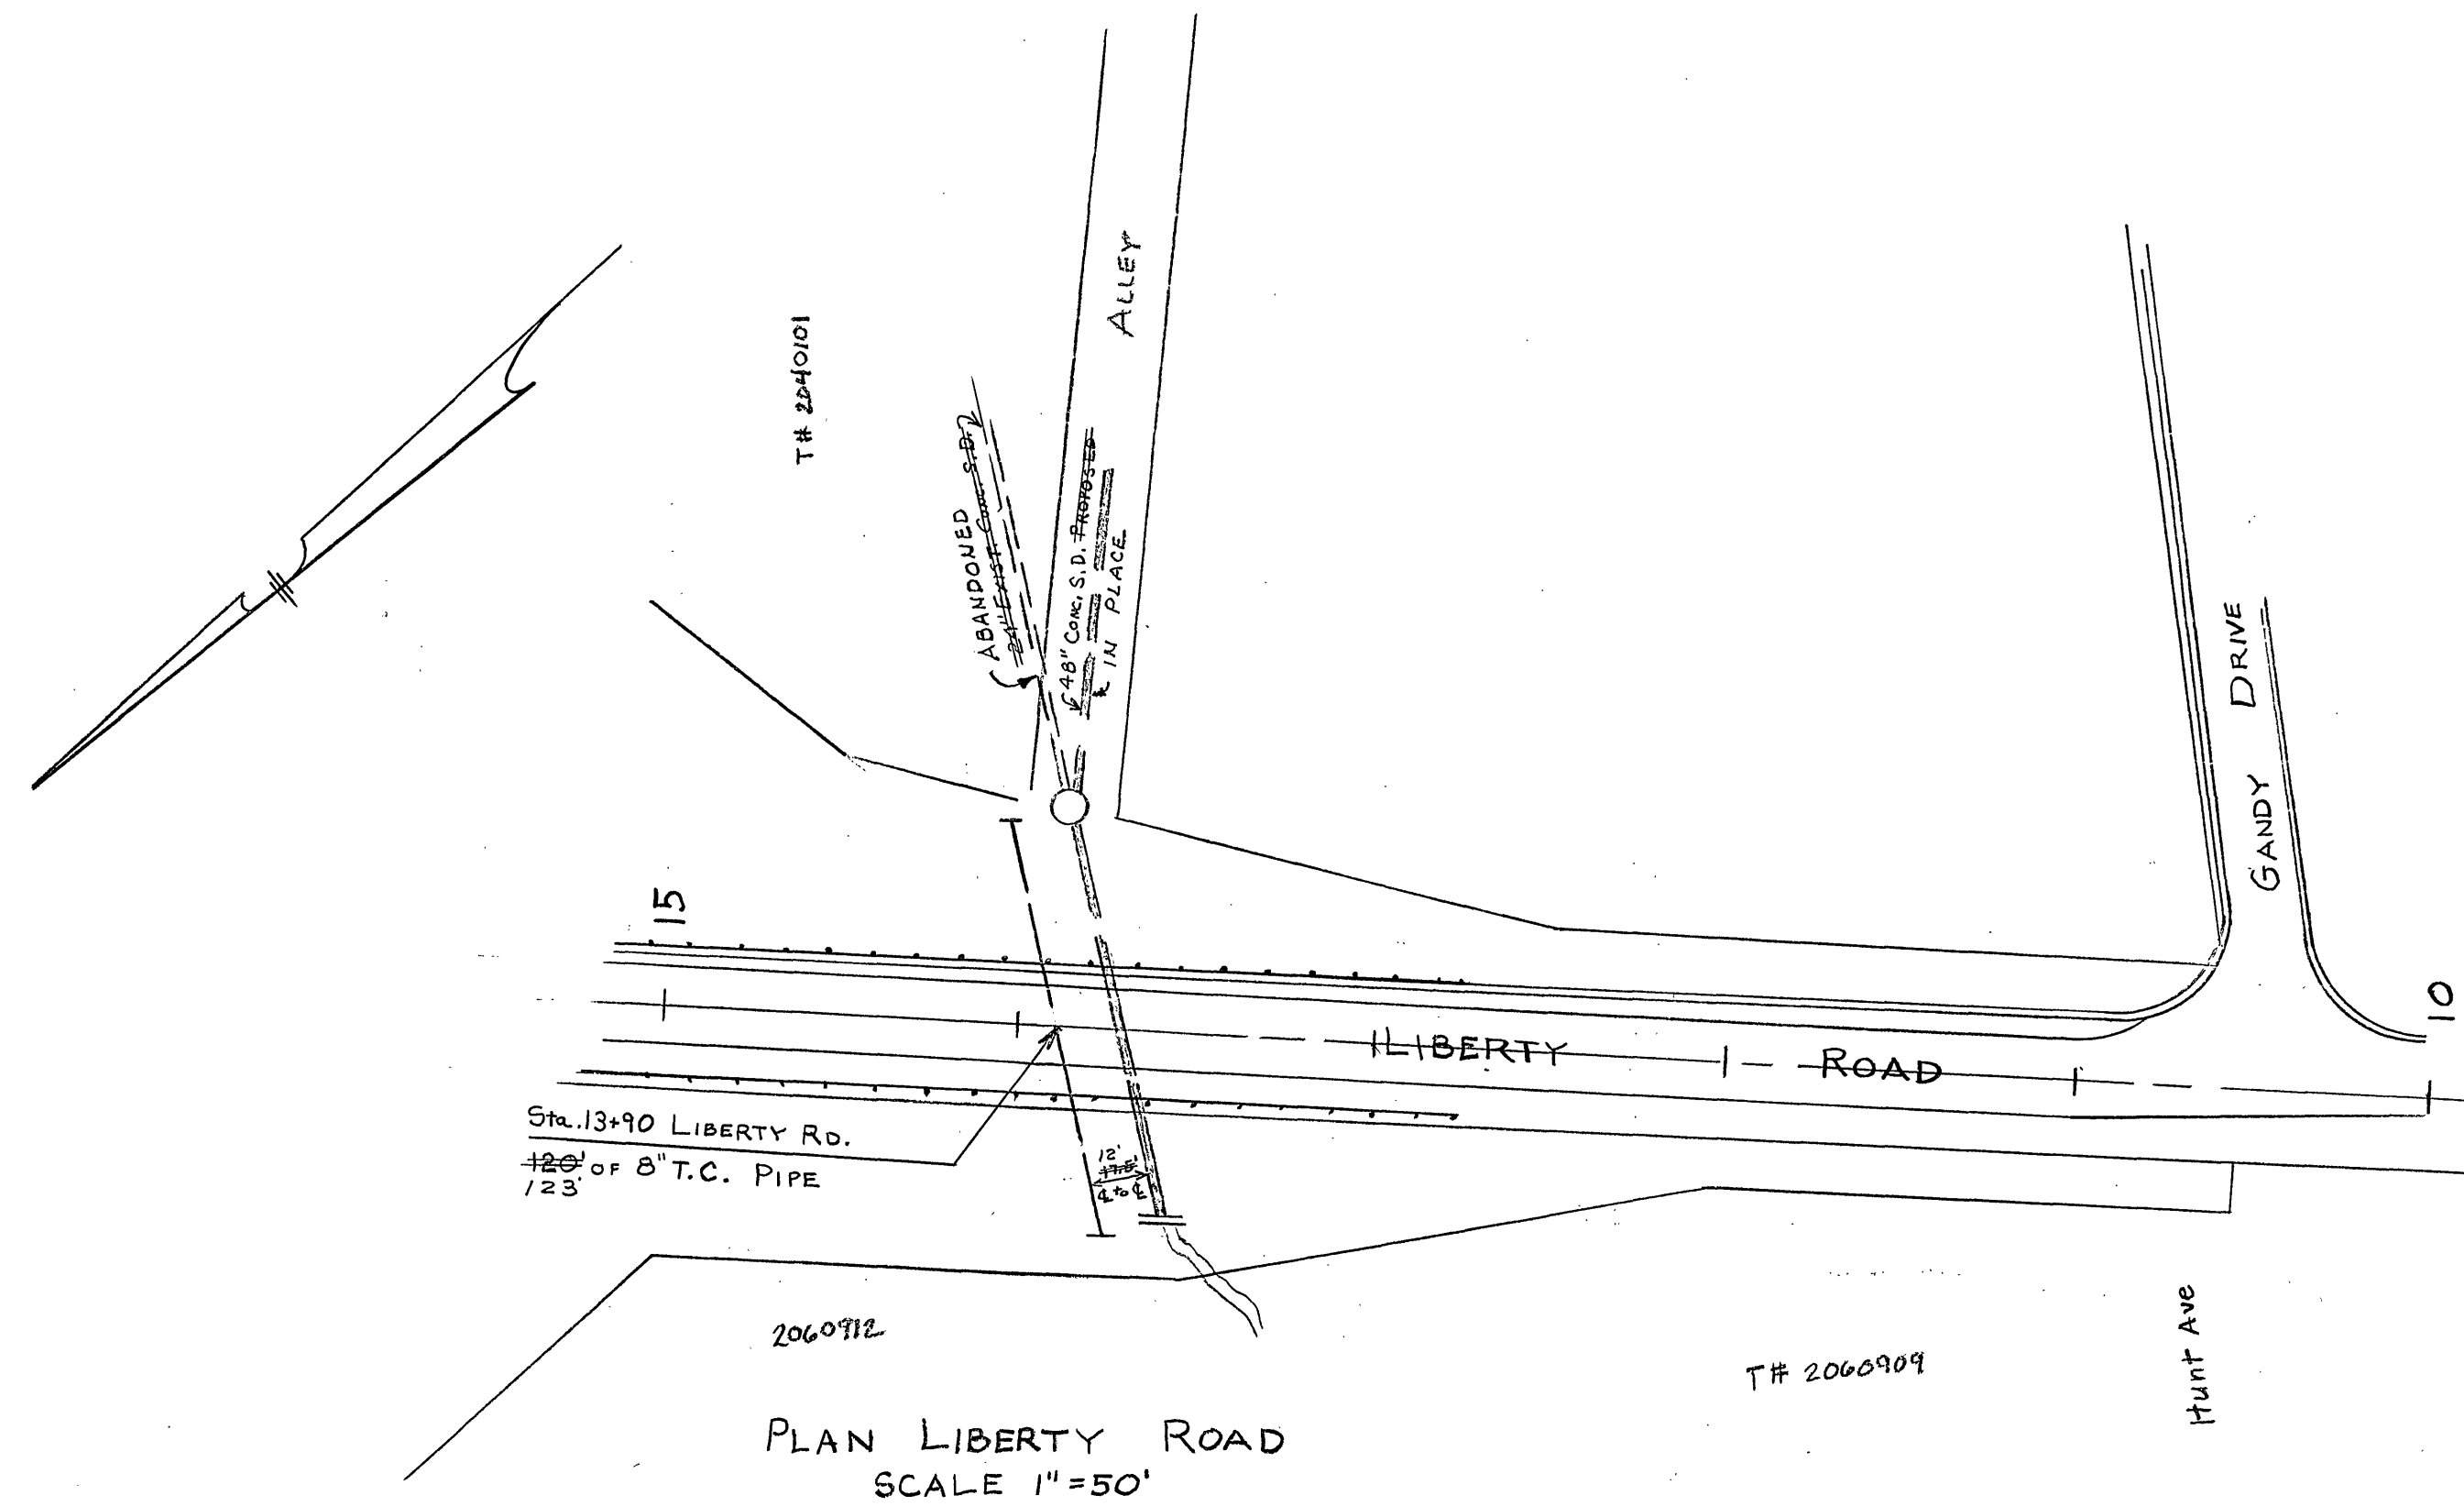

V.D.H. PROJECT No. 0581-128-070
R/W 201

OFFICE OF CITY ENGINEER
ROANOKE VIRGINIA
PLAN & PROFILE
SHOWING SAN. SEWER CROSSING
SOUTH INTERSTATE ROUTE 581
ON LIBERTY ROAD STA. 13+90
SCALE 1"=50'
DATE: 4-4-68
T. Otis Taylor
DIRECTOR OF PUBLIC WORKS
PLAN NO. 4788