

240-537-3460
MARK SINK


CONTRACT DRAWINGS

WESTERN VIRGINIA WATER AUTHORITY

LIBERTY ROAD WATERLINE REPLACEMENT

WWWA PROJECT NO. 17150-15136

ROANOKE, VA
AUGUST 2010

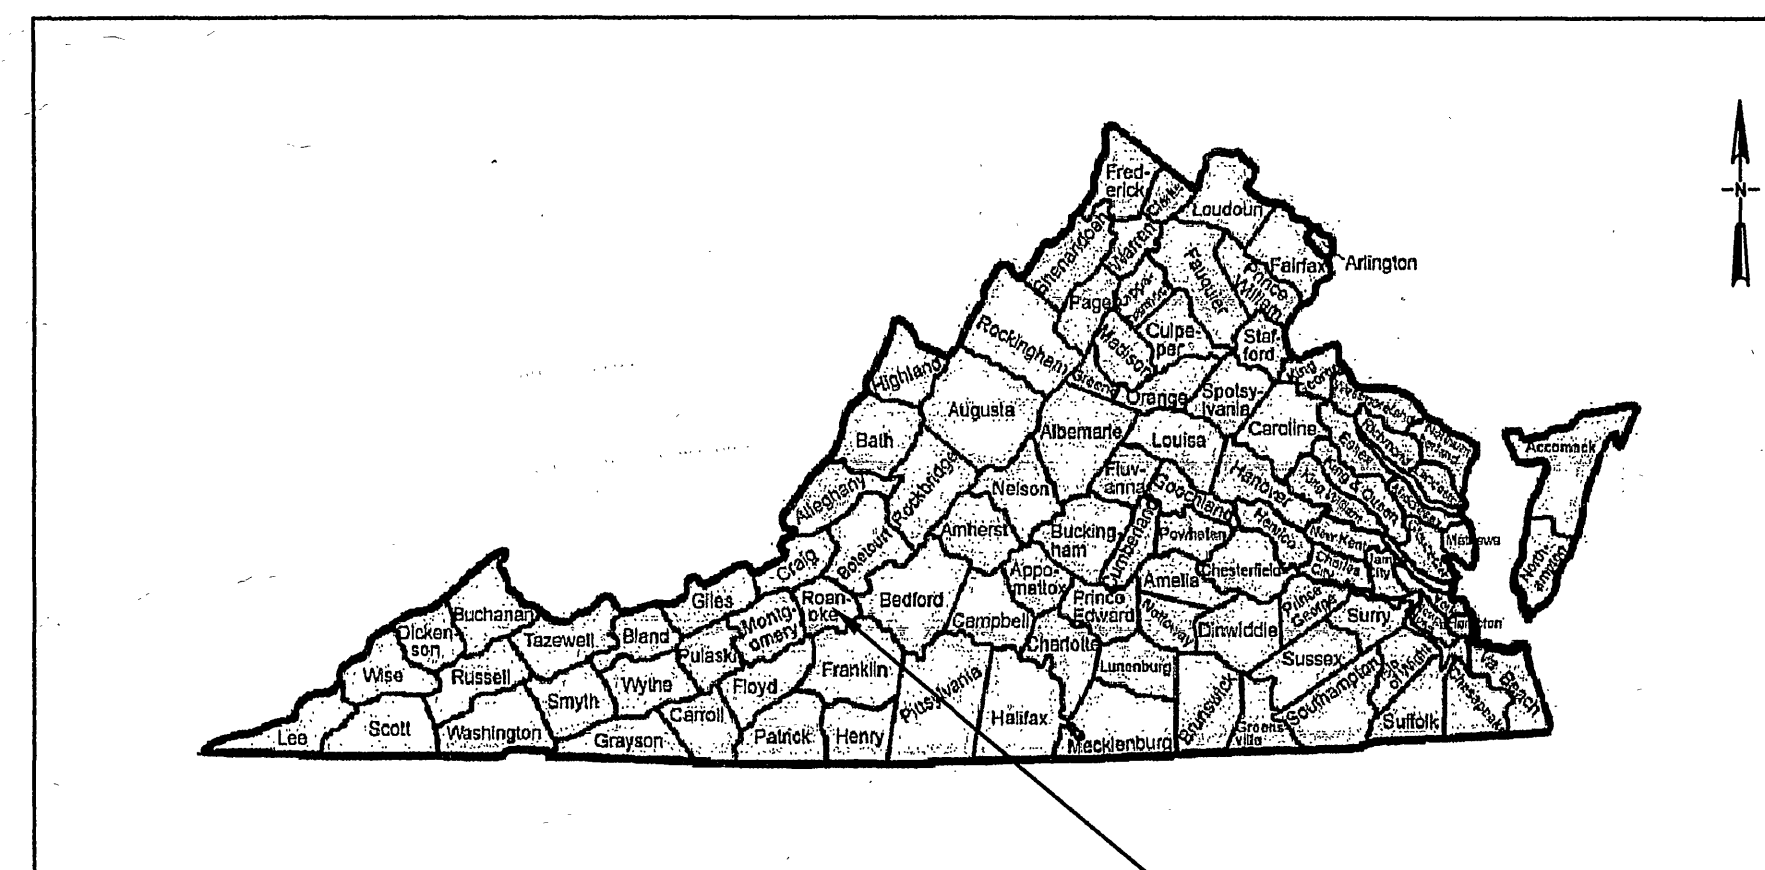

VICINITY MAP
NOT TO SCALE


PROJECT LOCATION
ROANOKE, VIRGINIA



WESTERN VIRGINIA
WATER AUTHORITY


Serving water and sewer customers in the City of Roanoke and Roanoke County

WESTERN VIRGINIA WATER AUTHORITY
601 SOUTH JEFFERSON STREET
ROANOKE, VIRGINIA 24011
PHONE: 540-853-5700
FAX: 540-853-1017
HTTP://WWW.WESTERNVAVATER.ORG/

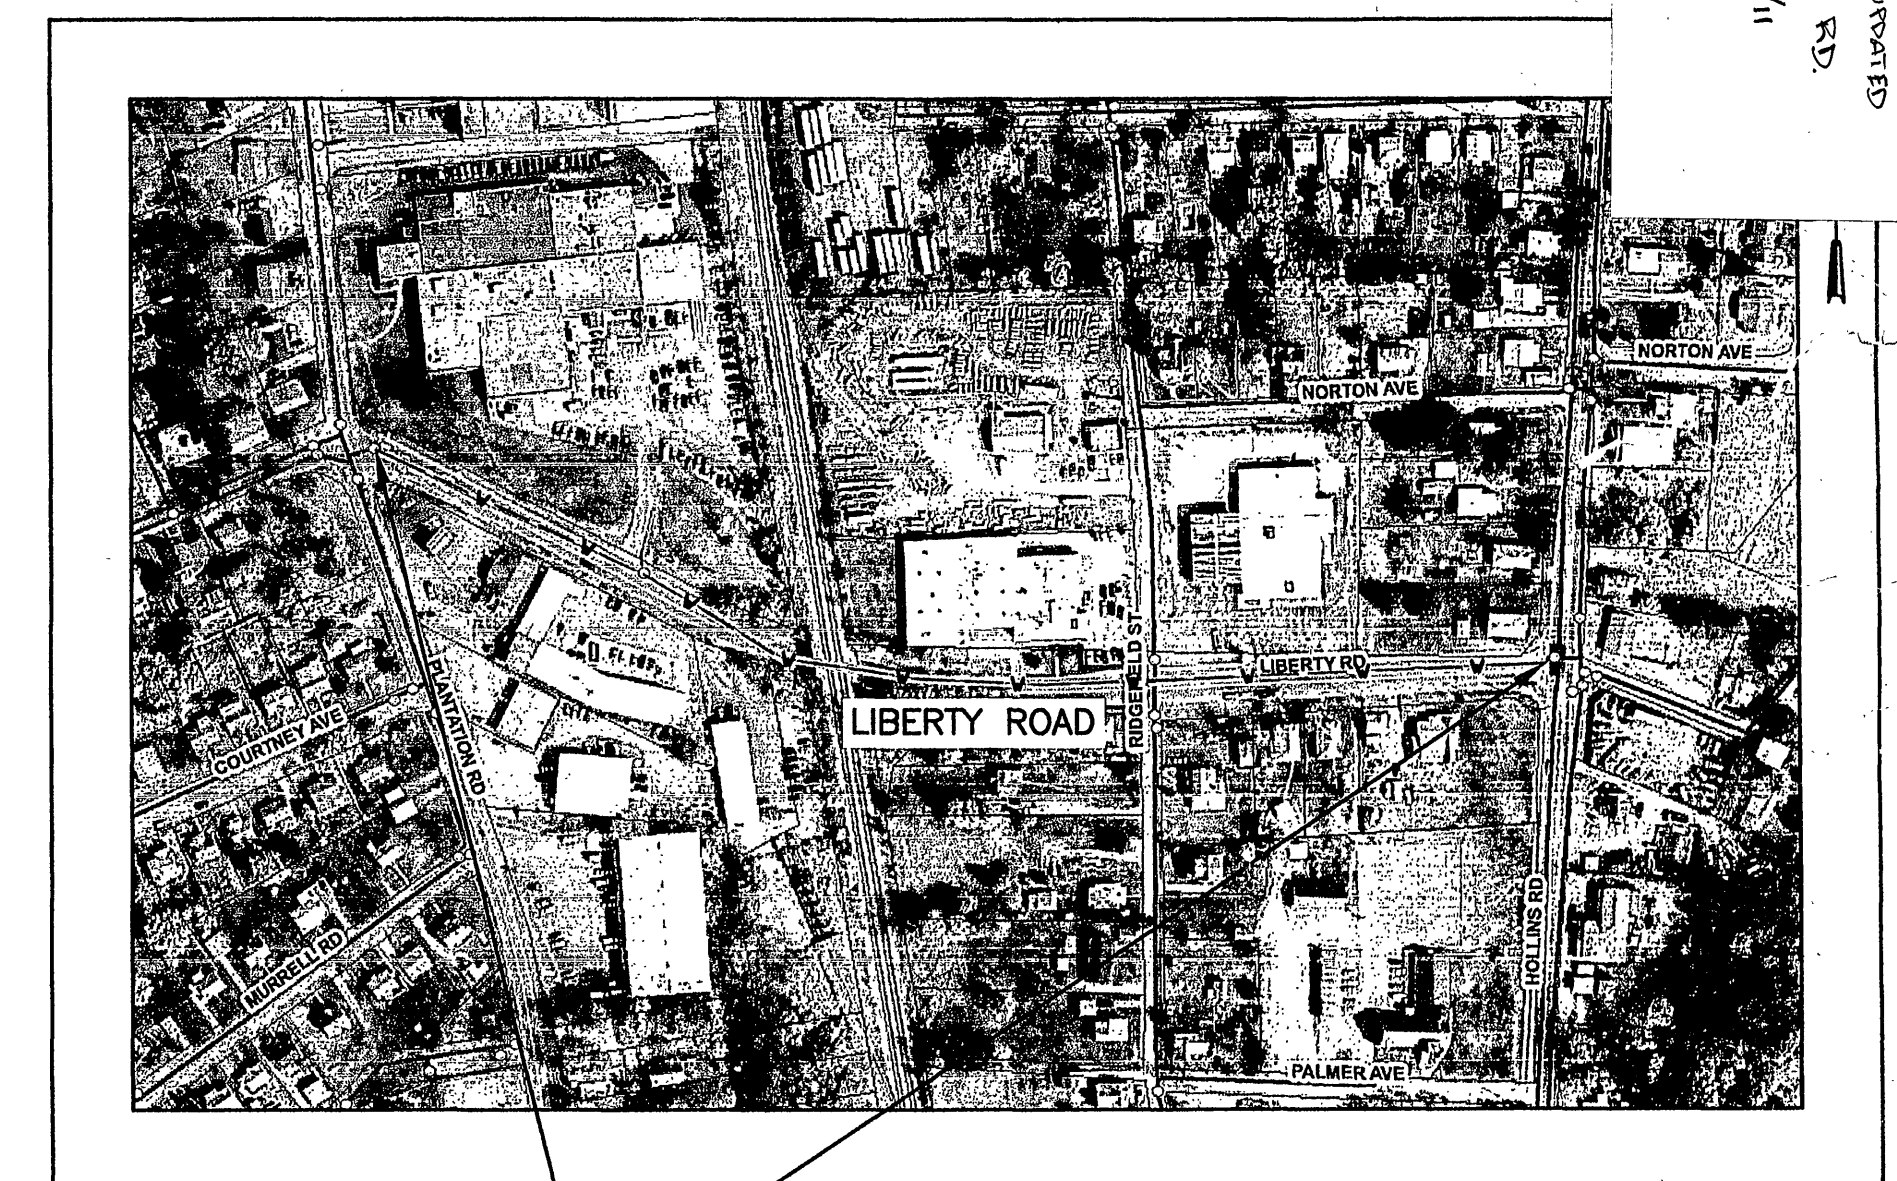


LIBERTY ROAD WATERLINE

LOCATION MAP
NOT TO SCALE

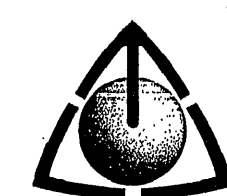

STEARNS & WHEELER^{LLC}
Environmental Engineers & Scientists

310 FIRST STREET S.W., SUITE 405
ROANOKE, VA 24011
PHONE: (540) 982-1910
FAX: (540) 982-1913

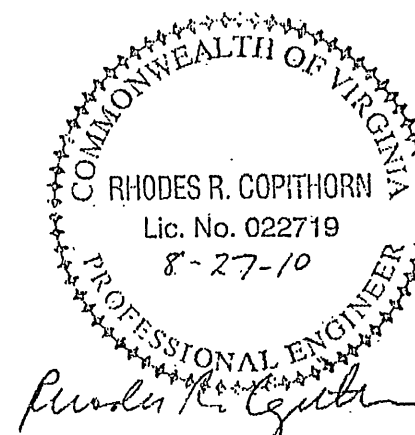

Rhodes R. Copithorn

As-Built 4/27/2011
Miss Utility 1-800-552-7001

1-12" 5/cew
7-12" mega lug
1-10" mega lug
BRAIN COOL - WATER - 9.30
540-529-1157

INFORMED
LIBERTY RD.
6/24/11
BPA