


AS BUILT
1-30-69
FROM PRINTS SENT IN TO
THE FIELD.

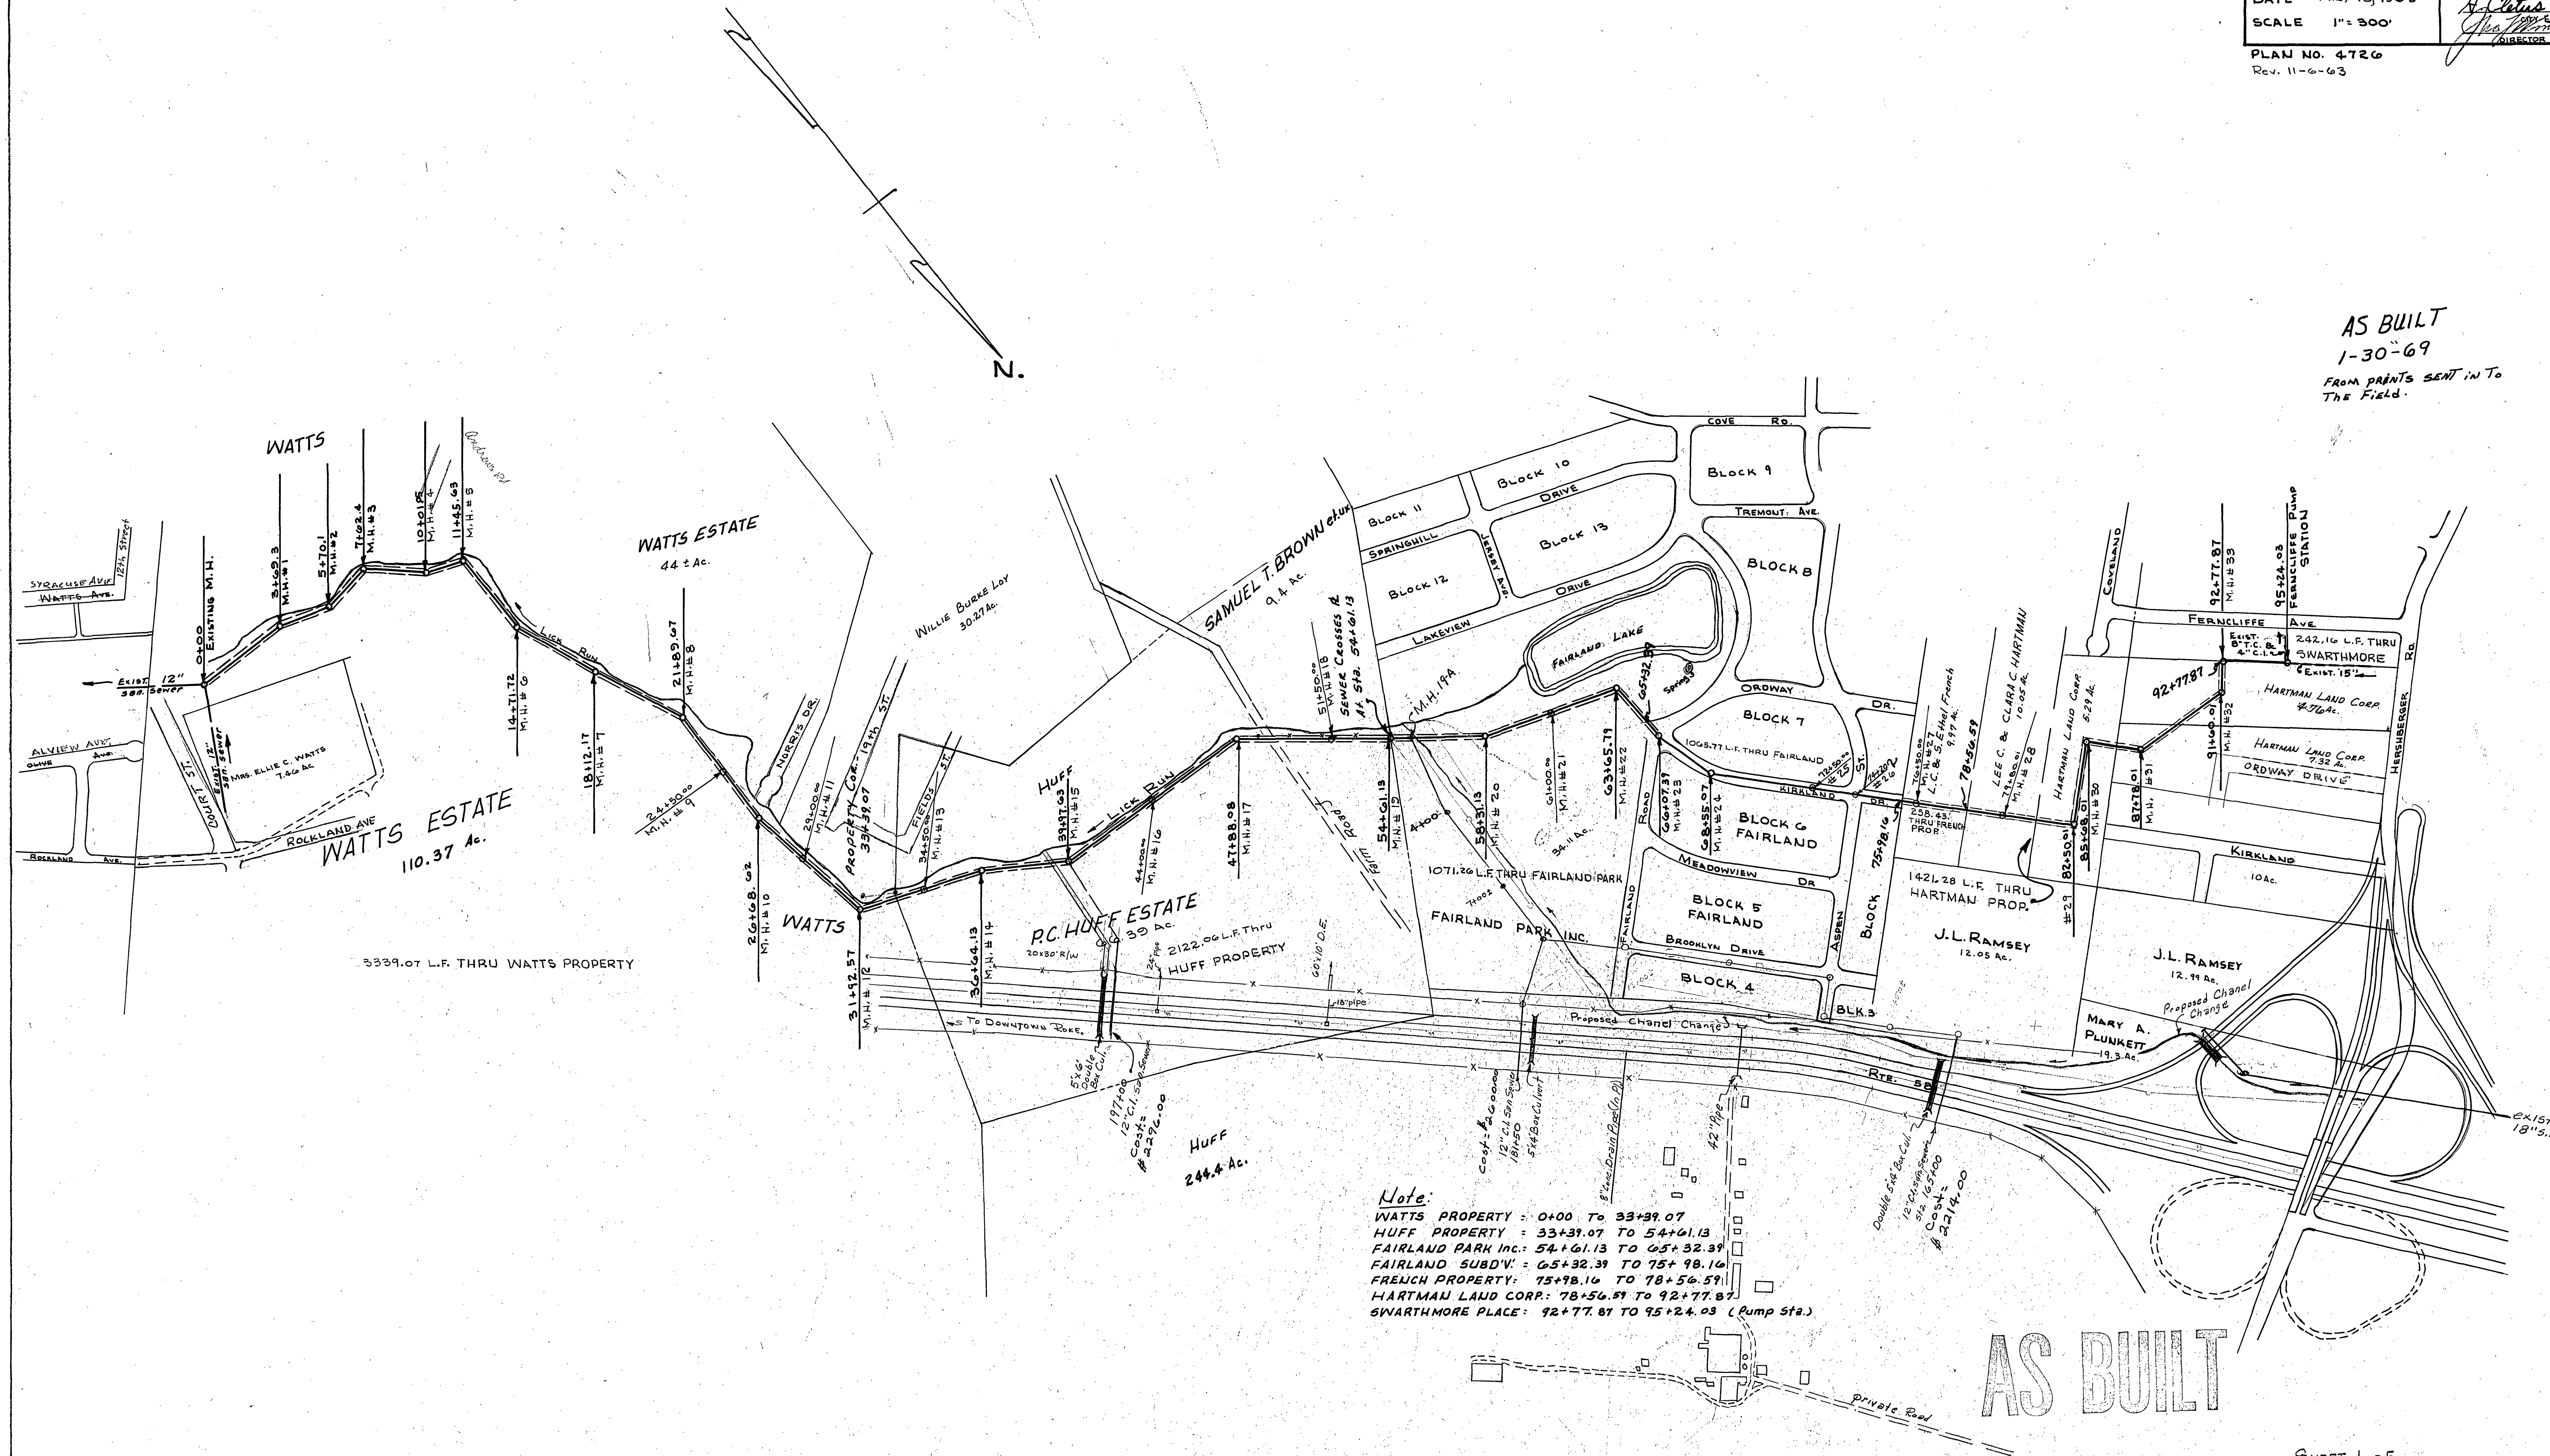

Note:
 WATTS PROPERTY : 0+00 TO 33+39.07
 HUFF PROPERTY : 33+39.07 TO 54+61.13
 FAIRLAND PARK INC. : 54+61.13 TO 65+32.39
 FAIRLAND SUBDV. : 65+32.39 TO 75+98.16
 FRENCH PROPERTY : 75+98.16 TO 78+56.59
 HARTMAN LAND CORP. : 78+56.59 TO 92+77.87
 SWARTHMORE PLACE : 92+77.87 TO 95+24.03 (Pump Sta.)

AS BUILT