
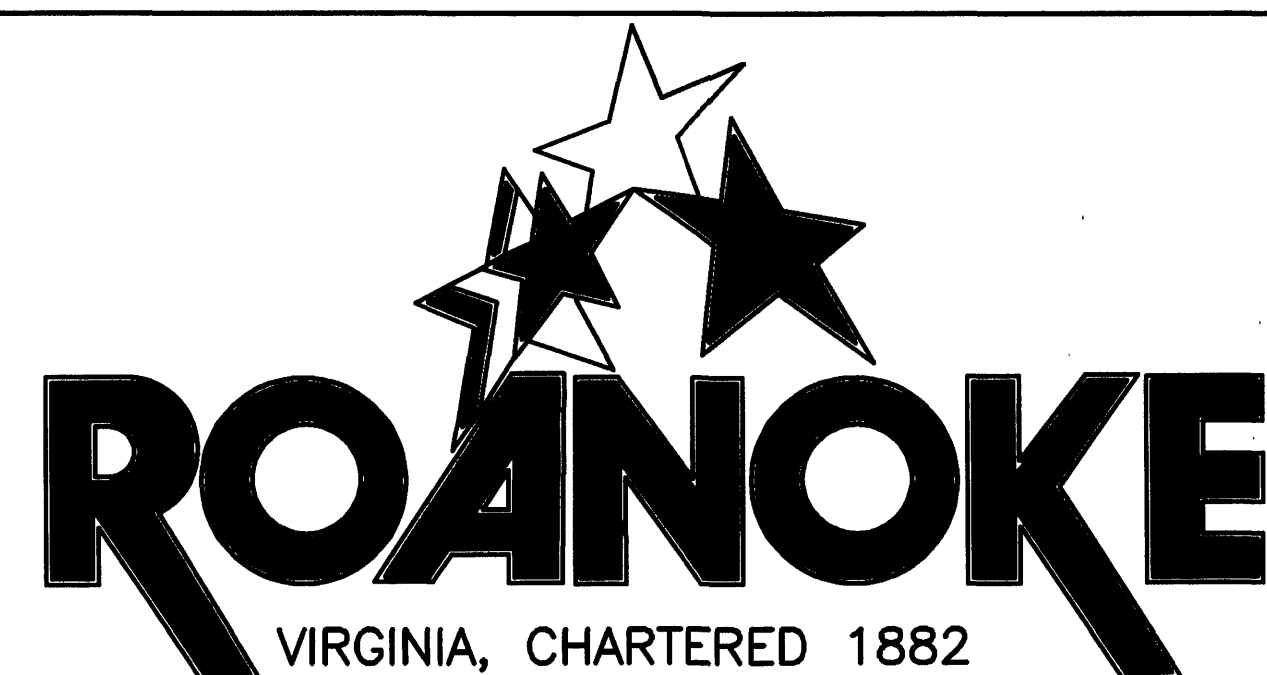


PROJECT LOCATION MAP

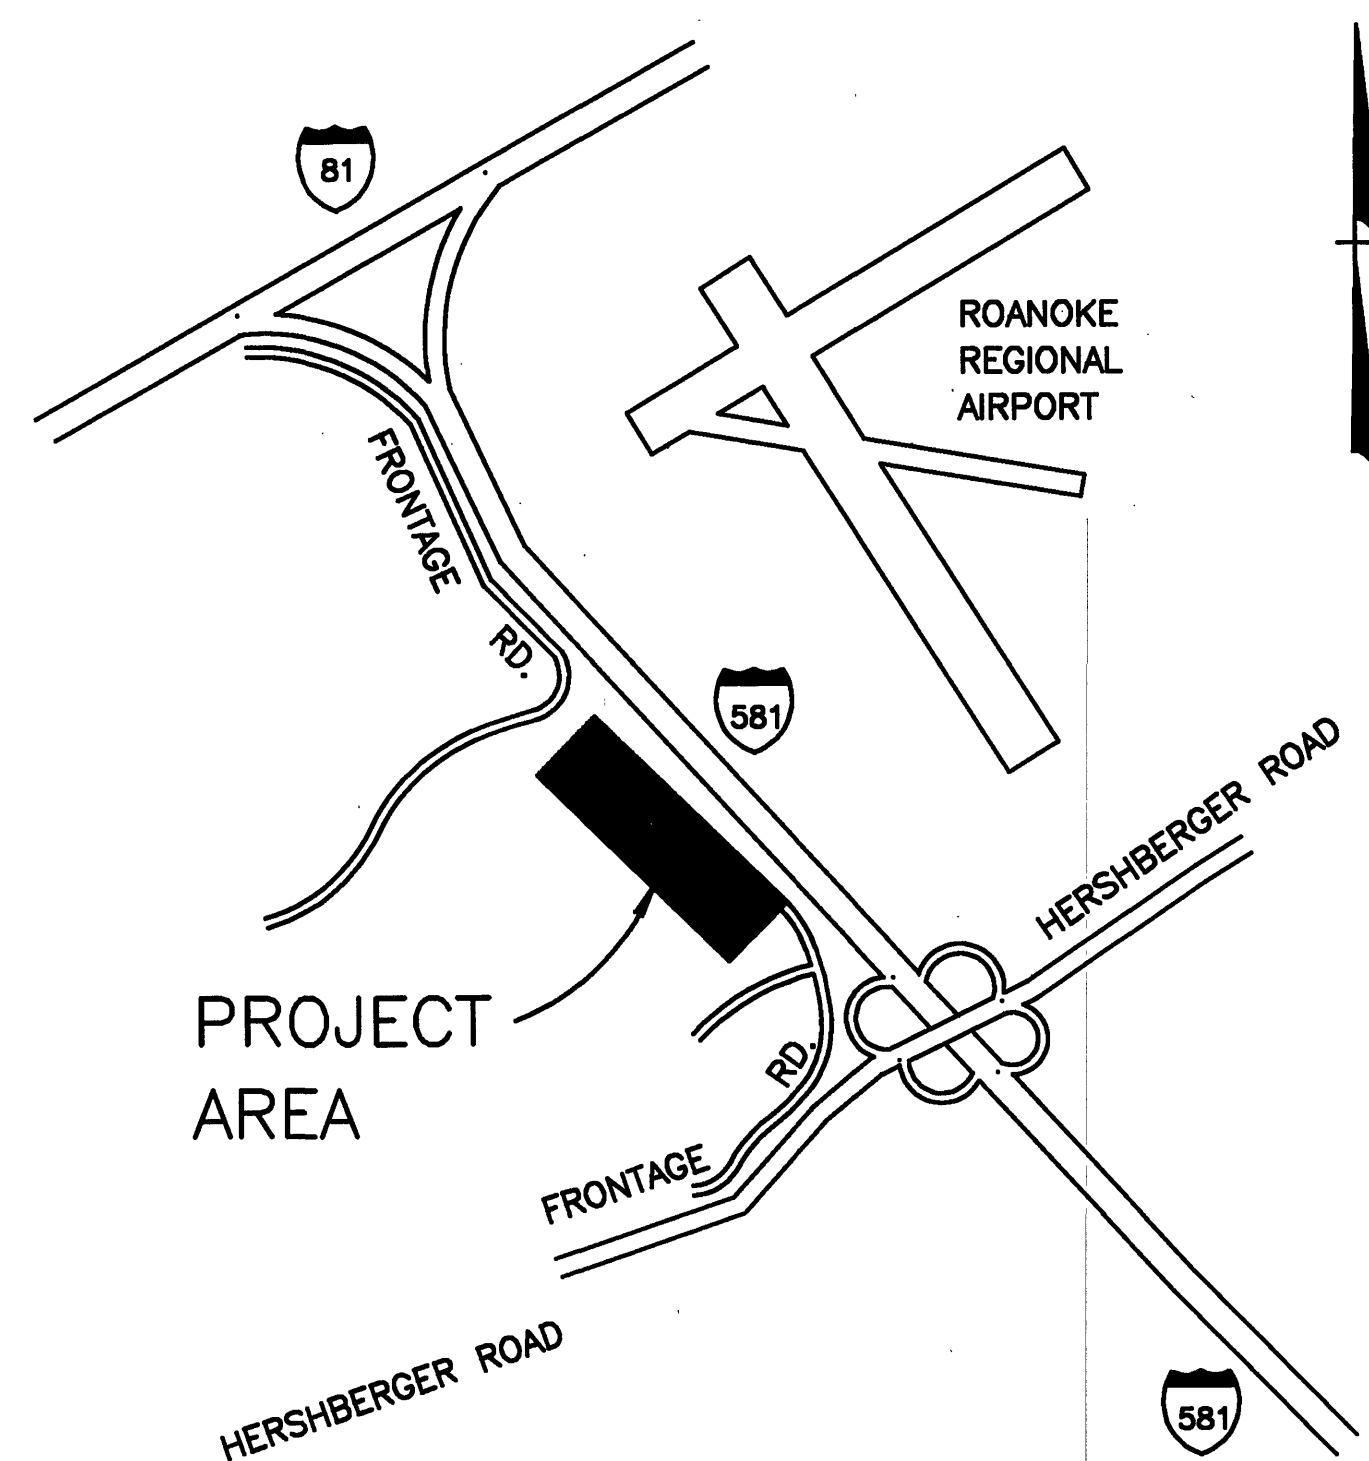

OFFICE OF CITY ENGINEER
ROOM 350
MUNICIPAL BUILDING
215 CHURCH AVENUE, S.W.
ROANOKE, VIRGINIA 24011

INDEX OF SHEETS


- 1 TITLE
- 2 SUMMARY OF QUANTITIES
- 3 GENERAL ABBREVIATIONS & LEGEND
- 4 SHEET INDEX & GENERAL NOTES
- 5 PLAN & PROFILE
- 6 PLAN & PROFILE
- 7 PLAN & PROFILE
- 8 PLAN & PROFILE
- 9 PLAN & PROFILE

CONSULTING ENGINEERS



CONSULTING ENGINEERS
SURVEYORS
701 FIRST STREET
ROANOKE, VIRGINIA

COMMISSION NUMBER: 1245F

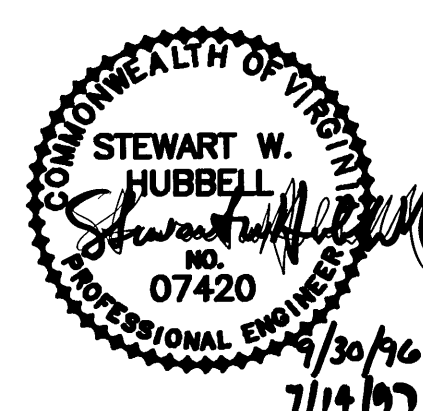

PROJECT NAME

LICK RUN SEWER REPLACEMENT
PROJECT LR-2
CITY OF ROANOKE, VIRGINIA

PROJECT NUMBER: 6245F

REVISION BY	DESCRIPTION:	DATE
REVISION BY	DESCRIPTION:	DATE
REVISION BY	DESCRIPTION:	DATE
REVISION BY	DESCRIPTION:	DATE

APPROVED FOR CONSTRUCTION

Charles M. Huffine 9-25-96
ROANOKE CITY ENGINEER DATE

William F. Clark 9-25-96
DIRECTOR OF PUBLIC WORKS DATE

Art B. L. 9/25/96
DIRECTOR OF PUBLIC UTILITIES AND OPERATIONS DATE

DATE

DATE

ADVERTISED DATE: 9-29-96

SET NUMBER: _____

SHEET NUMBER: 1 OF 9

RECORD DRAWING
7-14-97