
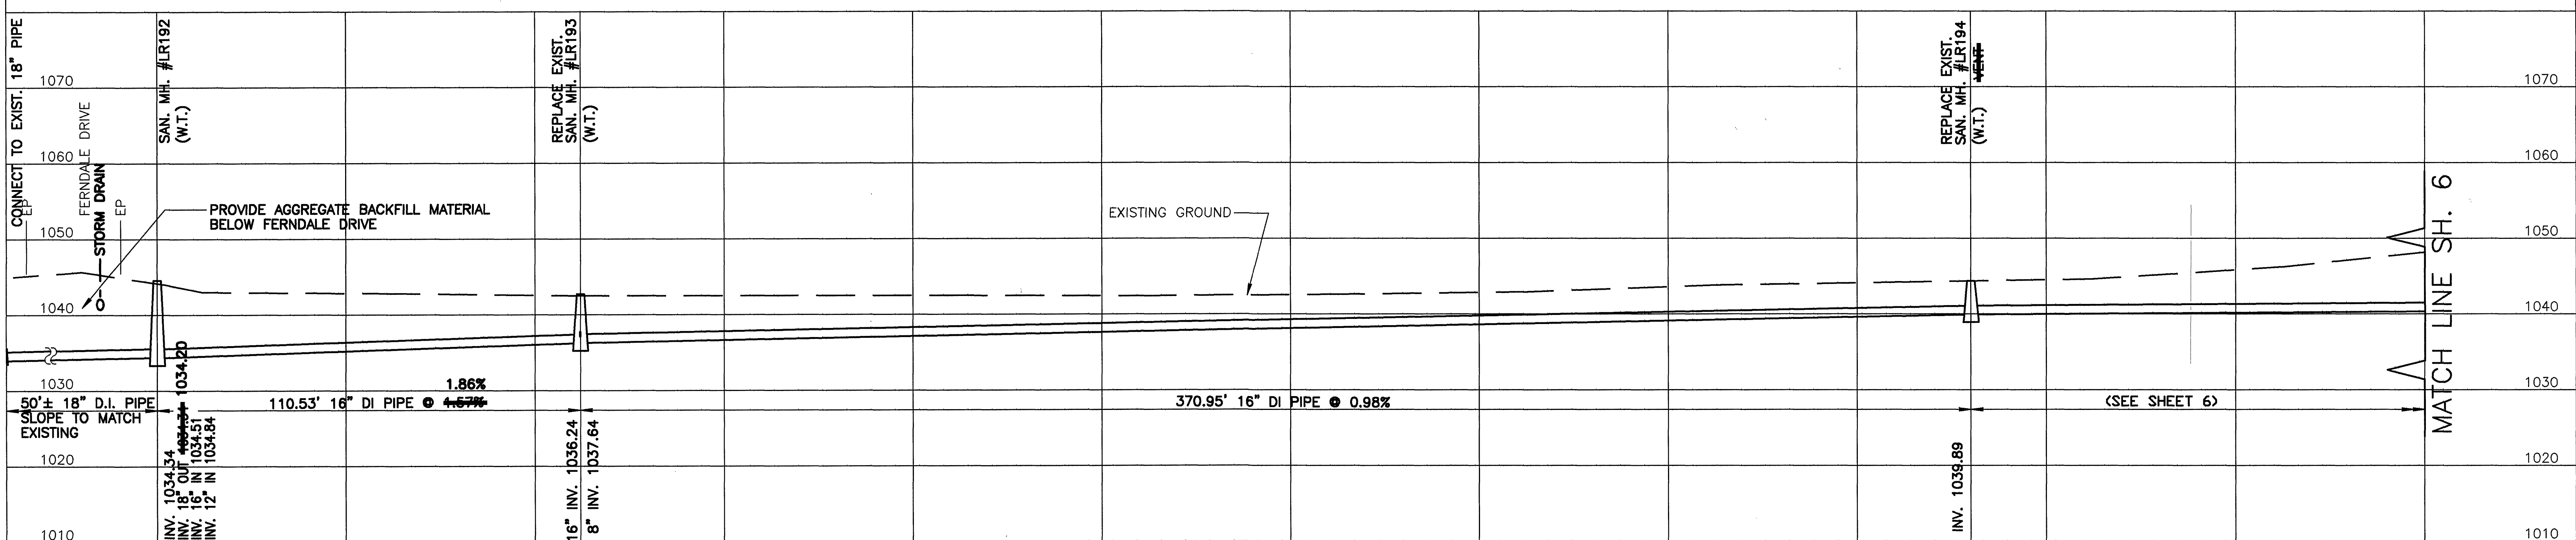


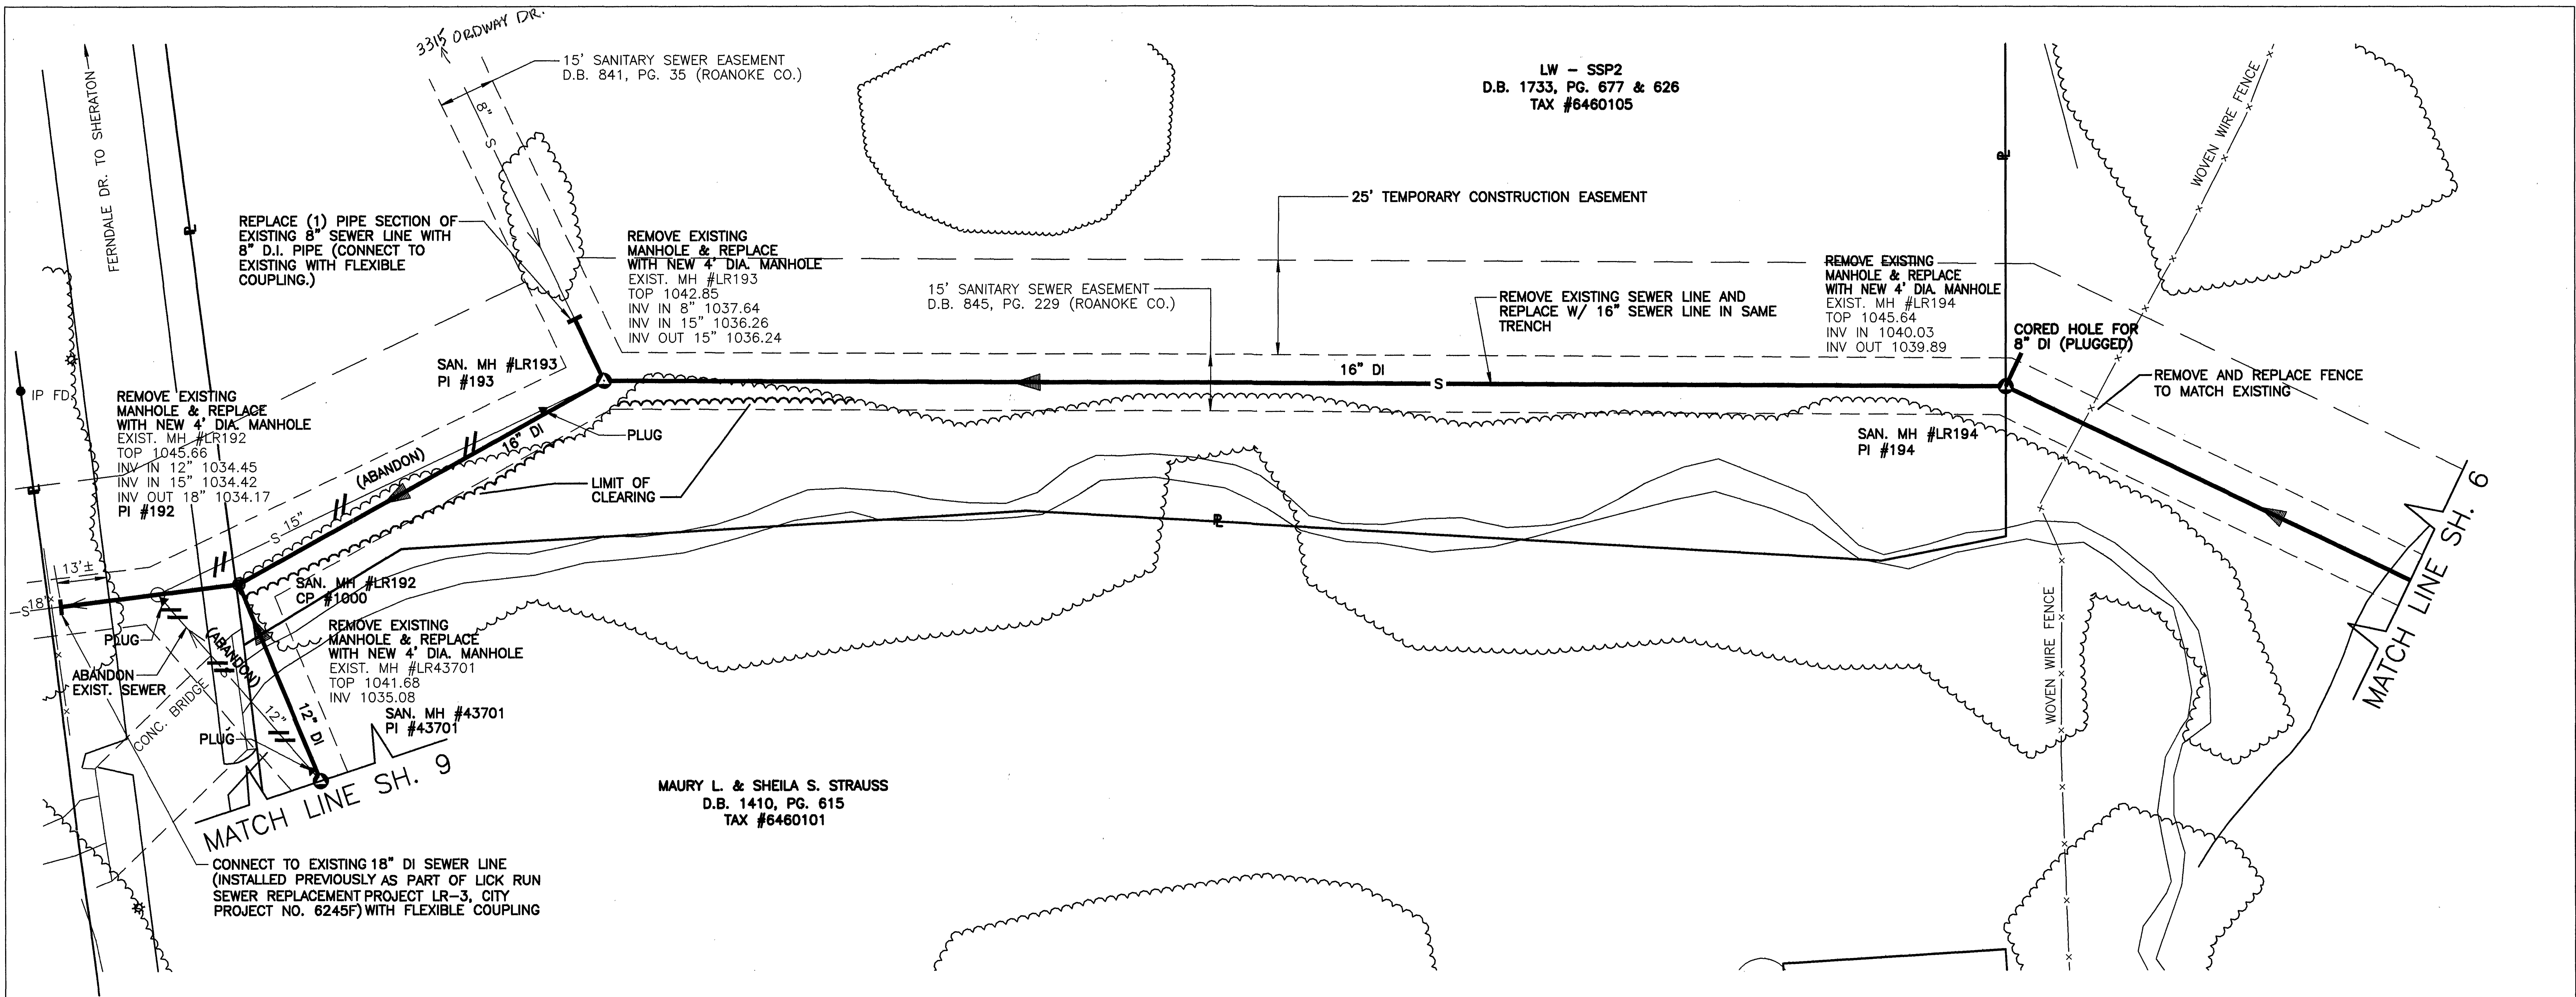

 Mattern & Craig CONSULTING ENGINEERS - SURVEYORS	DESIGNED:	TAM	 	REV.	DATE	DESCRIPTION	BY	APP.	DATE JANUARY 1994 COMM. NO. 1245F	LICK RUN SANITARY SEWER REPLACEMENT PROJECT LR-2 PLAN & PROFILE CITY OF ROANOKE, VIRGINIA SCALE: 1"=20' HORIZ. 1"=10' VERT.	SHEET 5
	DRAWN:	SMM		1	9-96	ADDED TEMPORARY CONSTRUCTION EASEMENT	TAM	SWH			
	CHECKED:	SWH		2	7-97	RECORD DRAWINGS	MRL	SWH			