
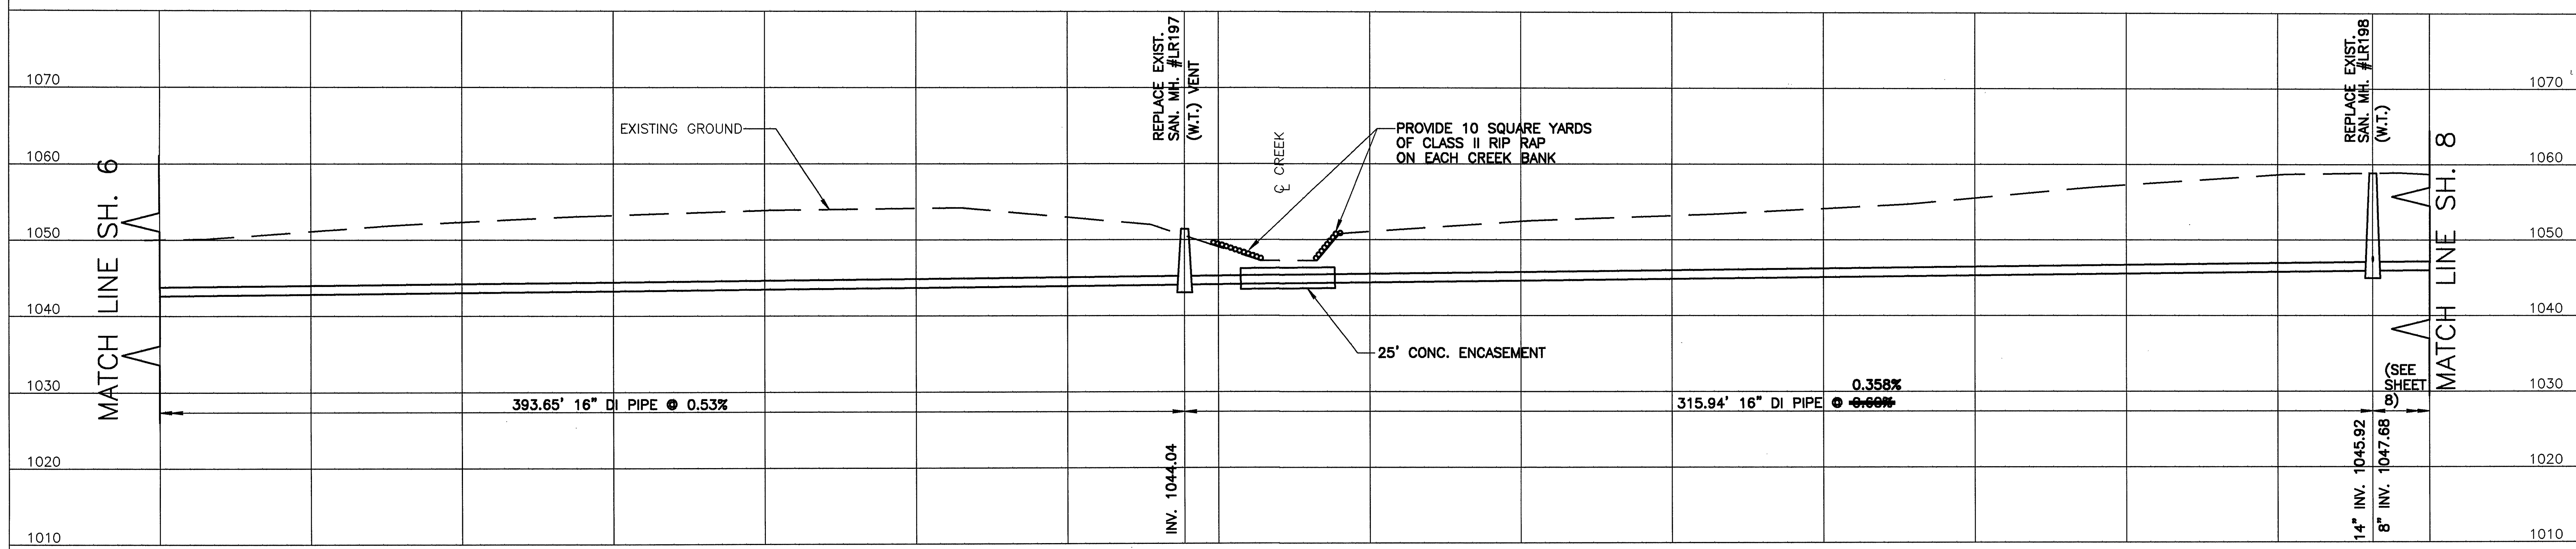


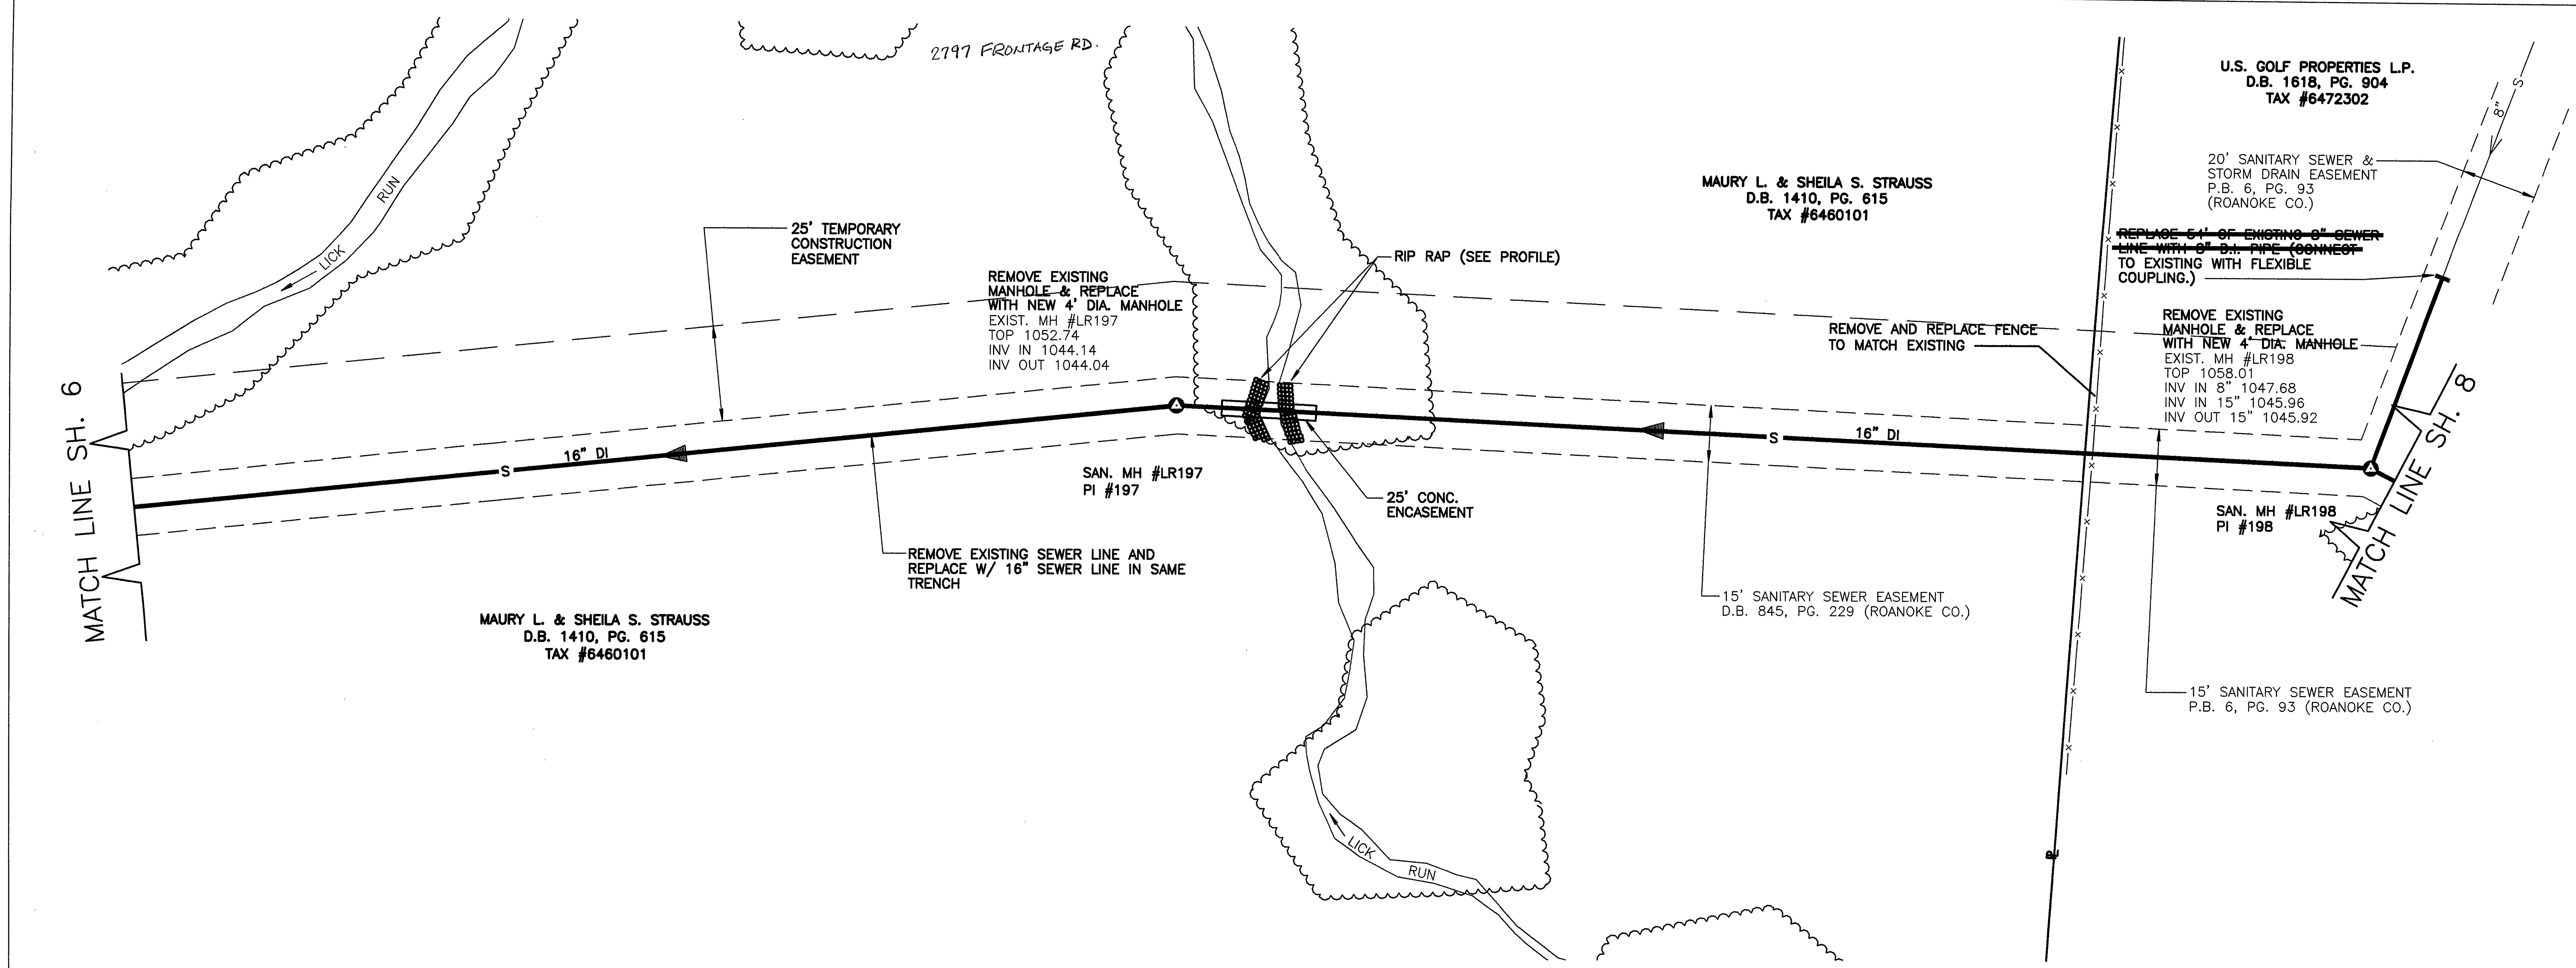

Mattern & Craig CONSULTING ENGINEERS - SURVEYORS	DESIGNED:	TAM			REV.	DATE	DESCRIPTION	BY	APP.	DATE JANUARY 1994 COMM. NO. 1245F	LICK RUN SANITARY SEWER REPLACEMENT PROJECT LR-2 PLAN & PROFILE CITY OF ROANOKE, VIRGINIA SCALE: 1"=20' HORIZ. 1"=10' VERT.	SHEET 7
	DRAWN:	SMM			9-96	7-97	ADDED TEMPORARY CONSTRUCTION EASEMENT	TAM	SWH			
	CHECKED:	SWH					RECORD DRAWINGS	MRL	SWH			