
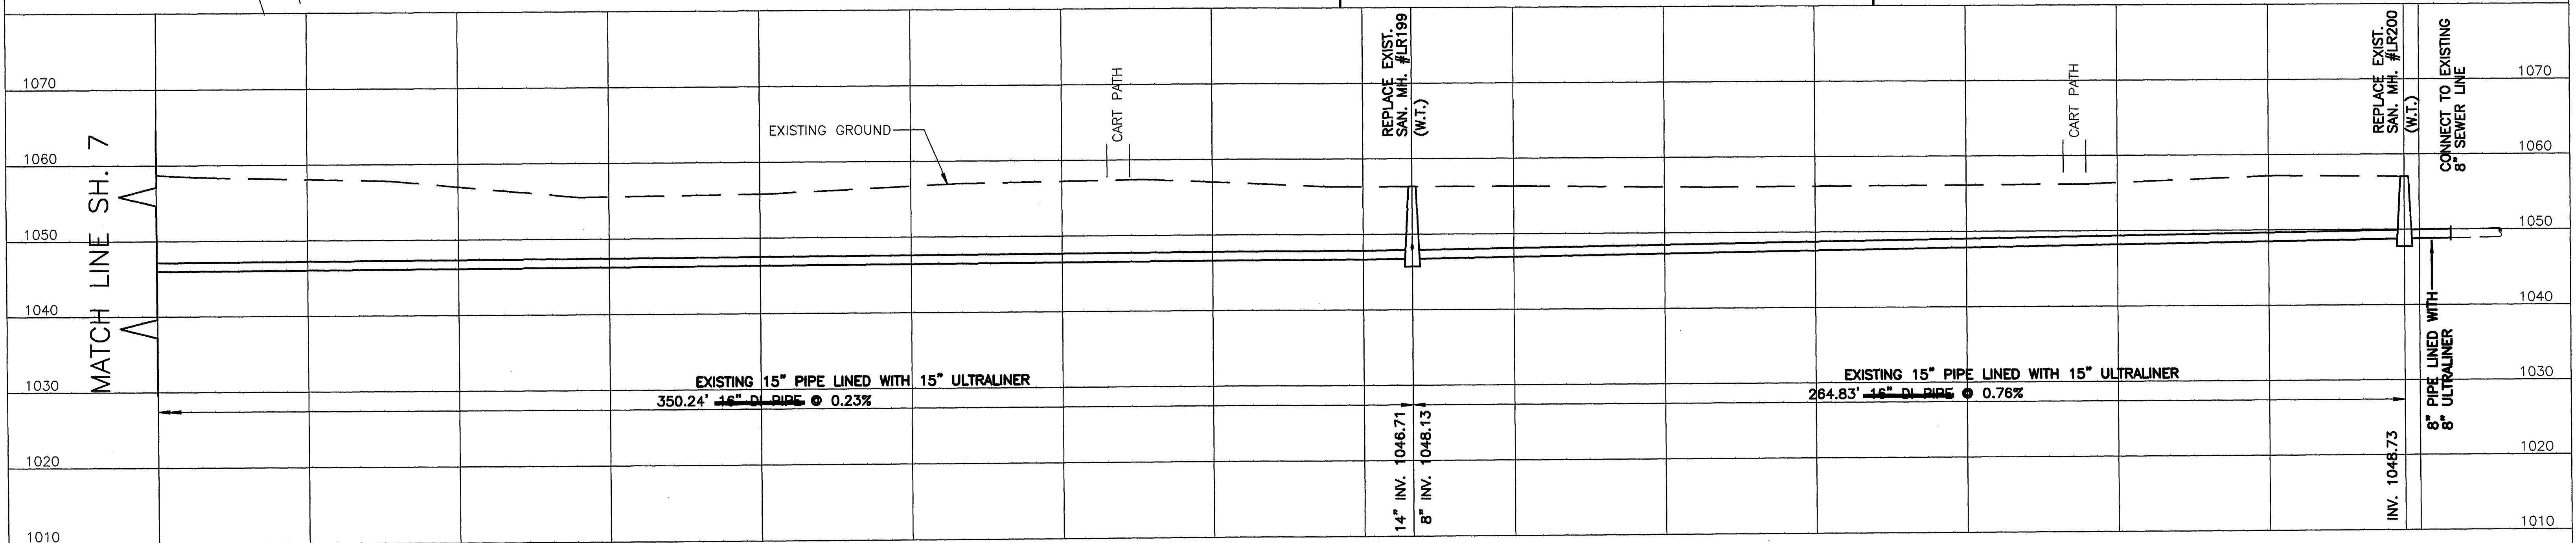


NOTE:
GOLF COURSE HAS UNDERGROUND SPRINKLER SYSTEM
WITH AC PIPES AND CONTROL WIRING IN SAME TRENCH.
CONTRACTOR SHALL VERIFY LOCATION PRIOR TO EXCAVATION
IN THIS AREA.

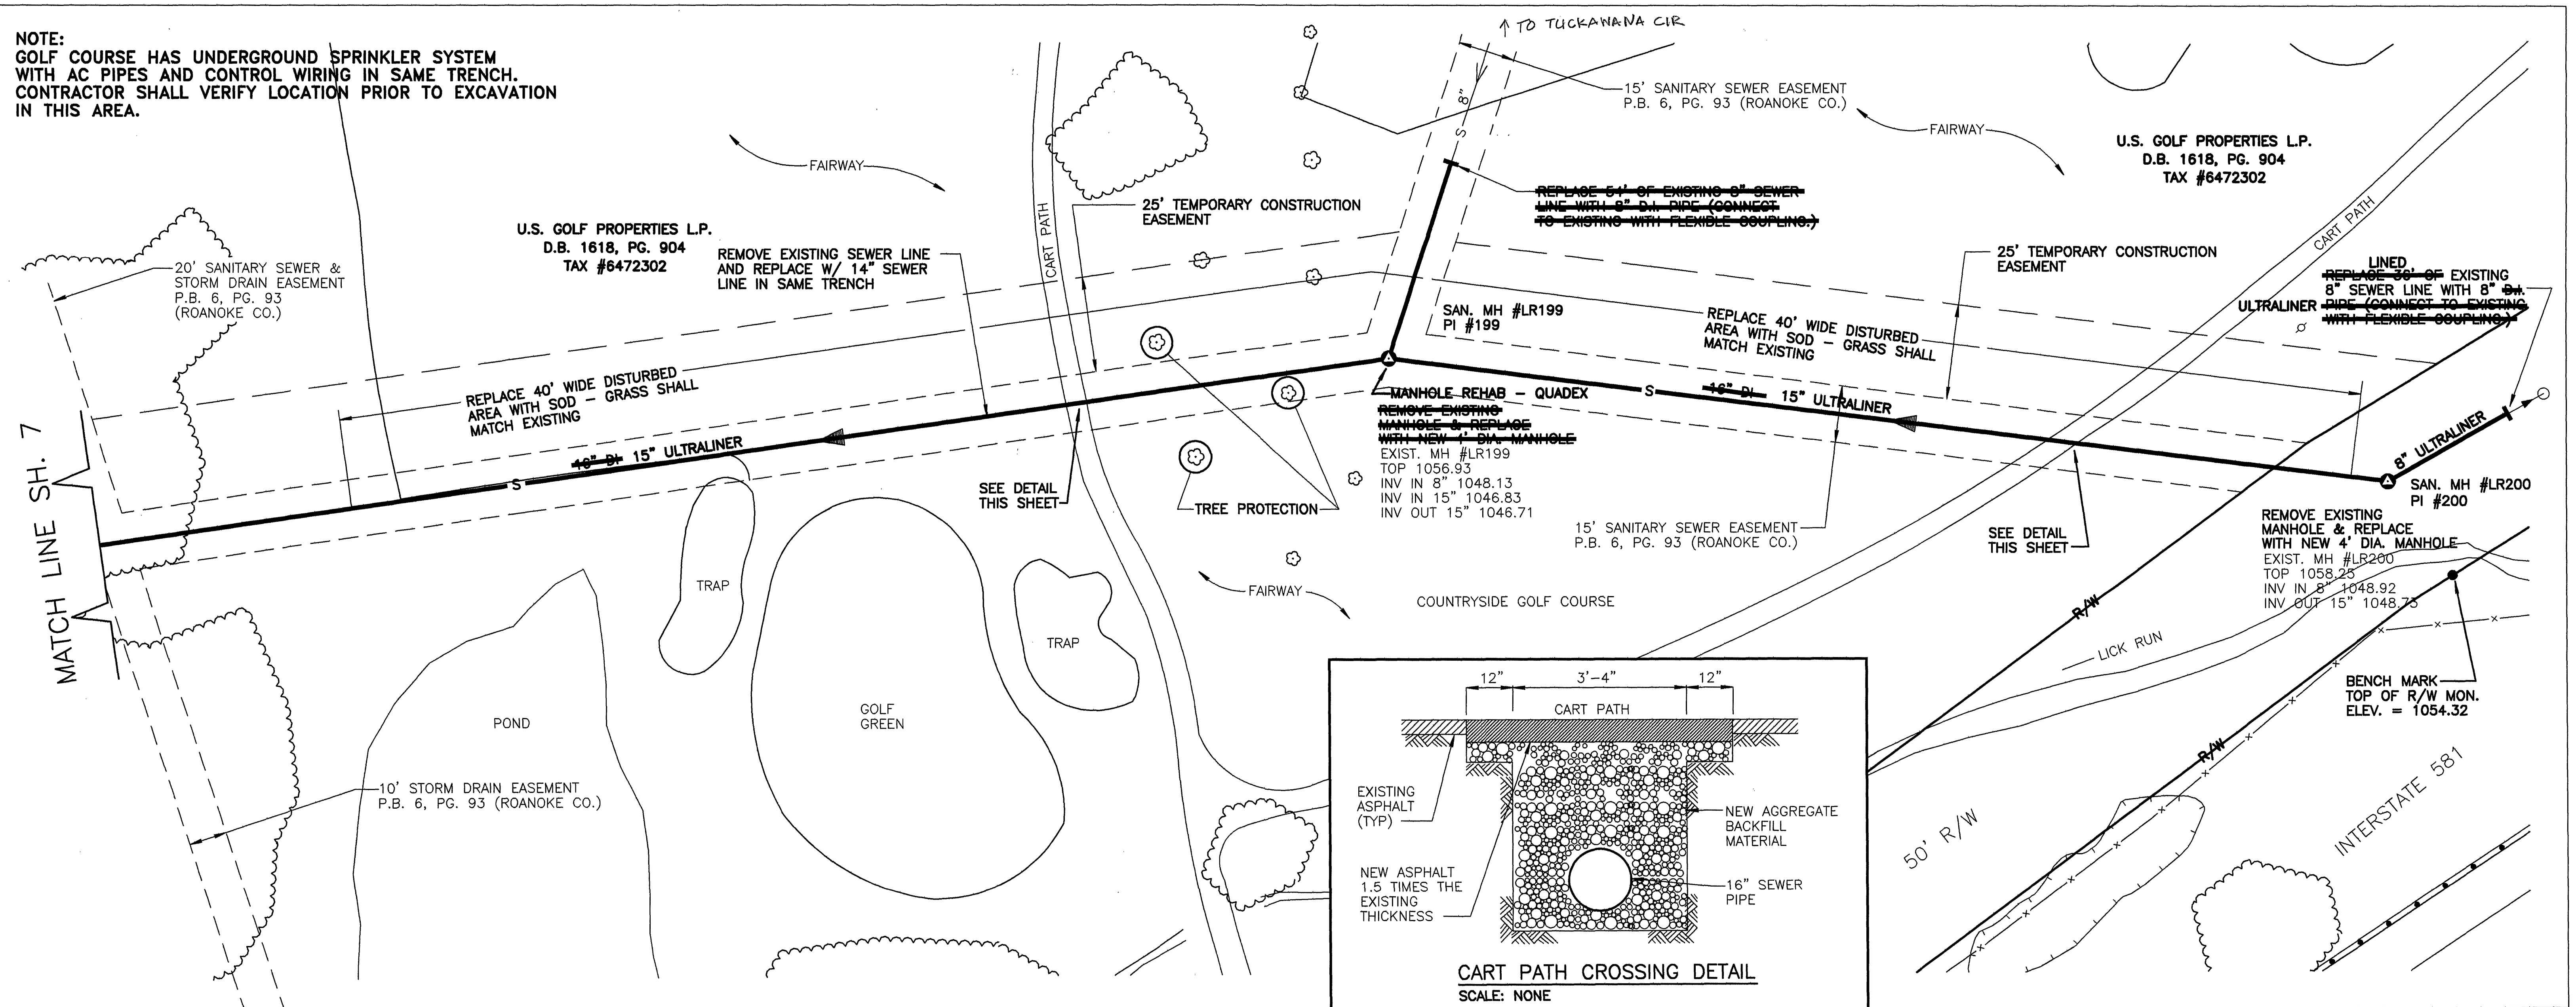

 Mattern & Craig CONSULTING ENGINEERS - SURVEYORS	DESIGNED: TAM			REV.	DATE	DESCRIPTION	BY	APP.	DATE JANUARY 1994 COMM. NO. 1245F	LICK RUN SANITARY SEWER REPLACEMENT PROJECT LR-2 PLAN & PROFILE CITY OF ROANOKE, VIRGINIA SCALE: 1"=20' HORIZ. 1"=10' VERT.	SHEET 8 PROJECT NO. 6245F
	DRAWN: SMM			1	9-96	ADDED TEMPORARY CONSTRUCTION EASEMENT	TAM	SWH			
	CHECKED: SWH			2	7-97	RECORD DRAWINGS	MRL	SWH			