
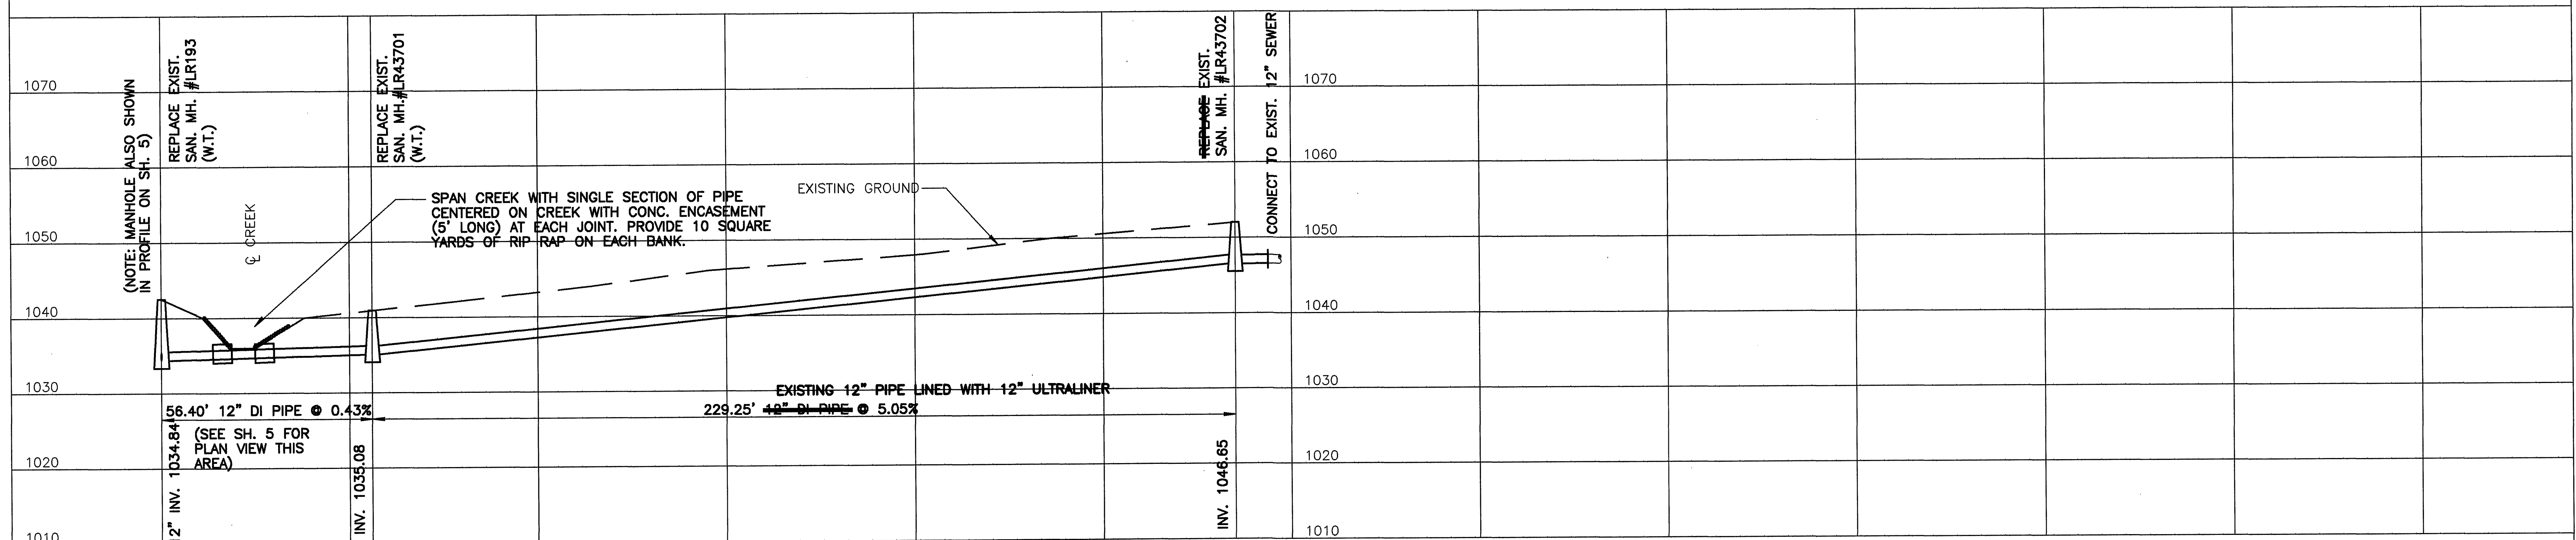


REPEATED FROM SH.5

MAURY L. & SHEILA S. STRAUSS
D.B. 1410, PG. 615
TAX #6460101



REPEATED FROM SH.5

REPEATED FROM SH.5

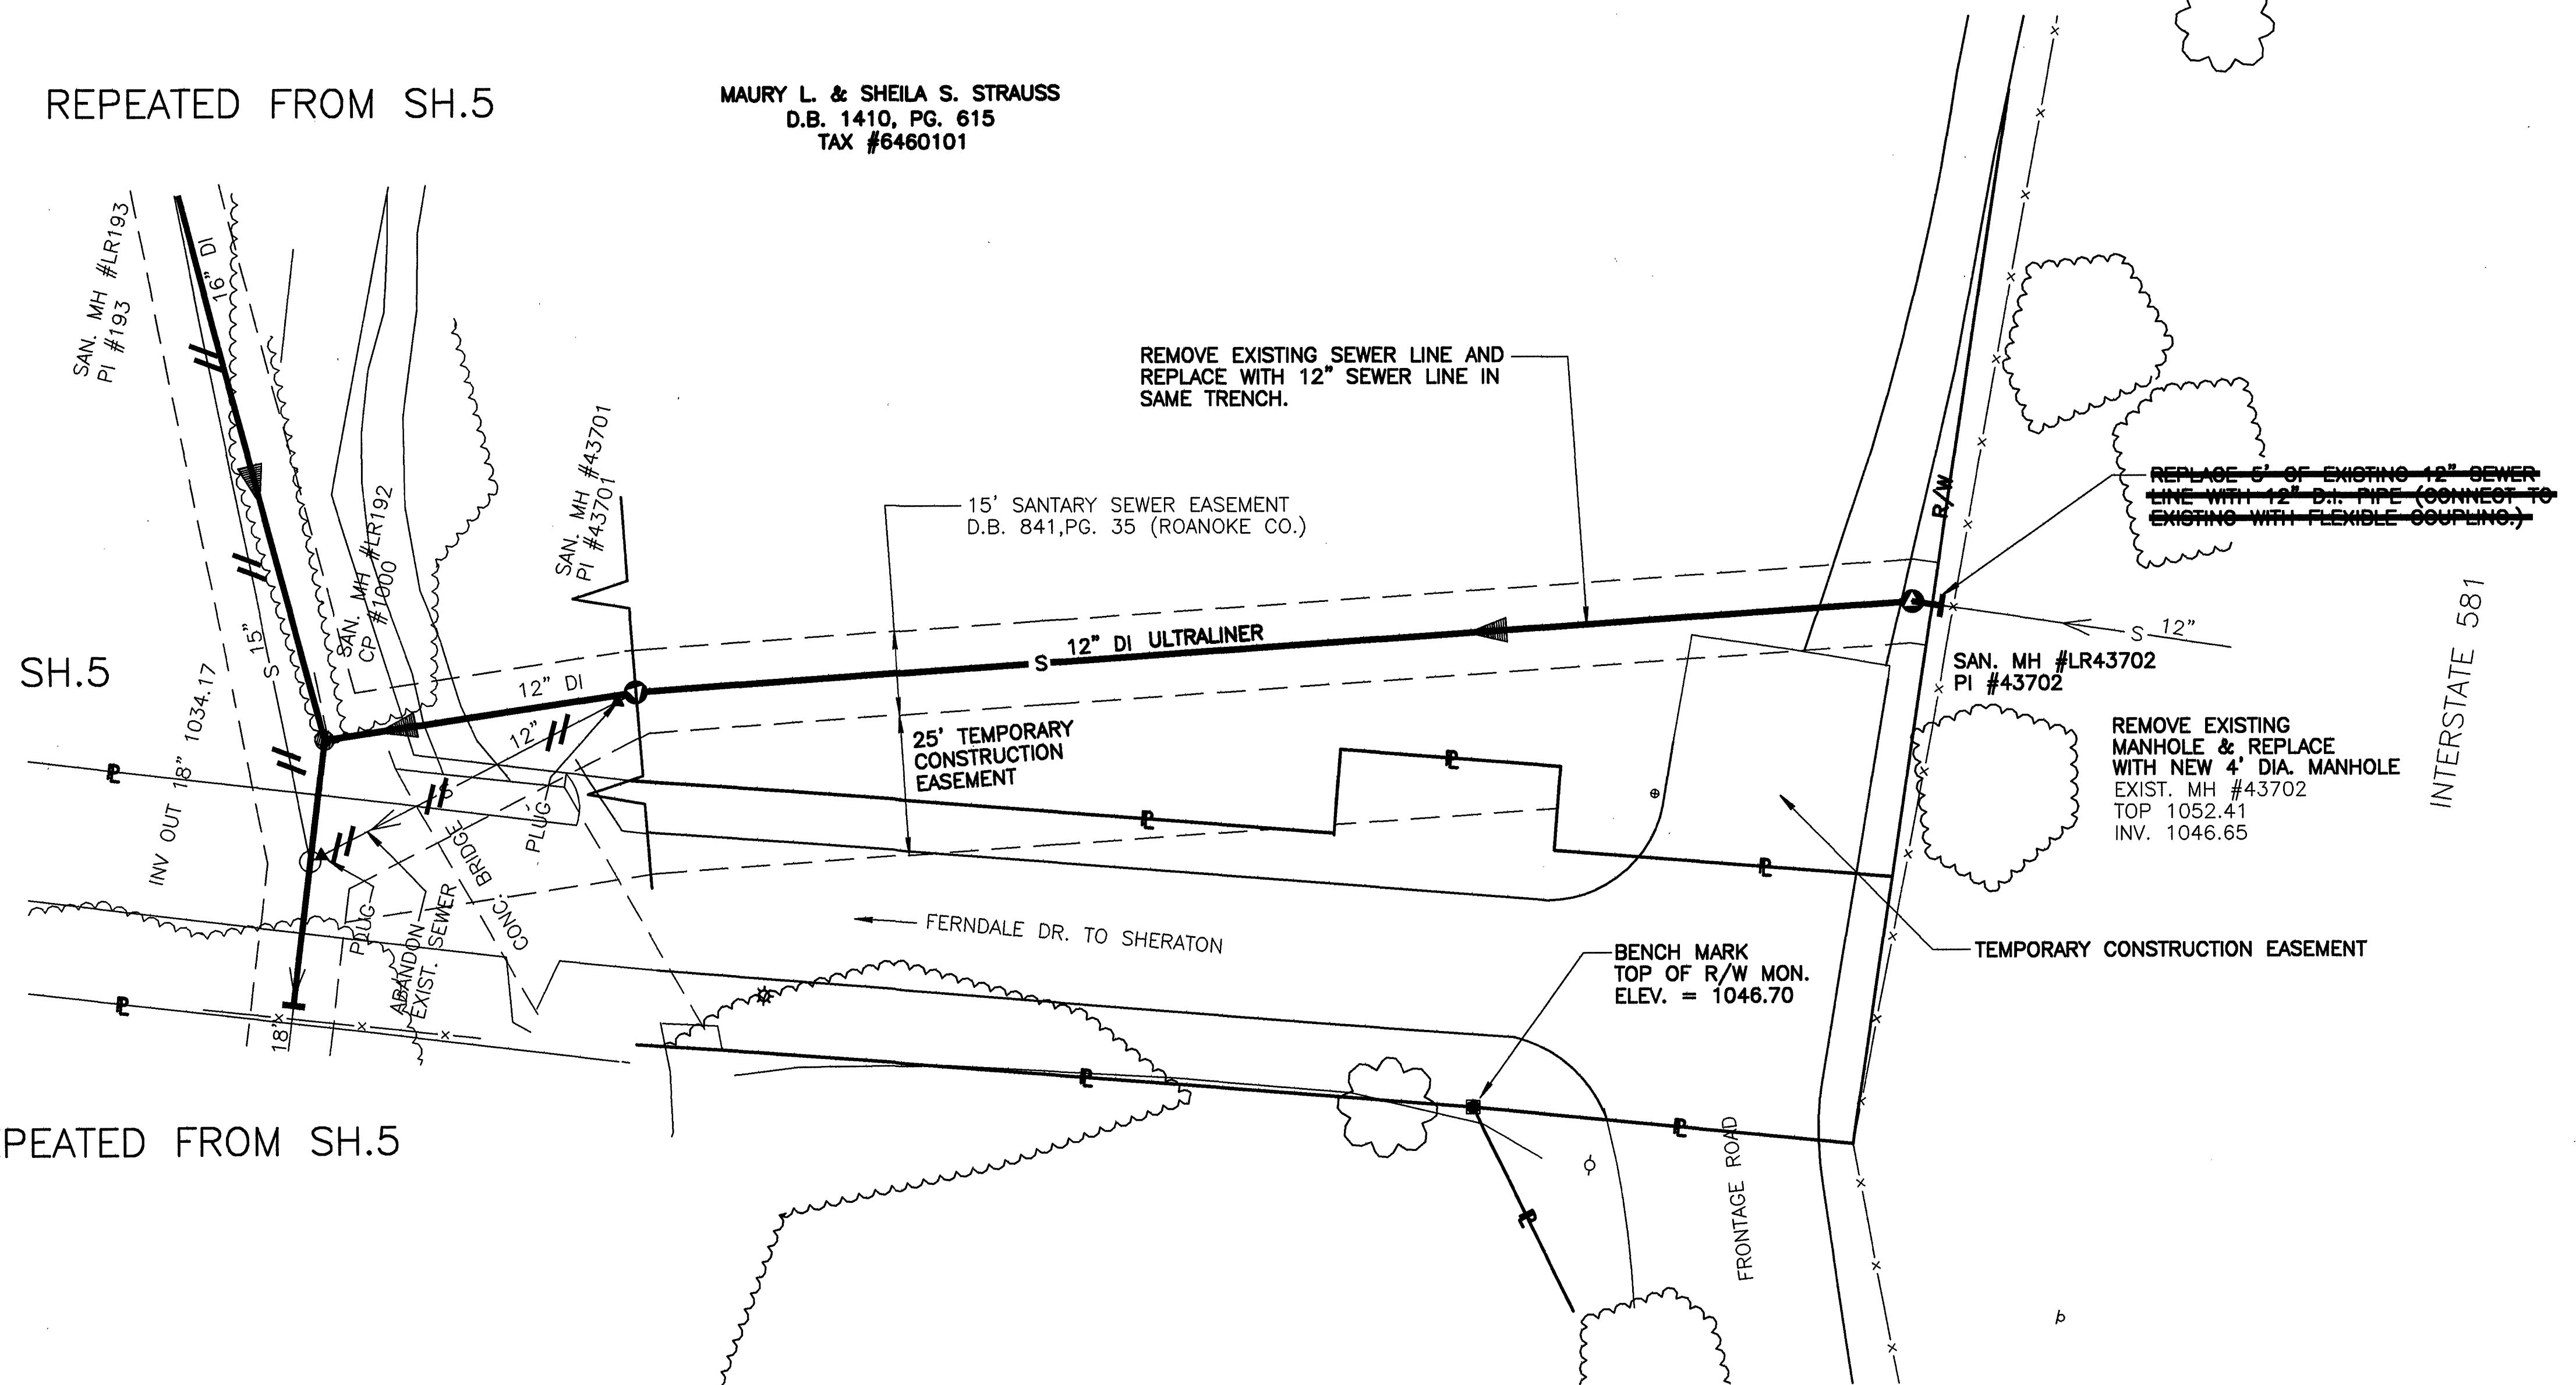

Mattern & Craig
CONSULTING ENGINEERS - SURVEYORS

DESIGNED: TAM
DRAWN: SMM
CHECKED: SWH

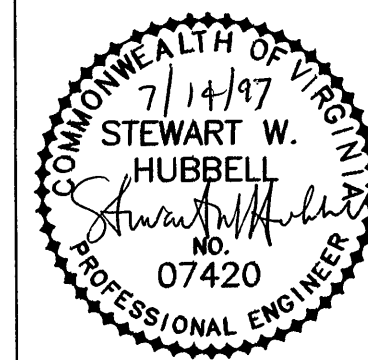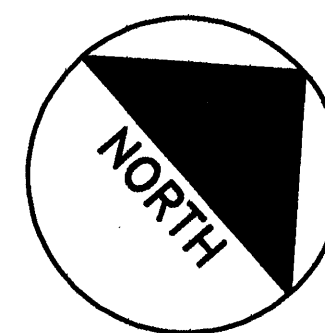

REV.	DATE	DESCRIPTION	BY	APP.
1	9-96	ADDED TEMPORARY CONSTRUCTION EASEMENT	TAM	SWH
2	7-97	RECORD DRAWINGS	MRL	SWH

DATE
JANUARY
1994
COMM. NO.
1245F

LICK RUN SANITARY SEWER REPLACEMENT
PROJECT LR-2
PLAN & PROFILE
CITY OF ROANOKE, VIRGINIA
SCALE: 1"=20' HORIZ.
1"=10' VERT.
SHEET
9